


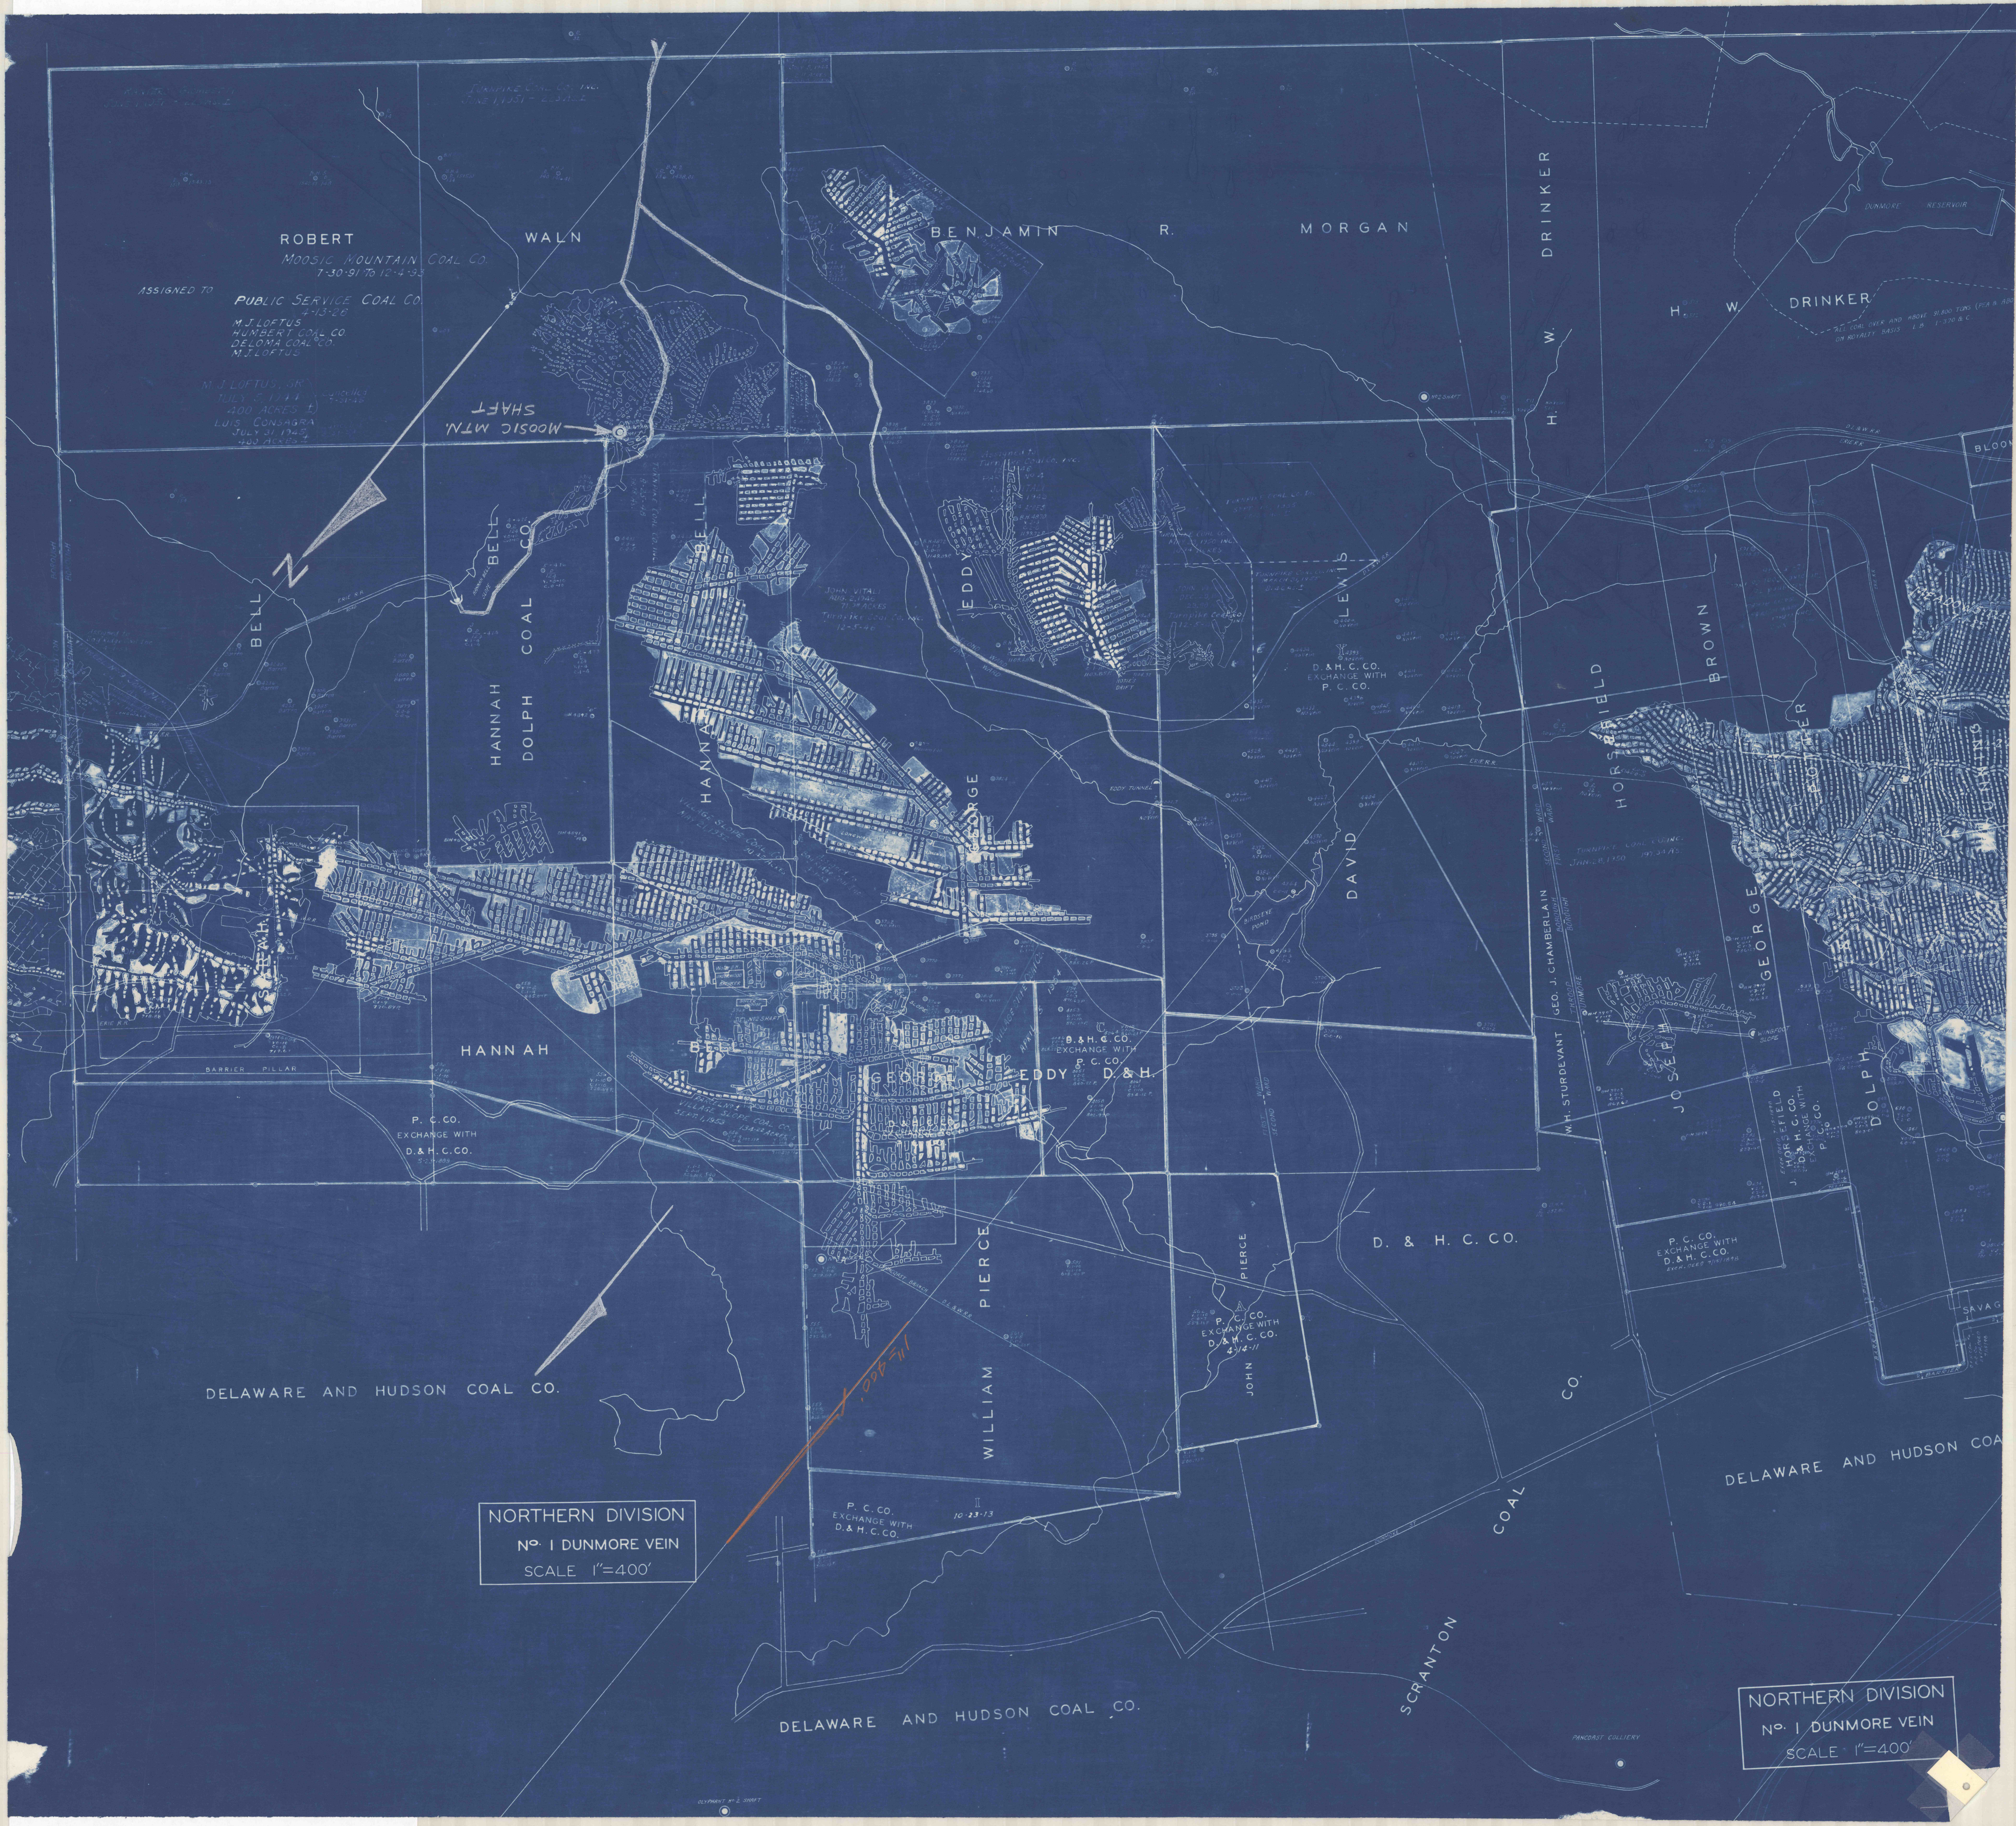

ROBERT
MOOSIC MOUNTAIN COAL CO.
7-30-91 TO 12-4-93

ASSIGNED TO
PUBLIC SERVICE COAL CO.
4-13-26
M. J. LOFTUS
HUMBERT COAL CO.
DELOMA COAL CO.
M. J. LOFTUS

M. J. LOFTUS, JR.
JULY 5, 1914
400 ACRES
LUIS CONAGRA
JULY 31, 1925
400 ACRES

MOOSIC MTN.
SHAFT

BELL
HANNAH
DOLPH COAL CO.

HANNAH

P. C. CO.
EXCHANGE WITH
D. & H. C. CO.
5-2-1906

DELAWARE AND HUDSON COAL CO.

NORTHERN DIVISION
No. 1 DUNMORE VEIN
SCALE 1"=400'

BENJAMIN R. MORGAN

EDDY

LEWIS

DAVID

D. & H. C. CO.

WILLIAM
PIERCE

PIERCE
JOHN

P. C. CO.
EXCHANGE WITH
D. & H. C. CO.
10-23-13

DELAWARE AND HUDSON COAL CO.

H. W. DRINKER

H. W. DRINKER

HORSTFIELD
BROWN

GEORGE

JOSEPH

P. C. CO.
EXCHANGE WITH
D. & H. C. CO.

DELAWARE AND HUDSON COAL CO.

NORTHERN DIVISION
No. 1 DUNMORE VEIN
SCALE 1"=400'