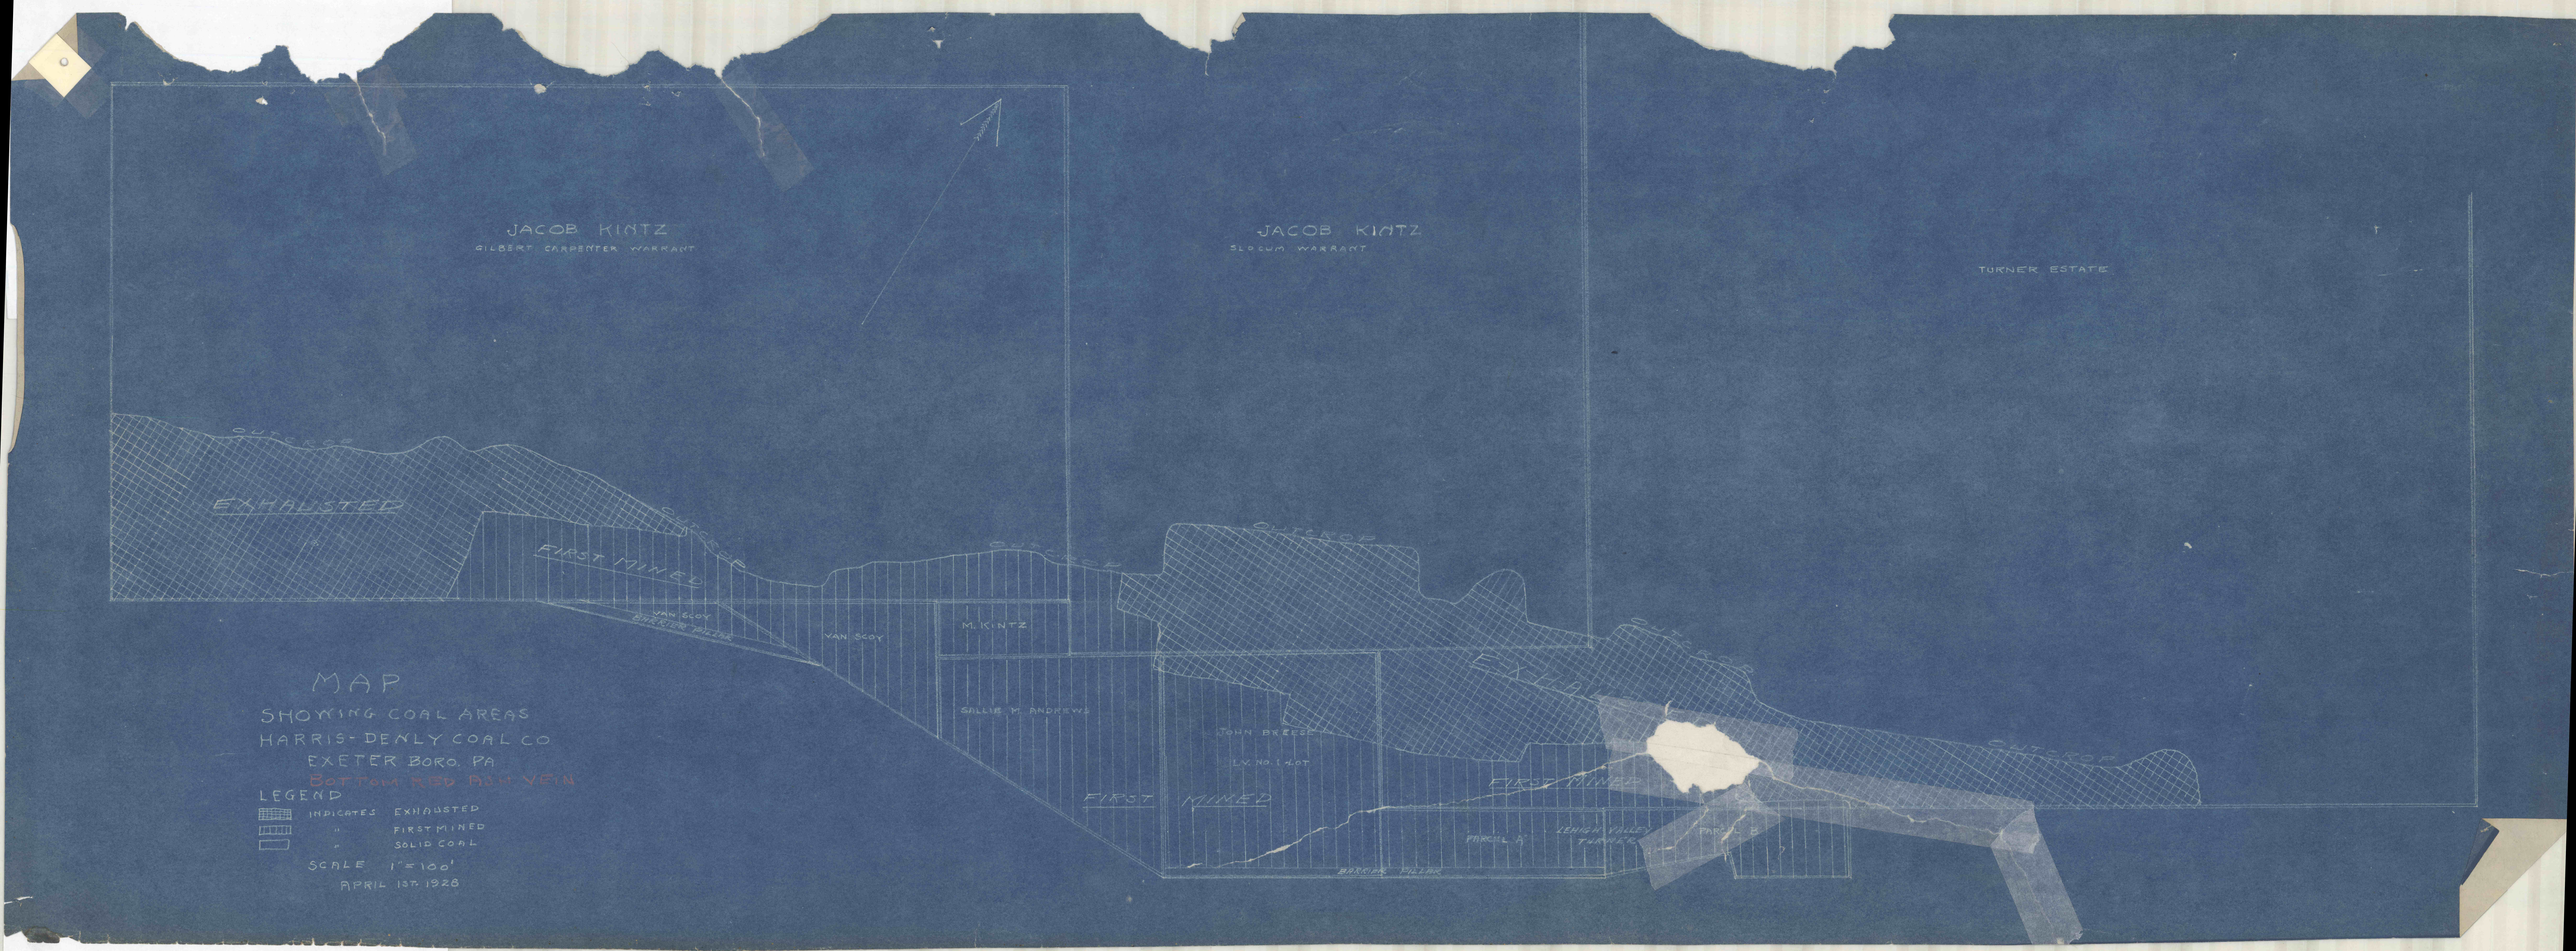
JACOB KINTZ
GILBERT CARPENTER WARRANT
JACOB KINTZ
SLOCUM WARRANT
TURNER ESTATE
EXHAUSTED
FIRST MINED
VAN SCOY
BARRIER PILLAR
VAN SCOY
M. KINTZ
SALLIE M. ANDREWS
JOHN BREESE
L.V. NO. 1 LOT
FIRST MINED
FIRST MINED
PARCEL A
LEHIGH VALLEY PARCEL
PARCEL B
BARRIER PILLAR
MAP
SHOWING COAL AREAS
HARRIS-DENLY COAL CO
EXETER BORO. PA
BOTTOM RED ASH VEIN
LEGEND
INDICATES EXHAUSTED
" FIRST MINED
" SOLID COAL
SCALE 1" = 100'
APRIL 13TH 1928