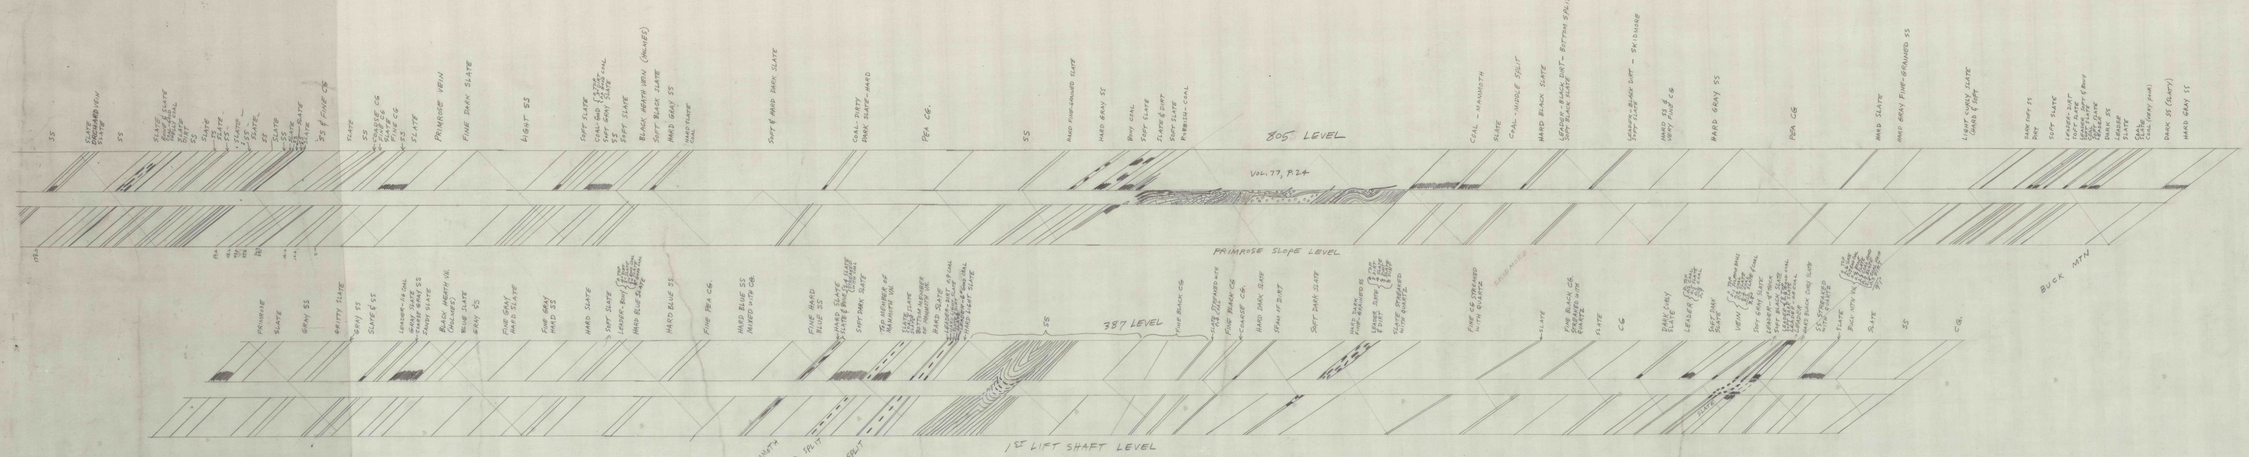

SECTIONS THROUGH TUNNELS AT MIDDLE CREEK COLLIERY

SCALE: 1" = 30' ——— LOOKING WEST

Tracing on Mylar (1"=30')
Sub SX-103
Mint SX-1020