


B.H. 152
6250 A

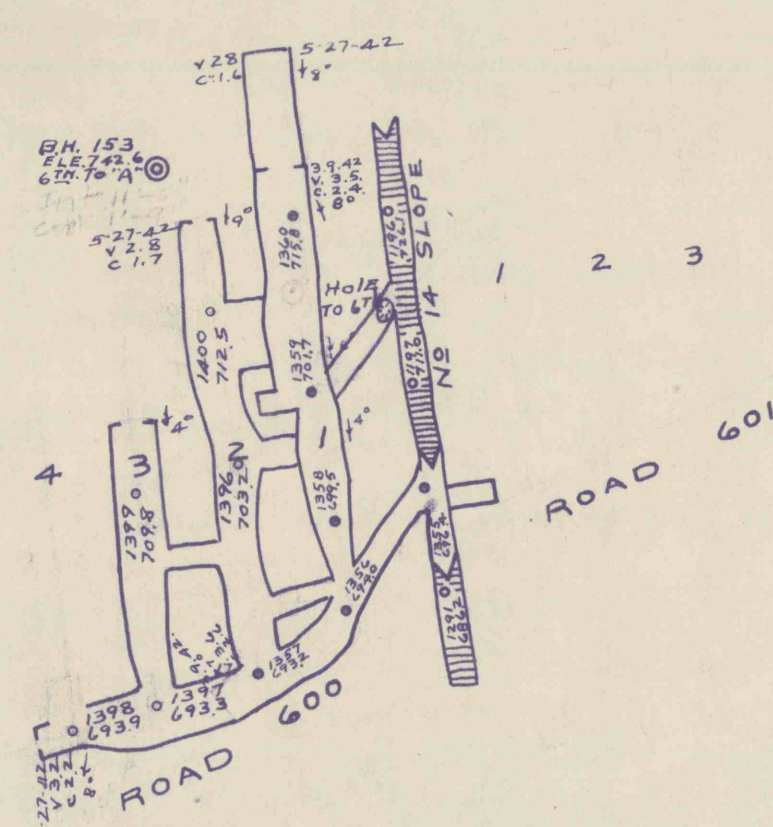

W 4500

W 4000

W 3500