


PARRISH COLLIERY WORKINGS

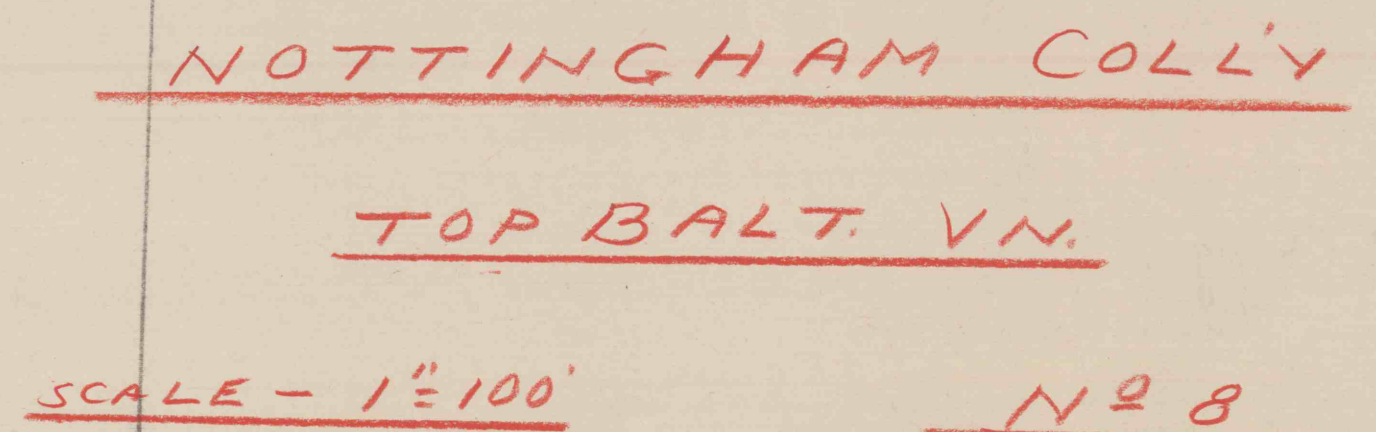

NOTTINGHAM COLLIERY TOP BALTIMORE VEIN
PARRISH COLLIERY WORKINGS