


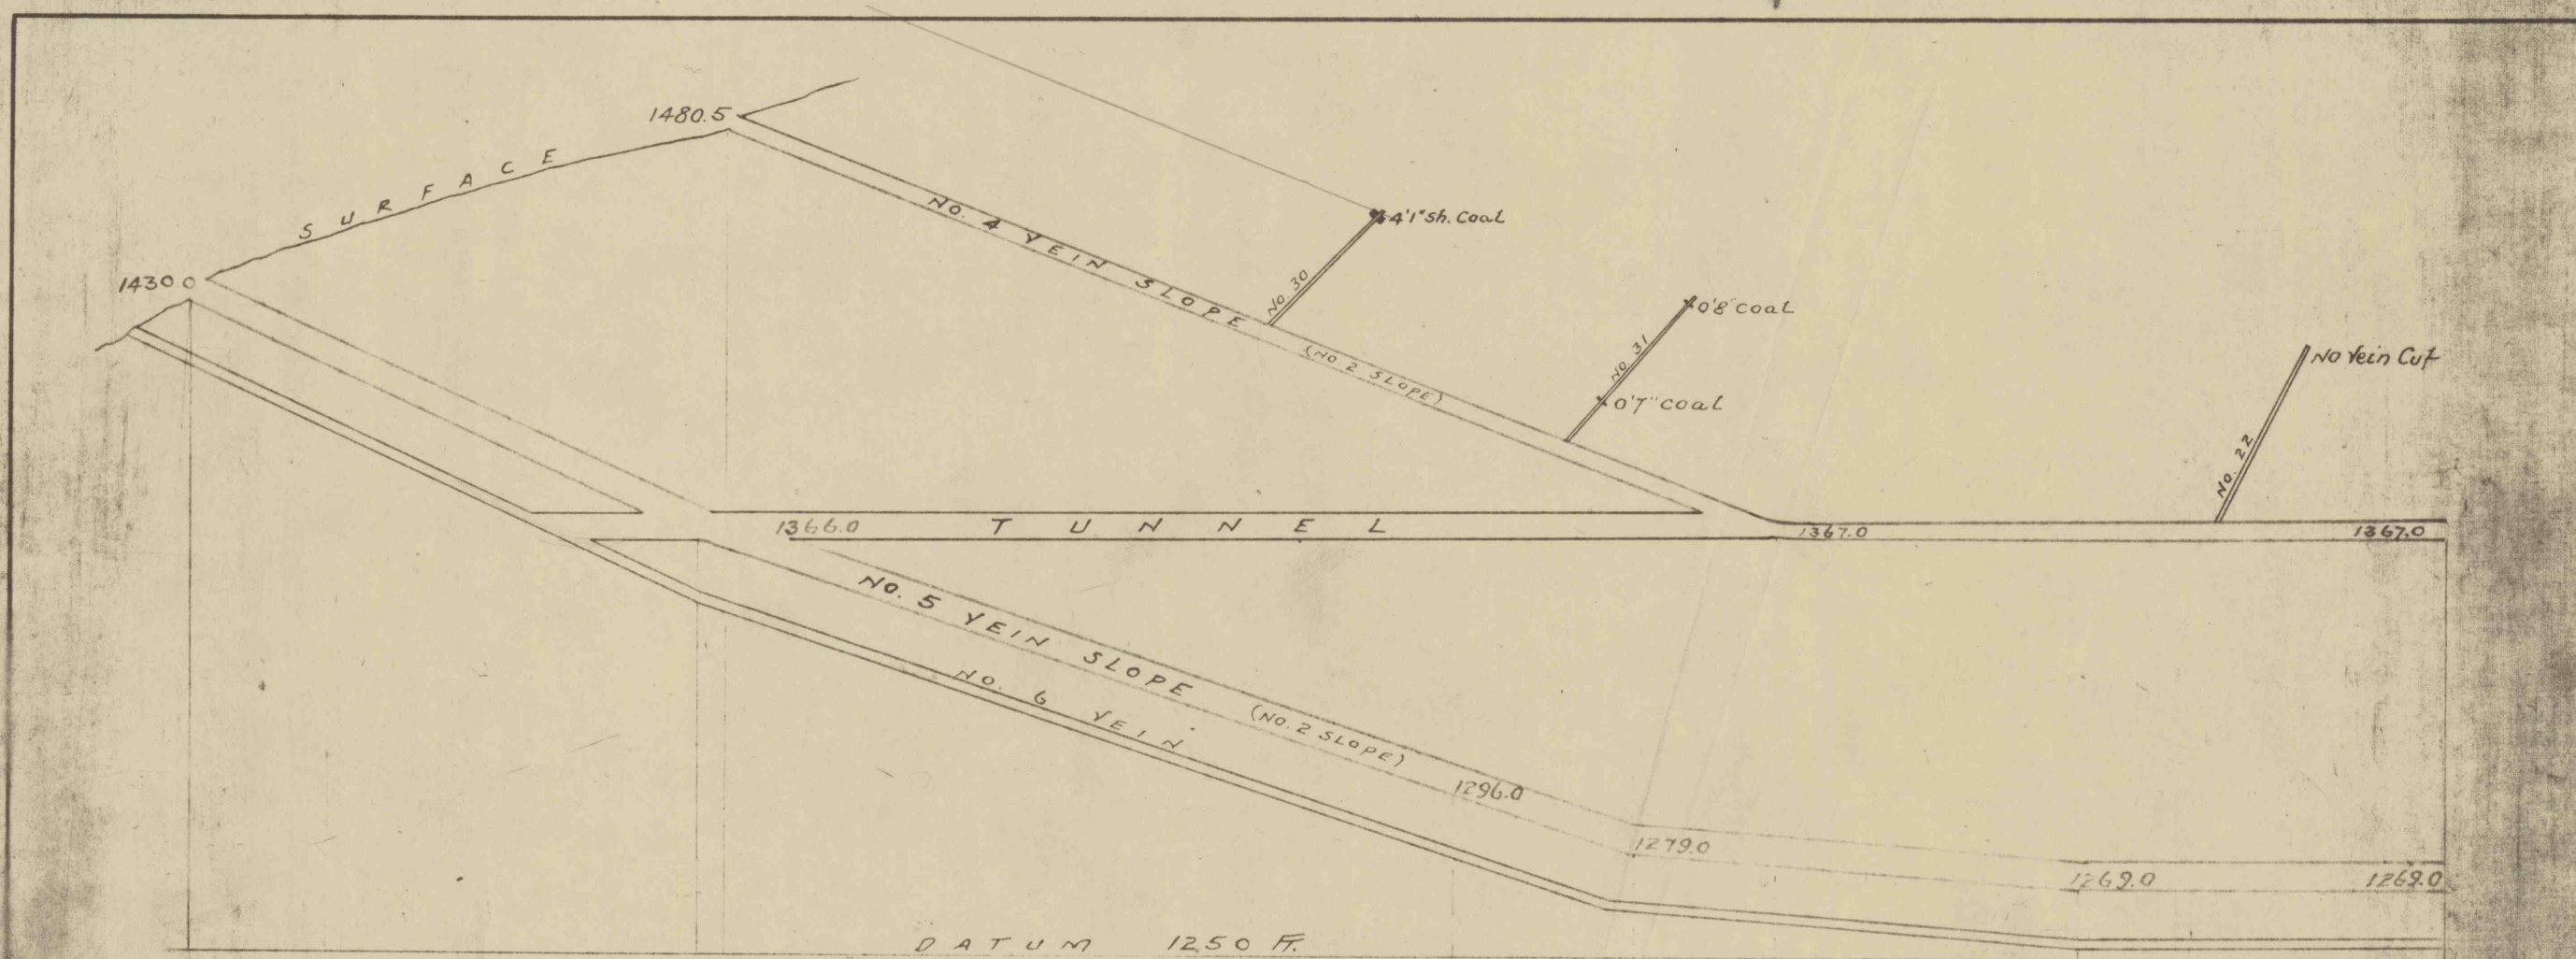

WEST BROOKSIDE COLLIERY - CROSS SECTION THROUGH NO. 2 SLOPE
 TREMONT, MAR. 22-1917
 SCALE 50' = 1"

WEST BROOKSIDE - CROSS SECTION THROUGH NO. 2 SLOPE