


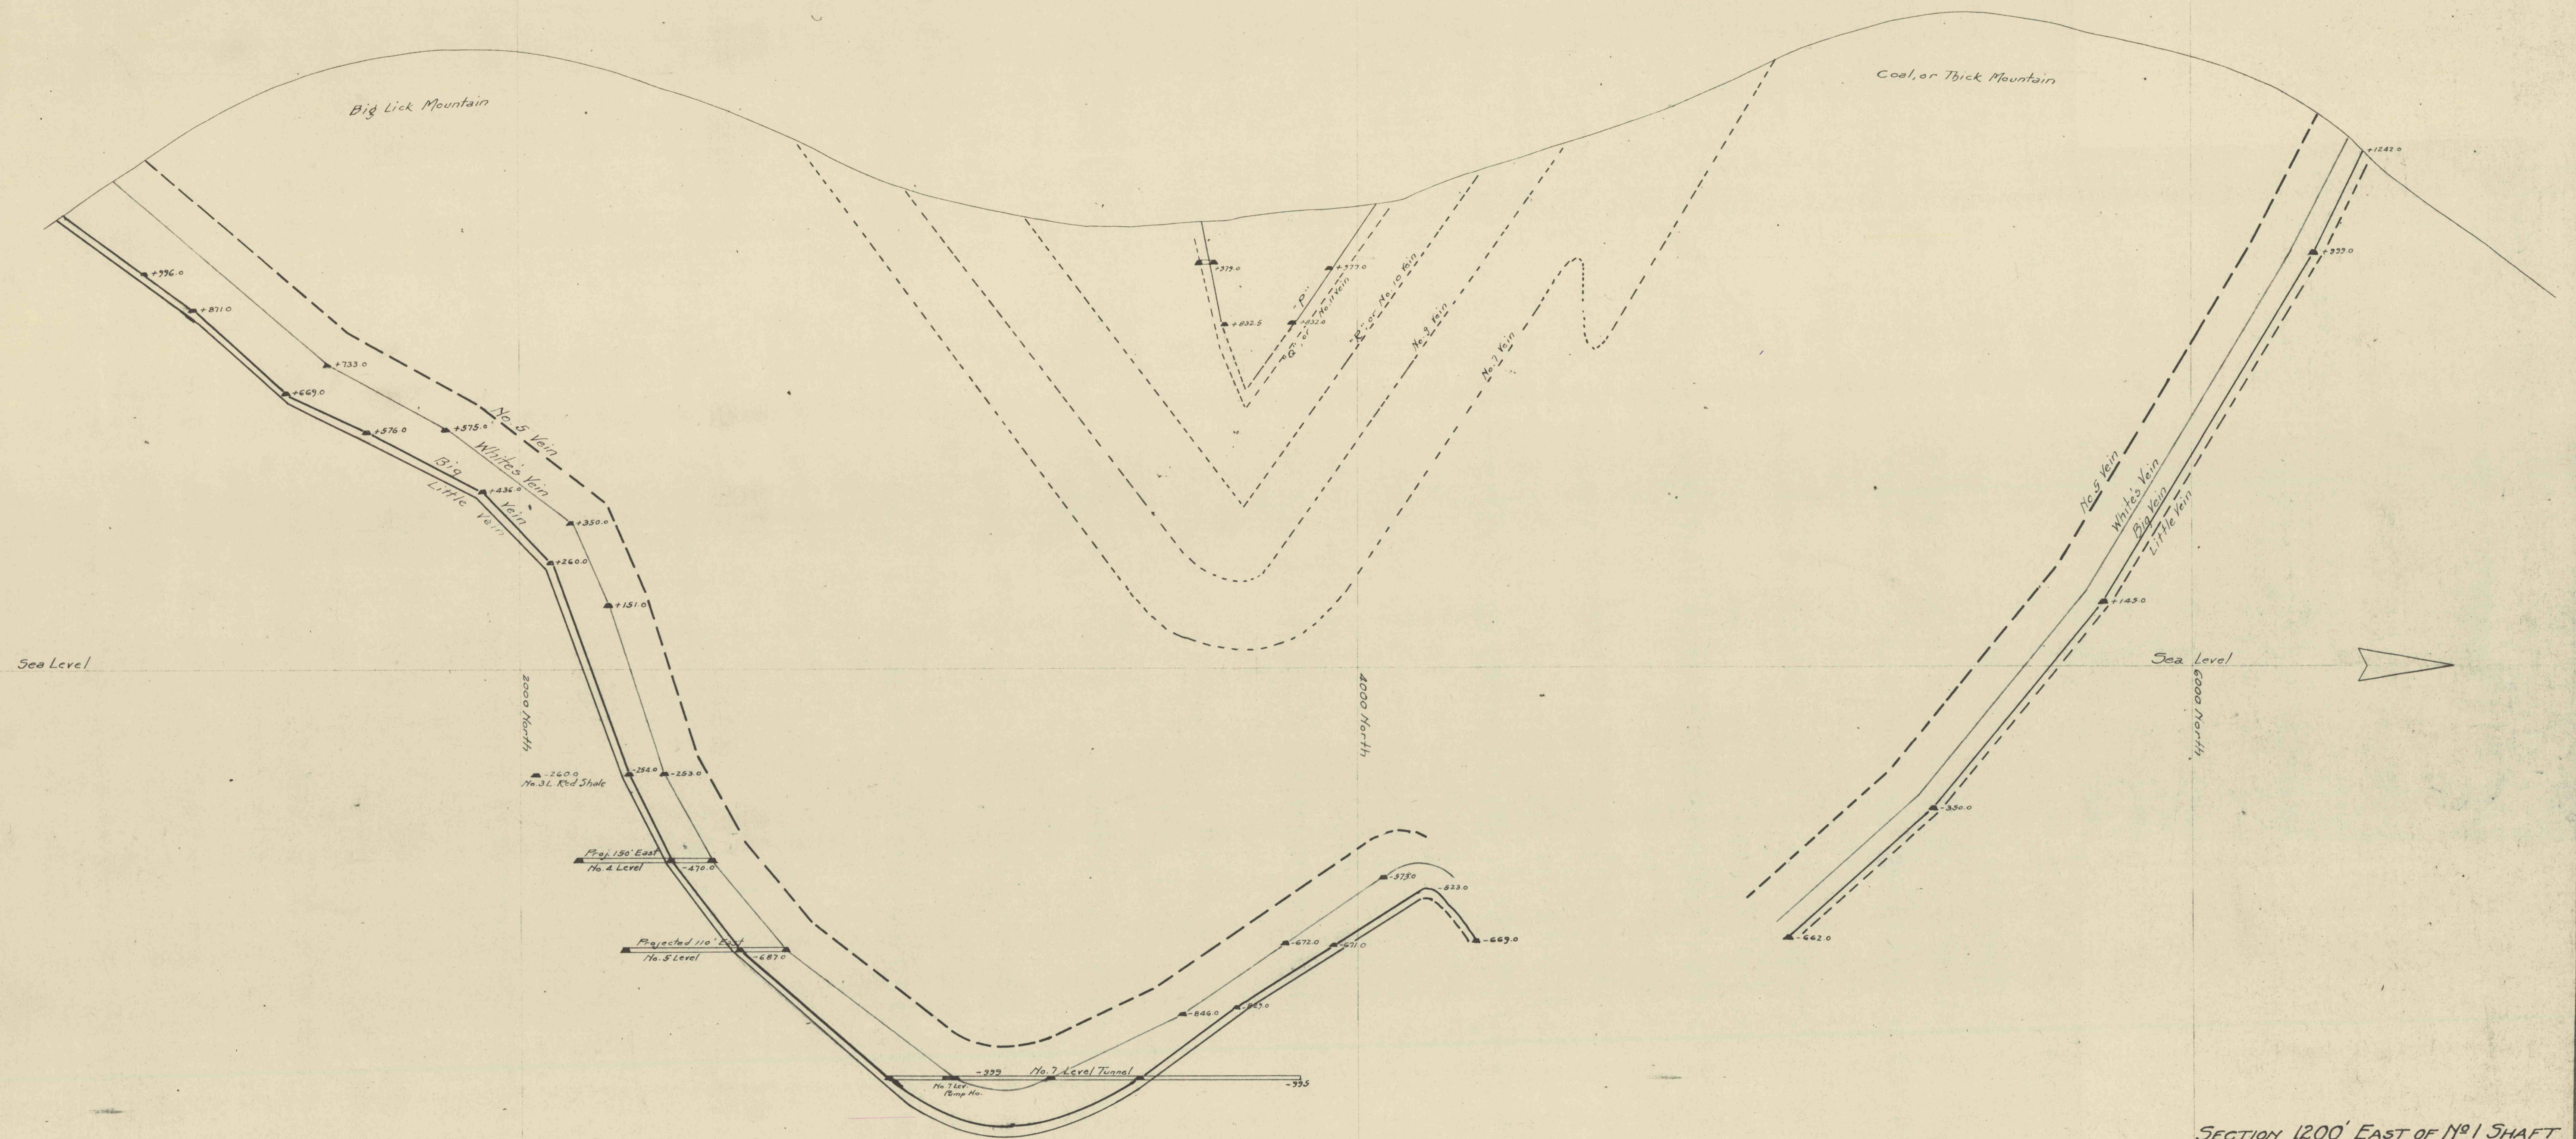

SECTION 1200' EAST OF NO. 1 SHAFT
 SHORT MOUNTAIN COLLIERY
 SUSQUEHANNA COLLIERIES CO. LYKENS, PA.
 SCALE 1"=200' 4/22/26 *John A. [Signature]*