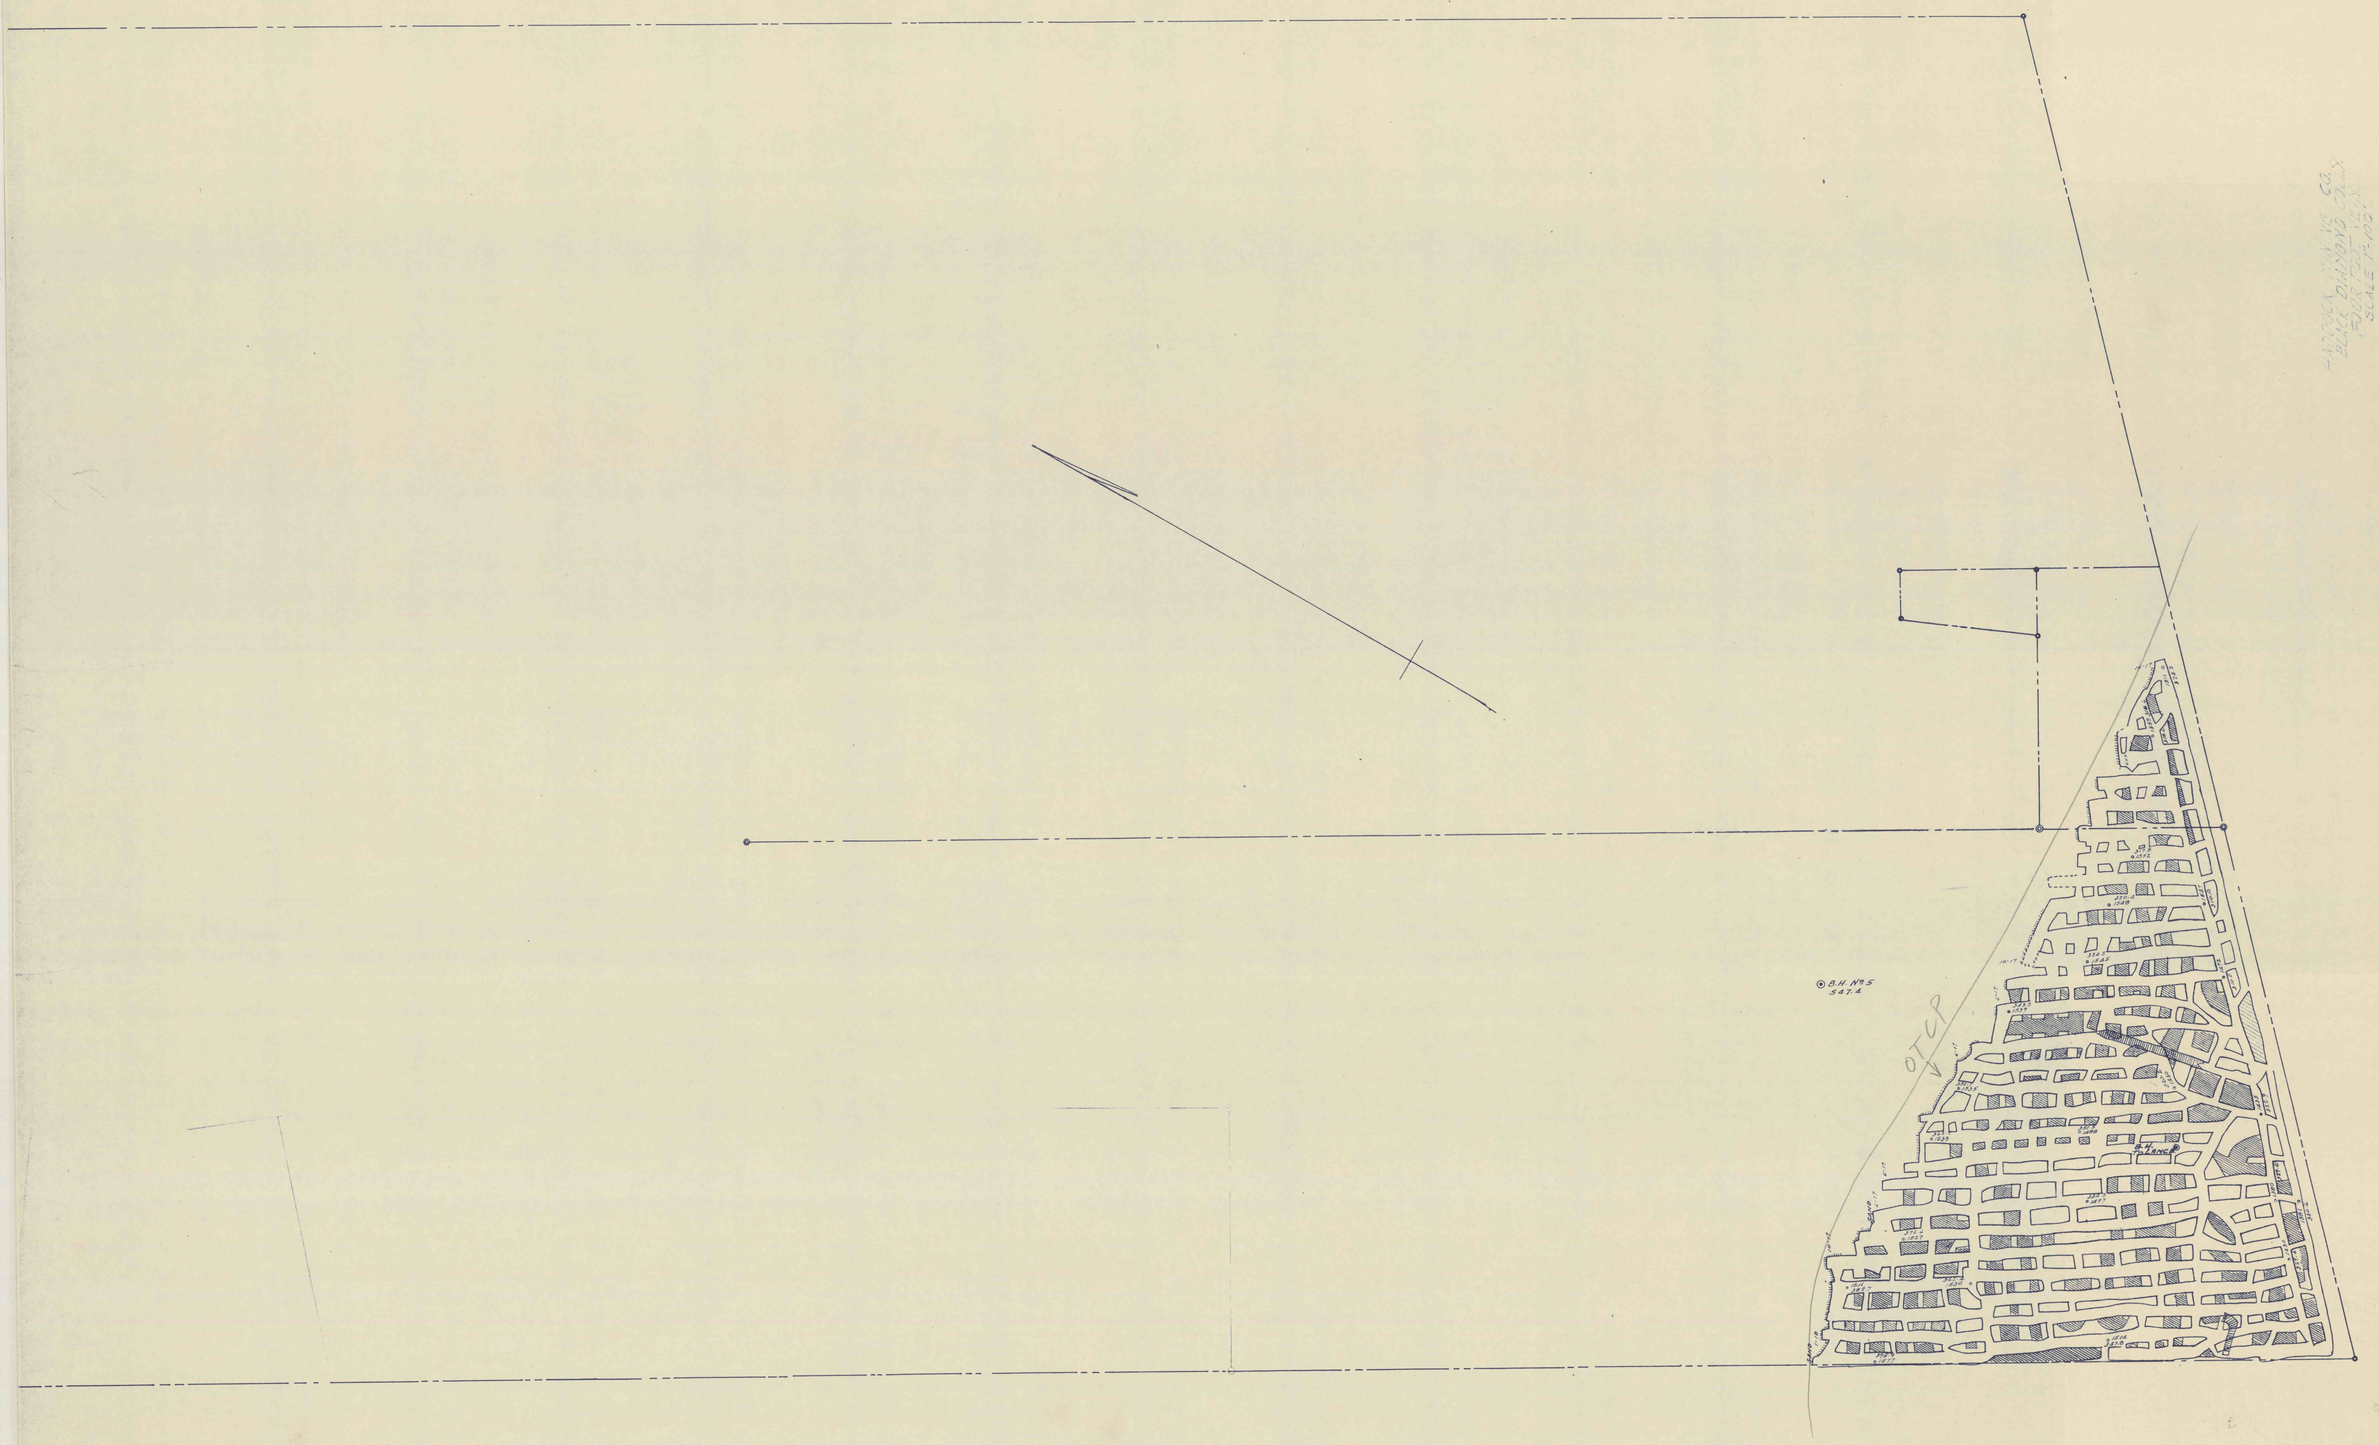


BLACK DIAMOND CHUTE
FOUR FOOT VEIN
SCALE 1" = 100'