


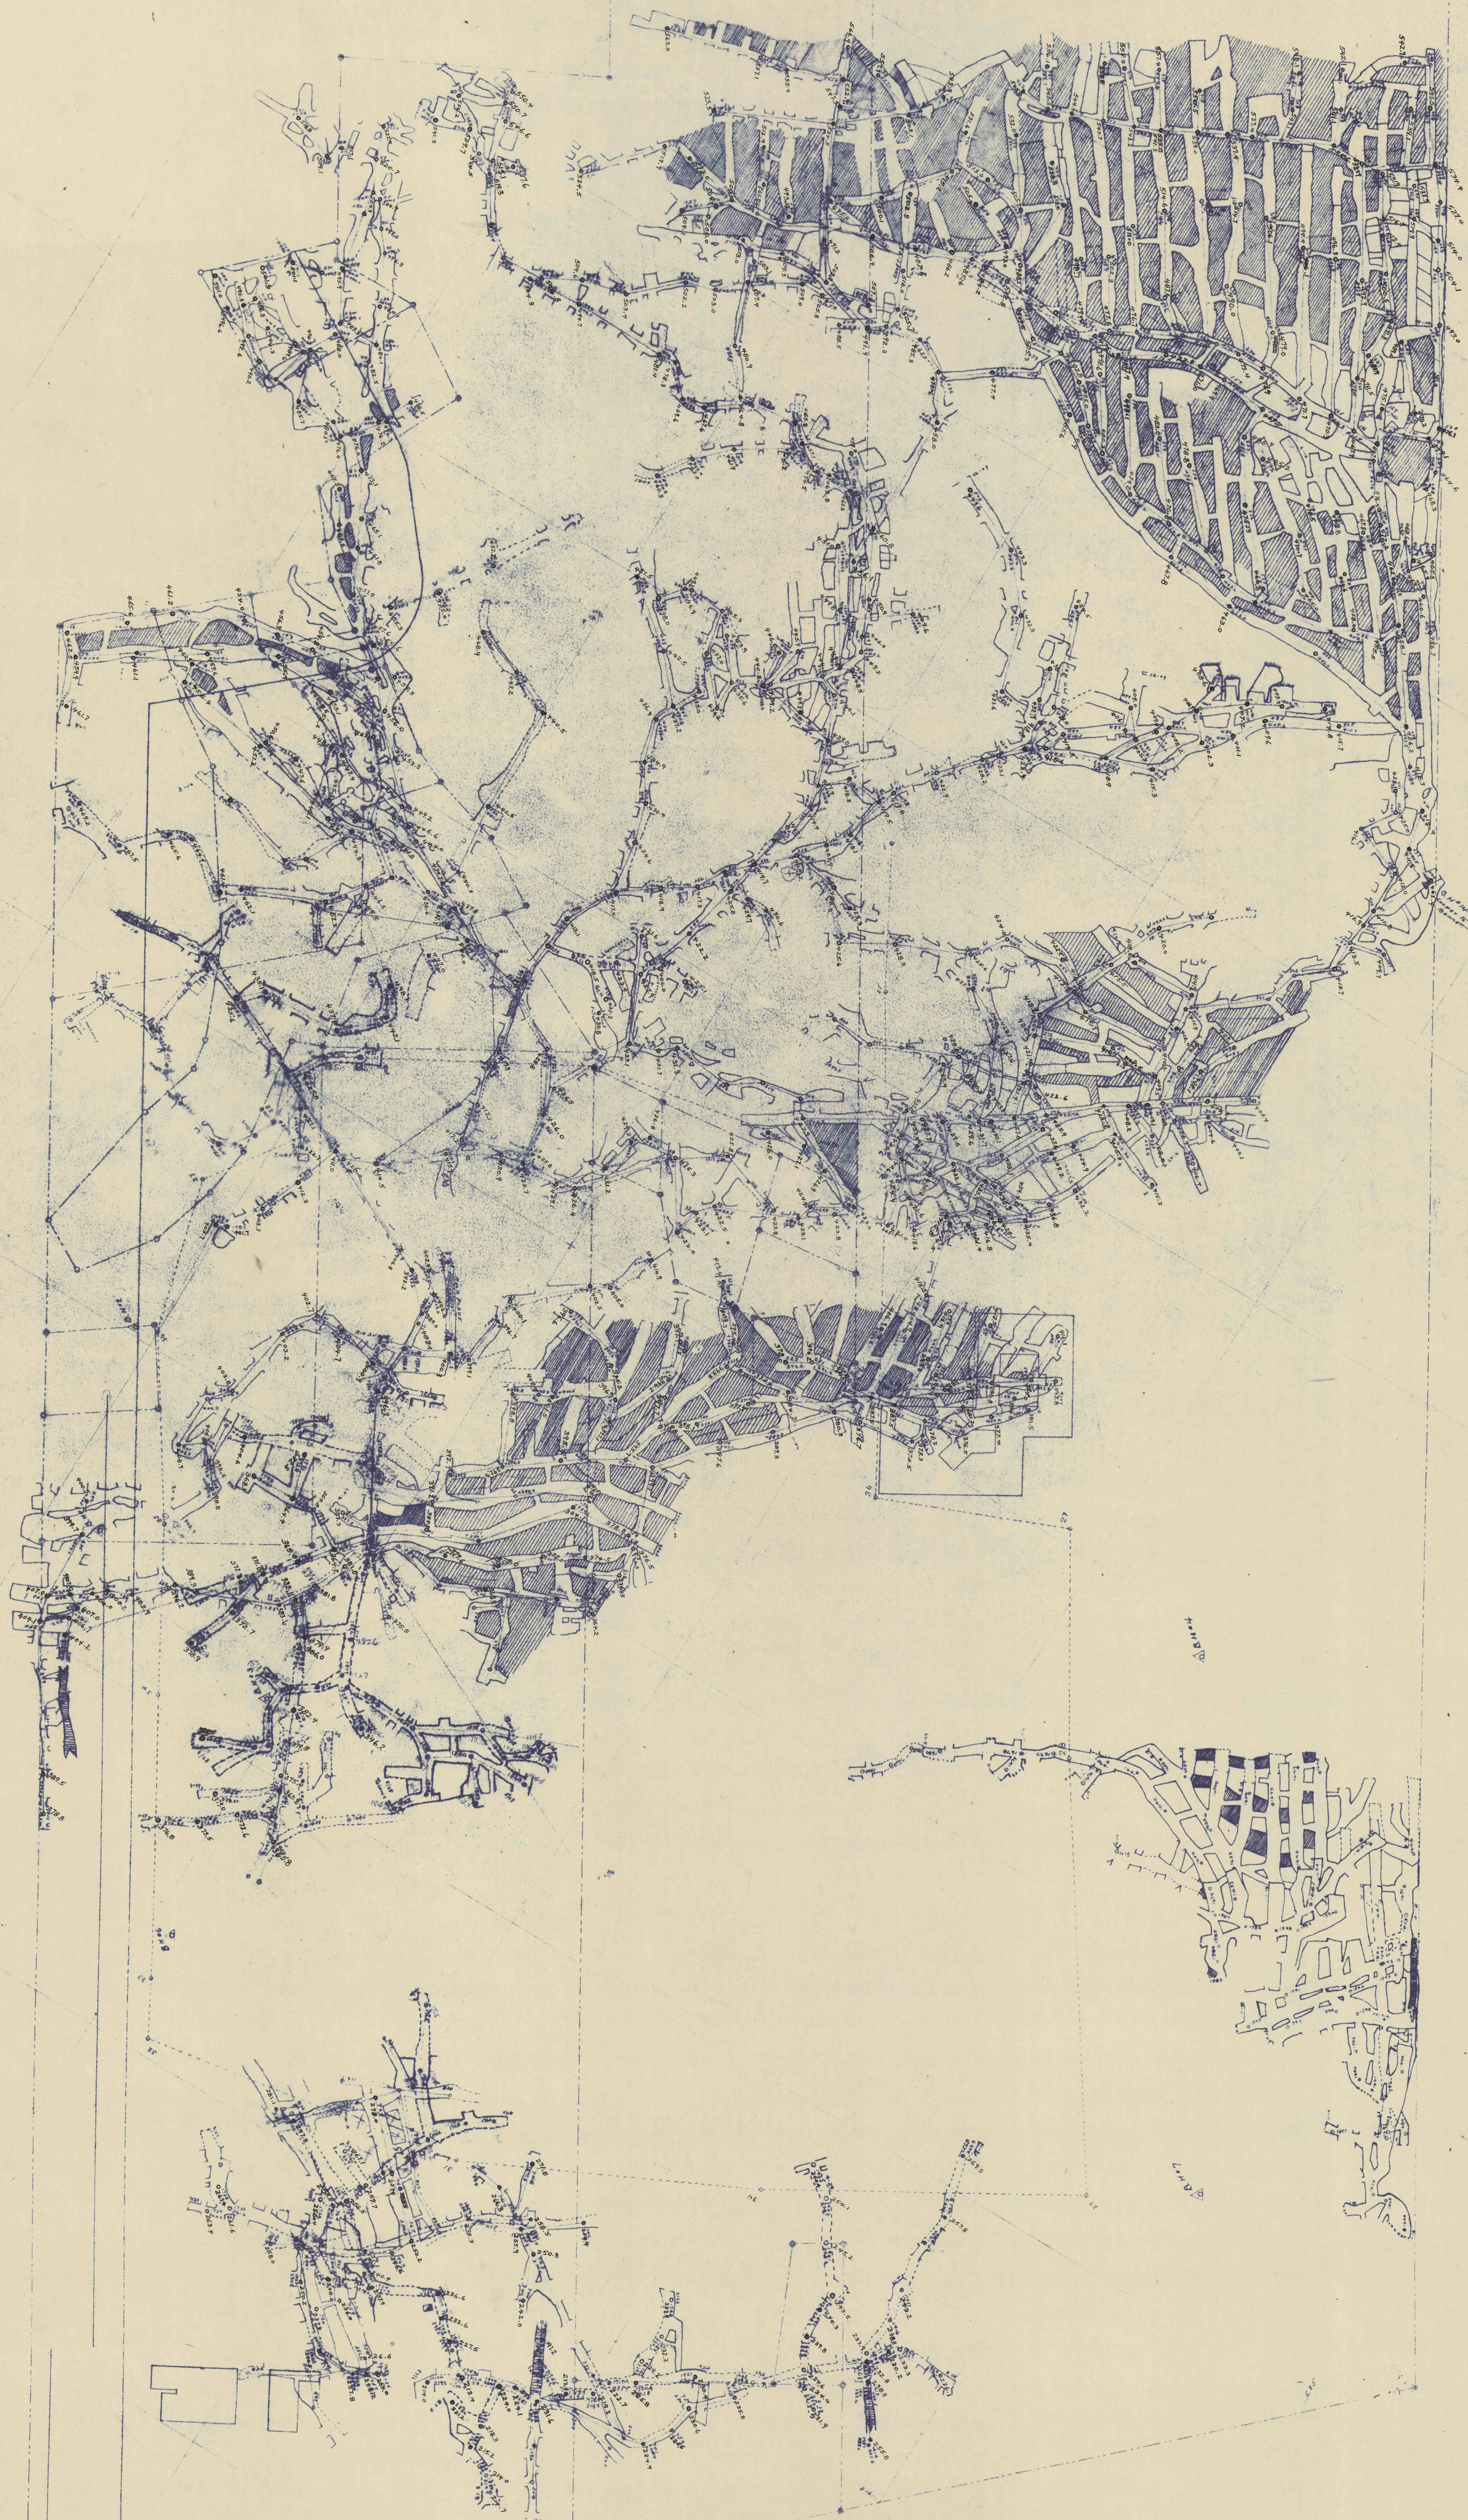

PLYMOUTH COAL CO'S.
BLACK DIAMOND COLLIERY
WORKINGS COOPER VEIN

Scale 100' to 1"