


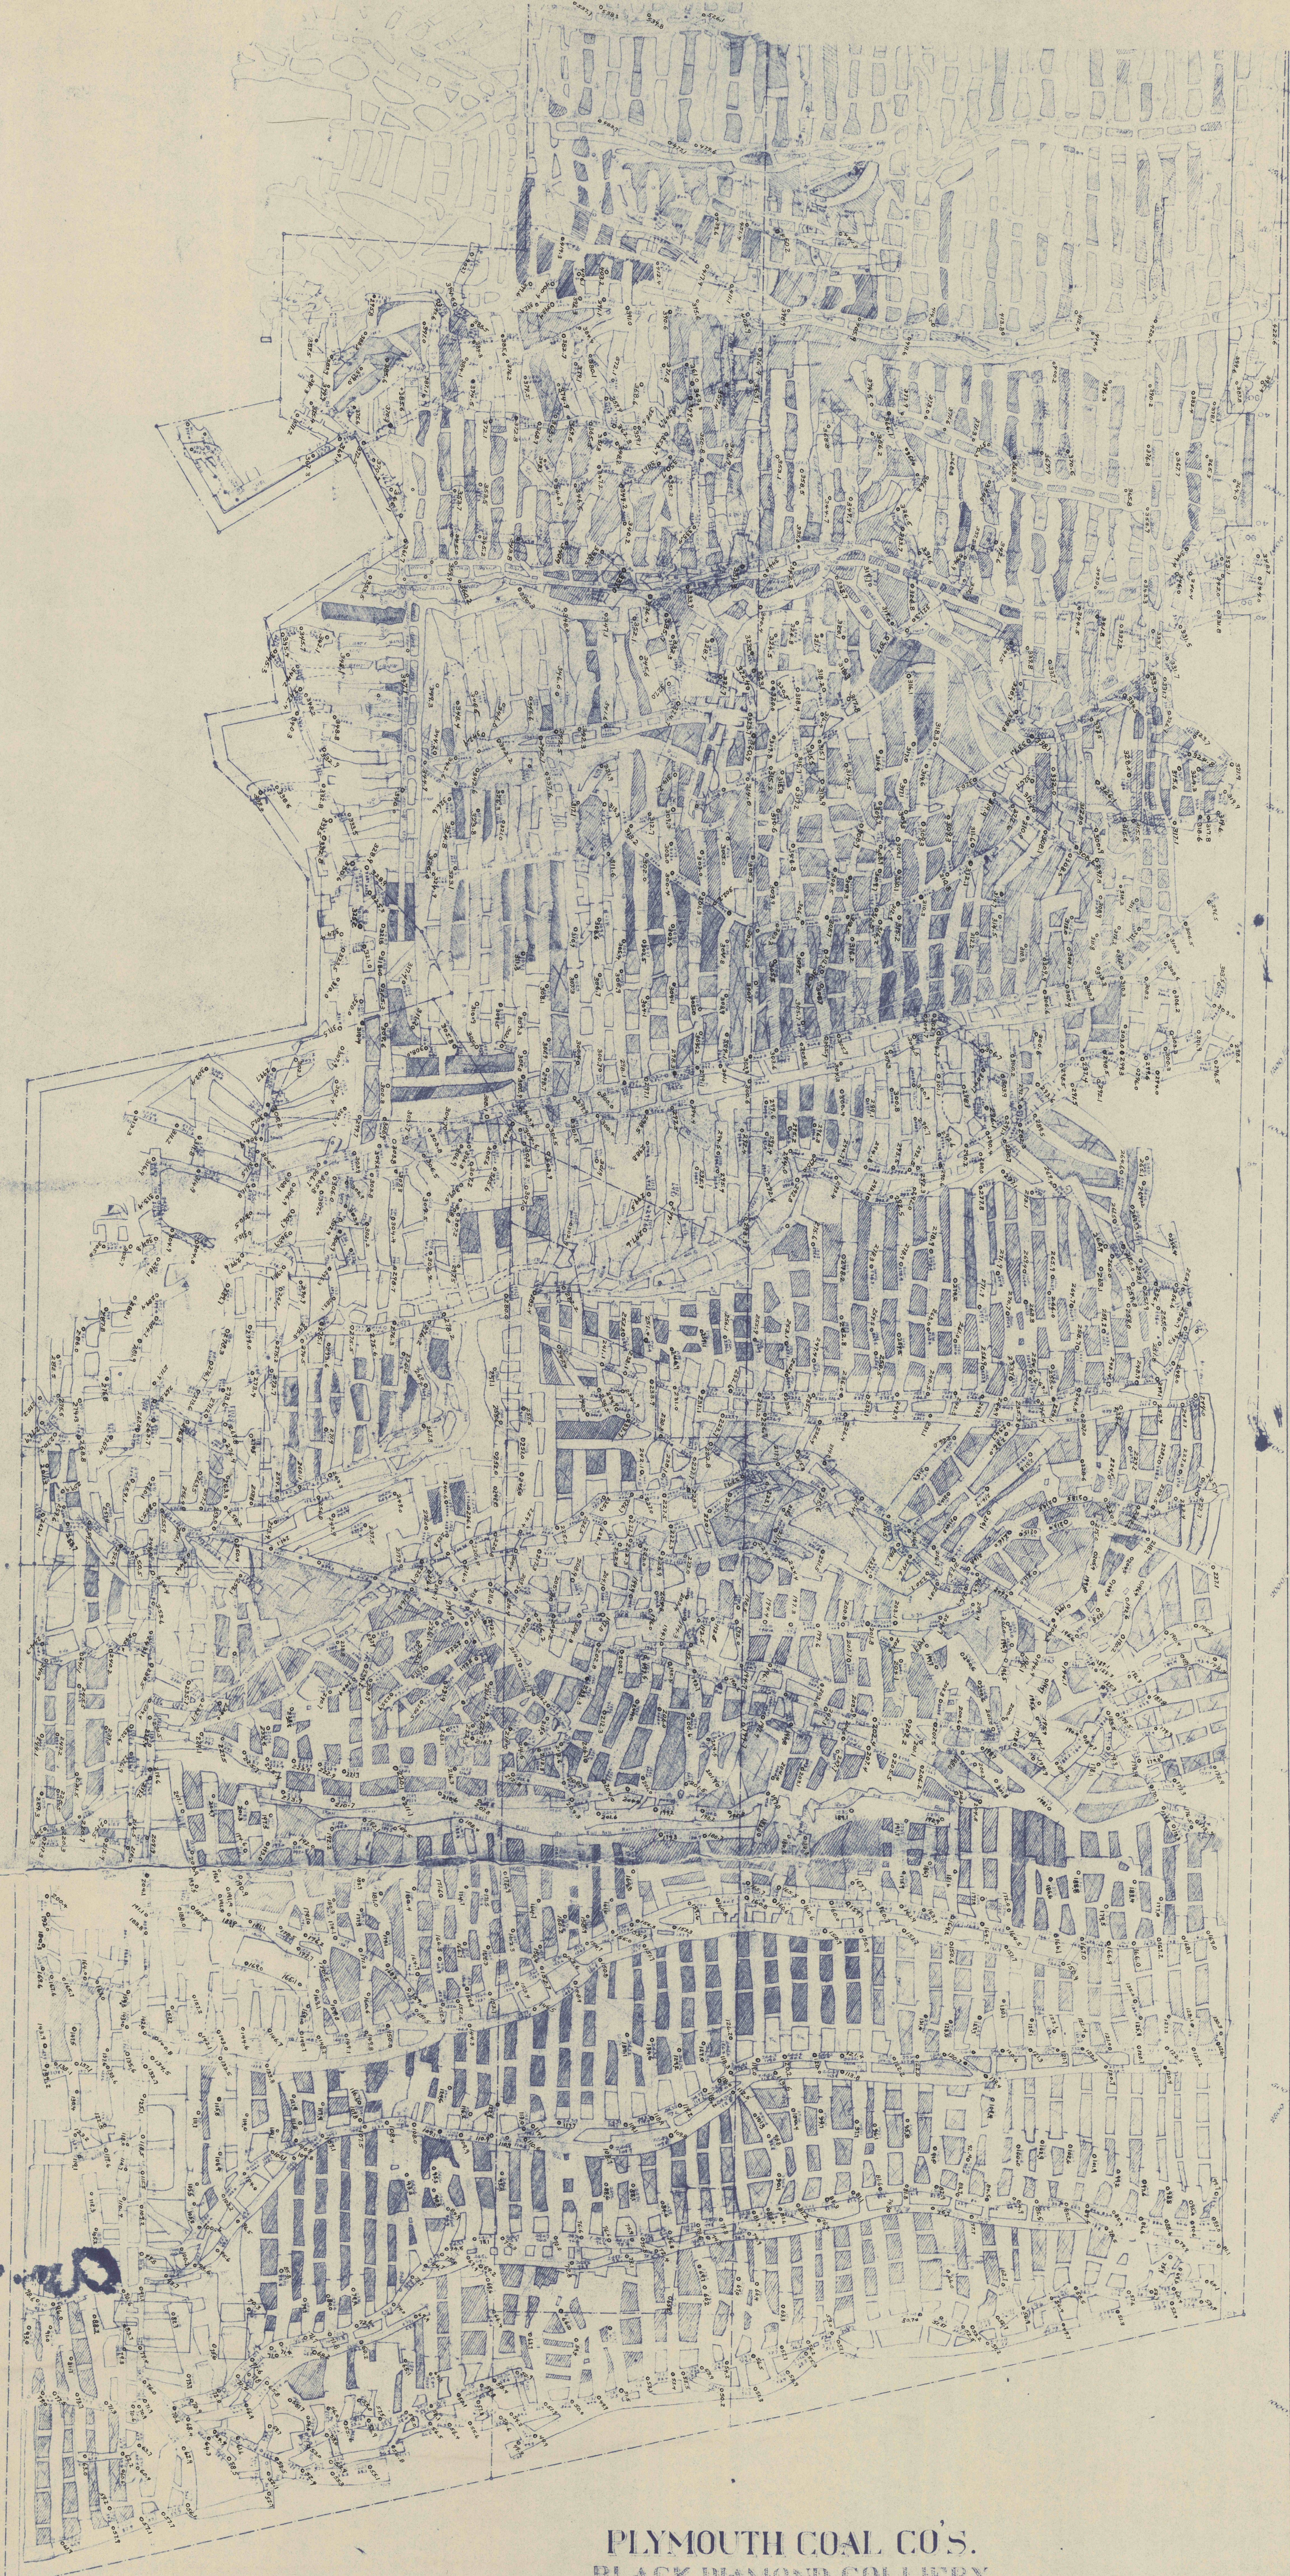

PLYMOUTH COAL CO.'S.
BLACK DIAMOND COLLIERY
WORKINGS ELEVENTH LEVEL
Scale 100 feet