


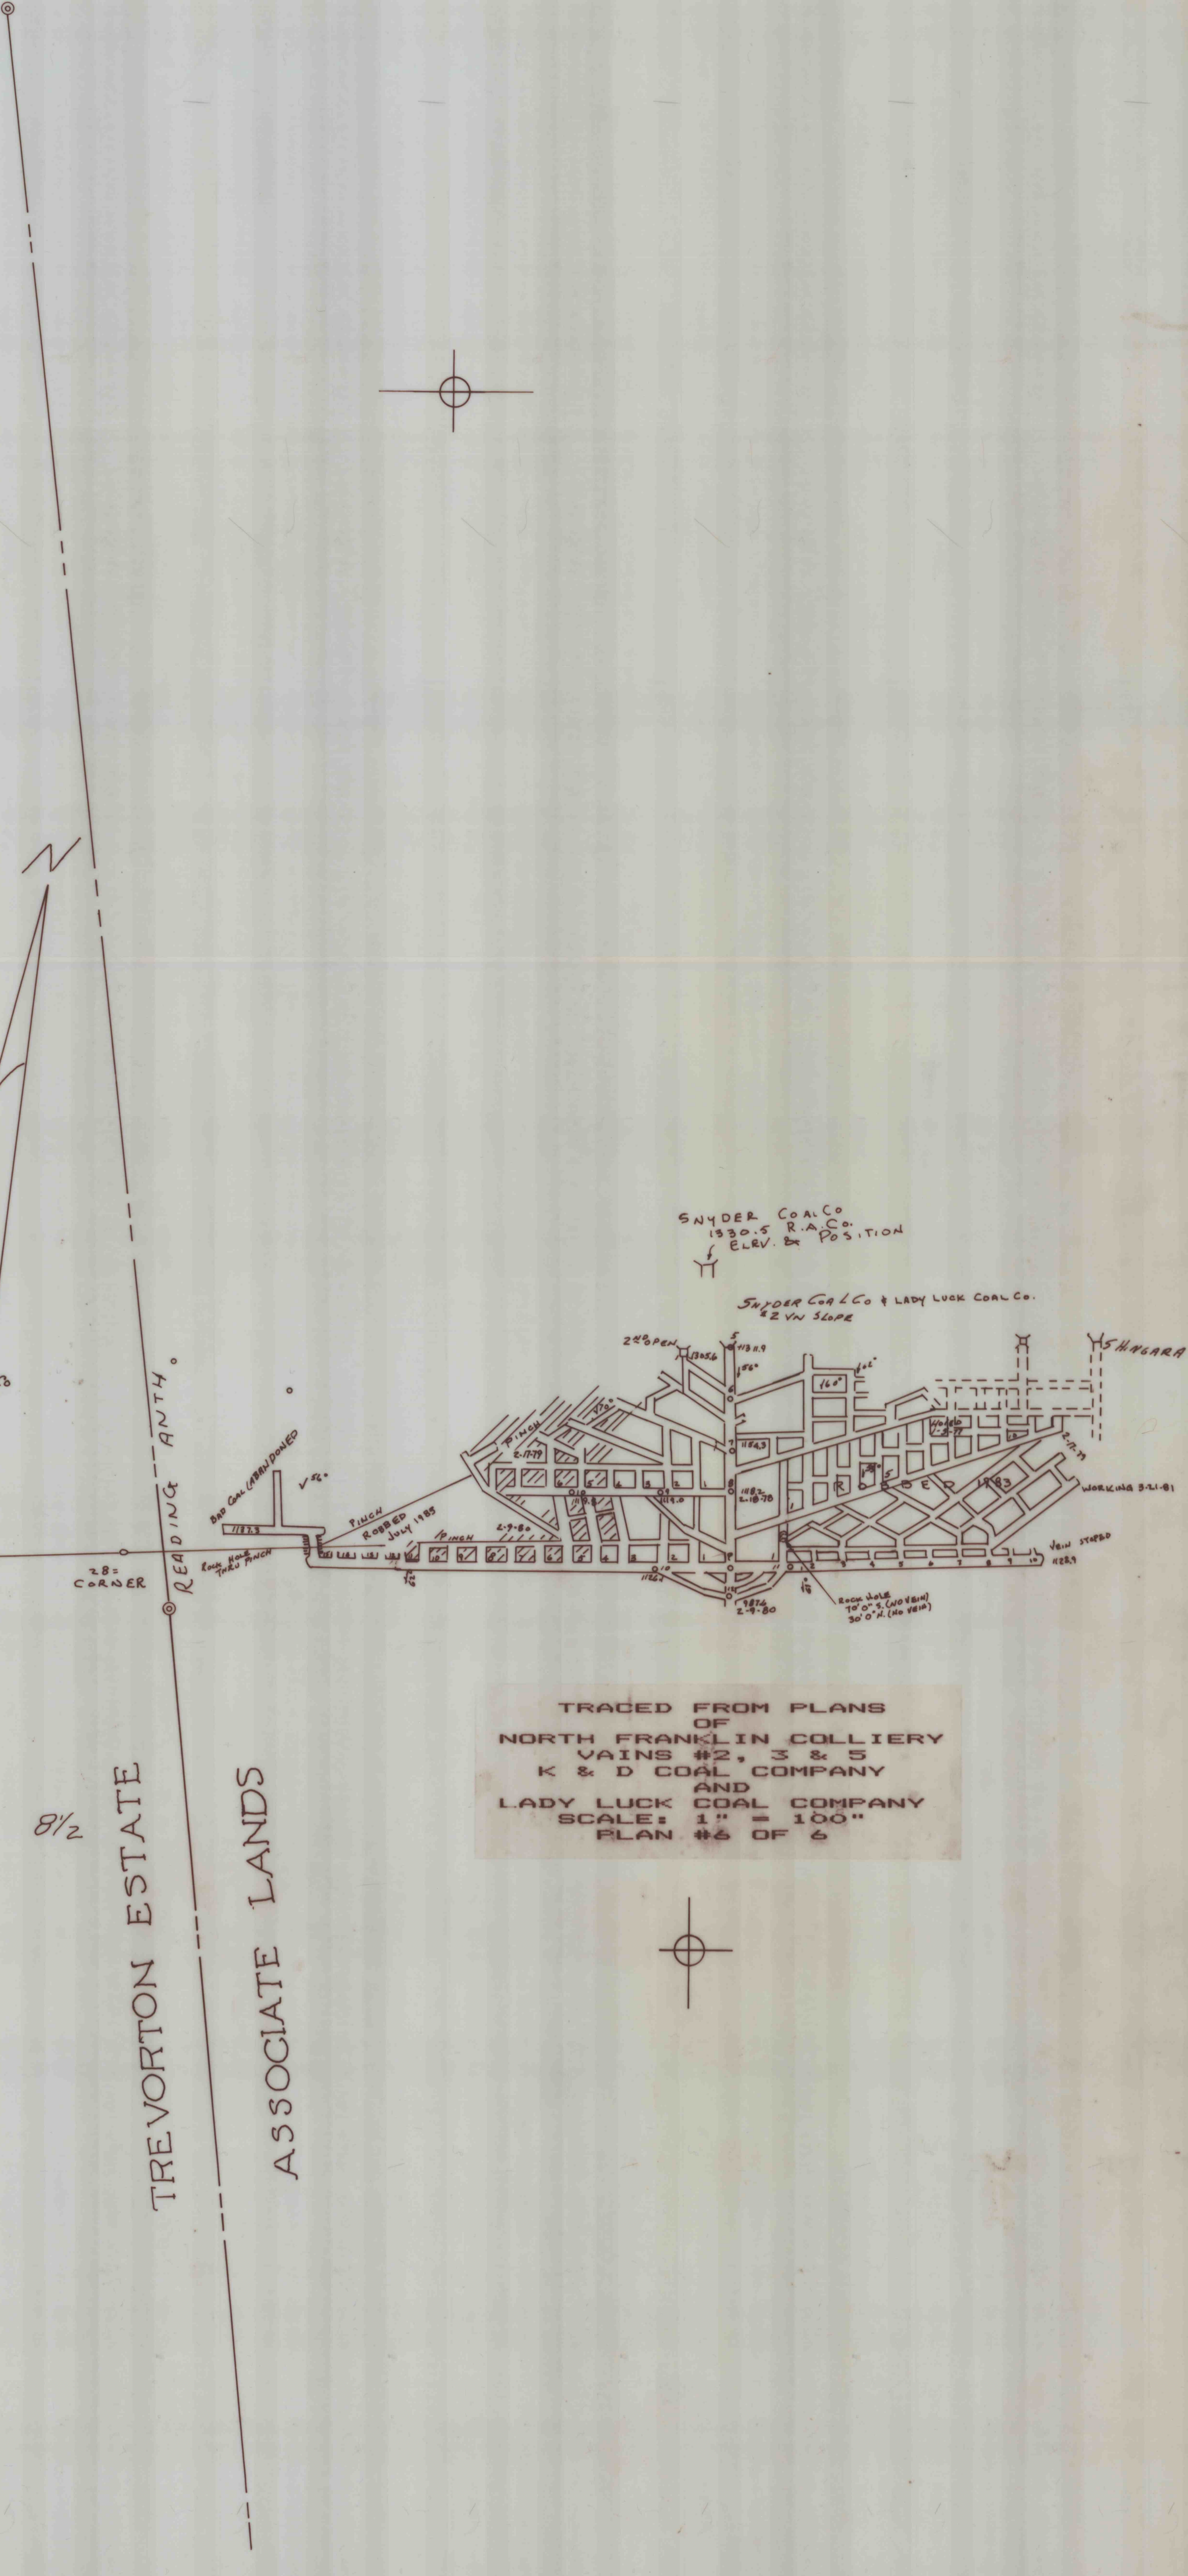

TRACED FROM PLANS
OF
NORTH FRANKLIN COLLIERY
VAINS #2, 3 & 5
K & D COAL COMPANY
AND
LADY LUCK COAL COMPANY
SCALE: 1" = 100"
PLAN #6 OF 6

8/2

TREVORTON ESTATE	ASSOCIATE LANDS
------------------	-----------------

$5^{19.23}$
 $+ 8^{10.1}$

Tunnel from
 $8\frac{1}{2}$ Van Slope workings
 to where?