



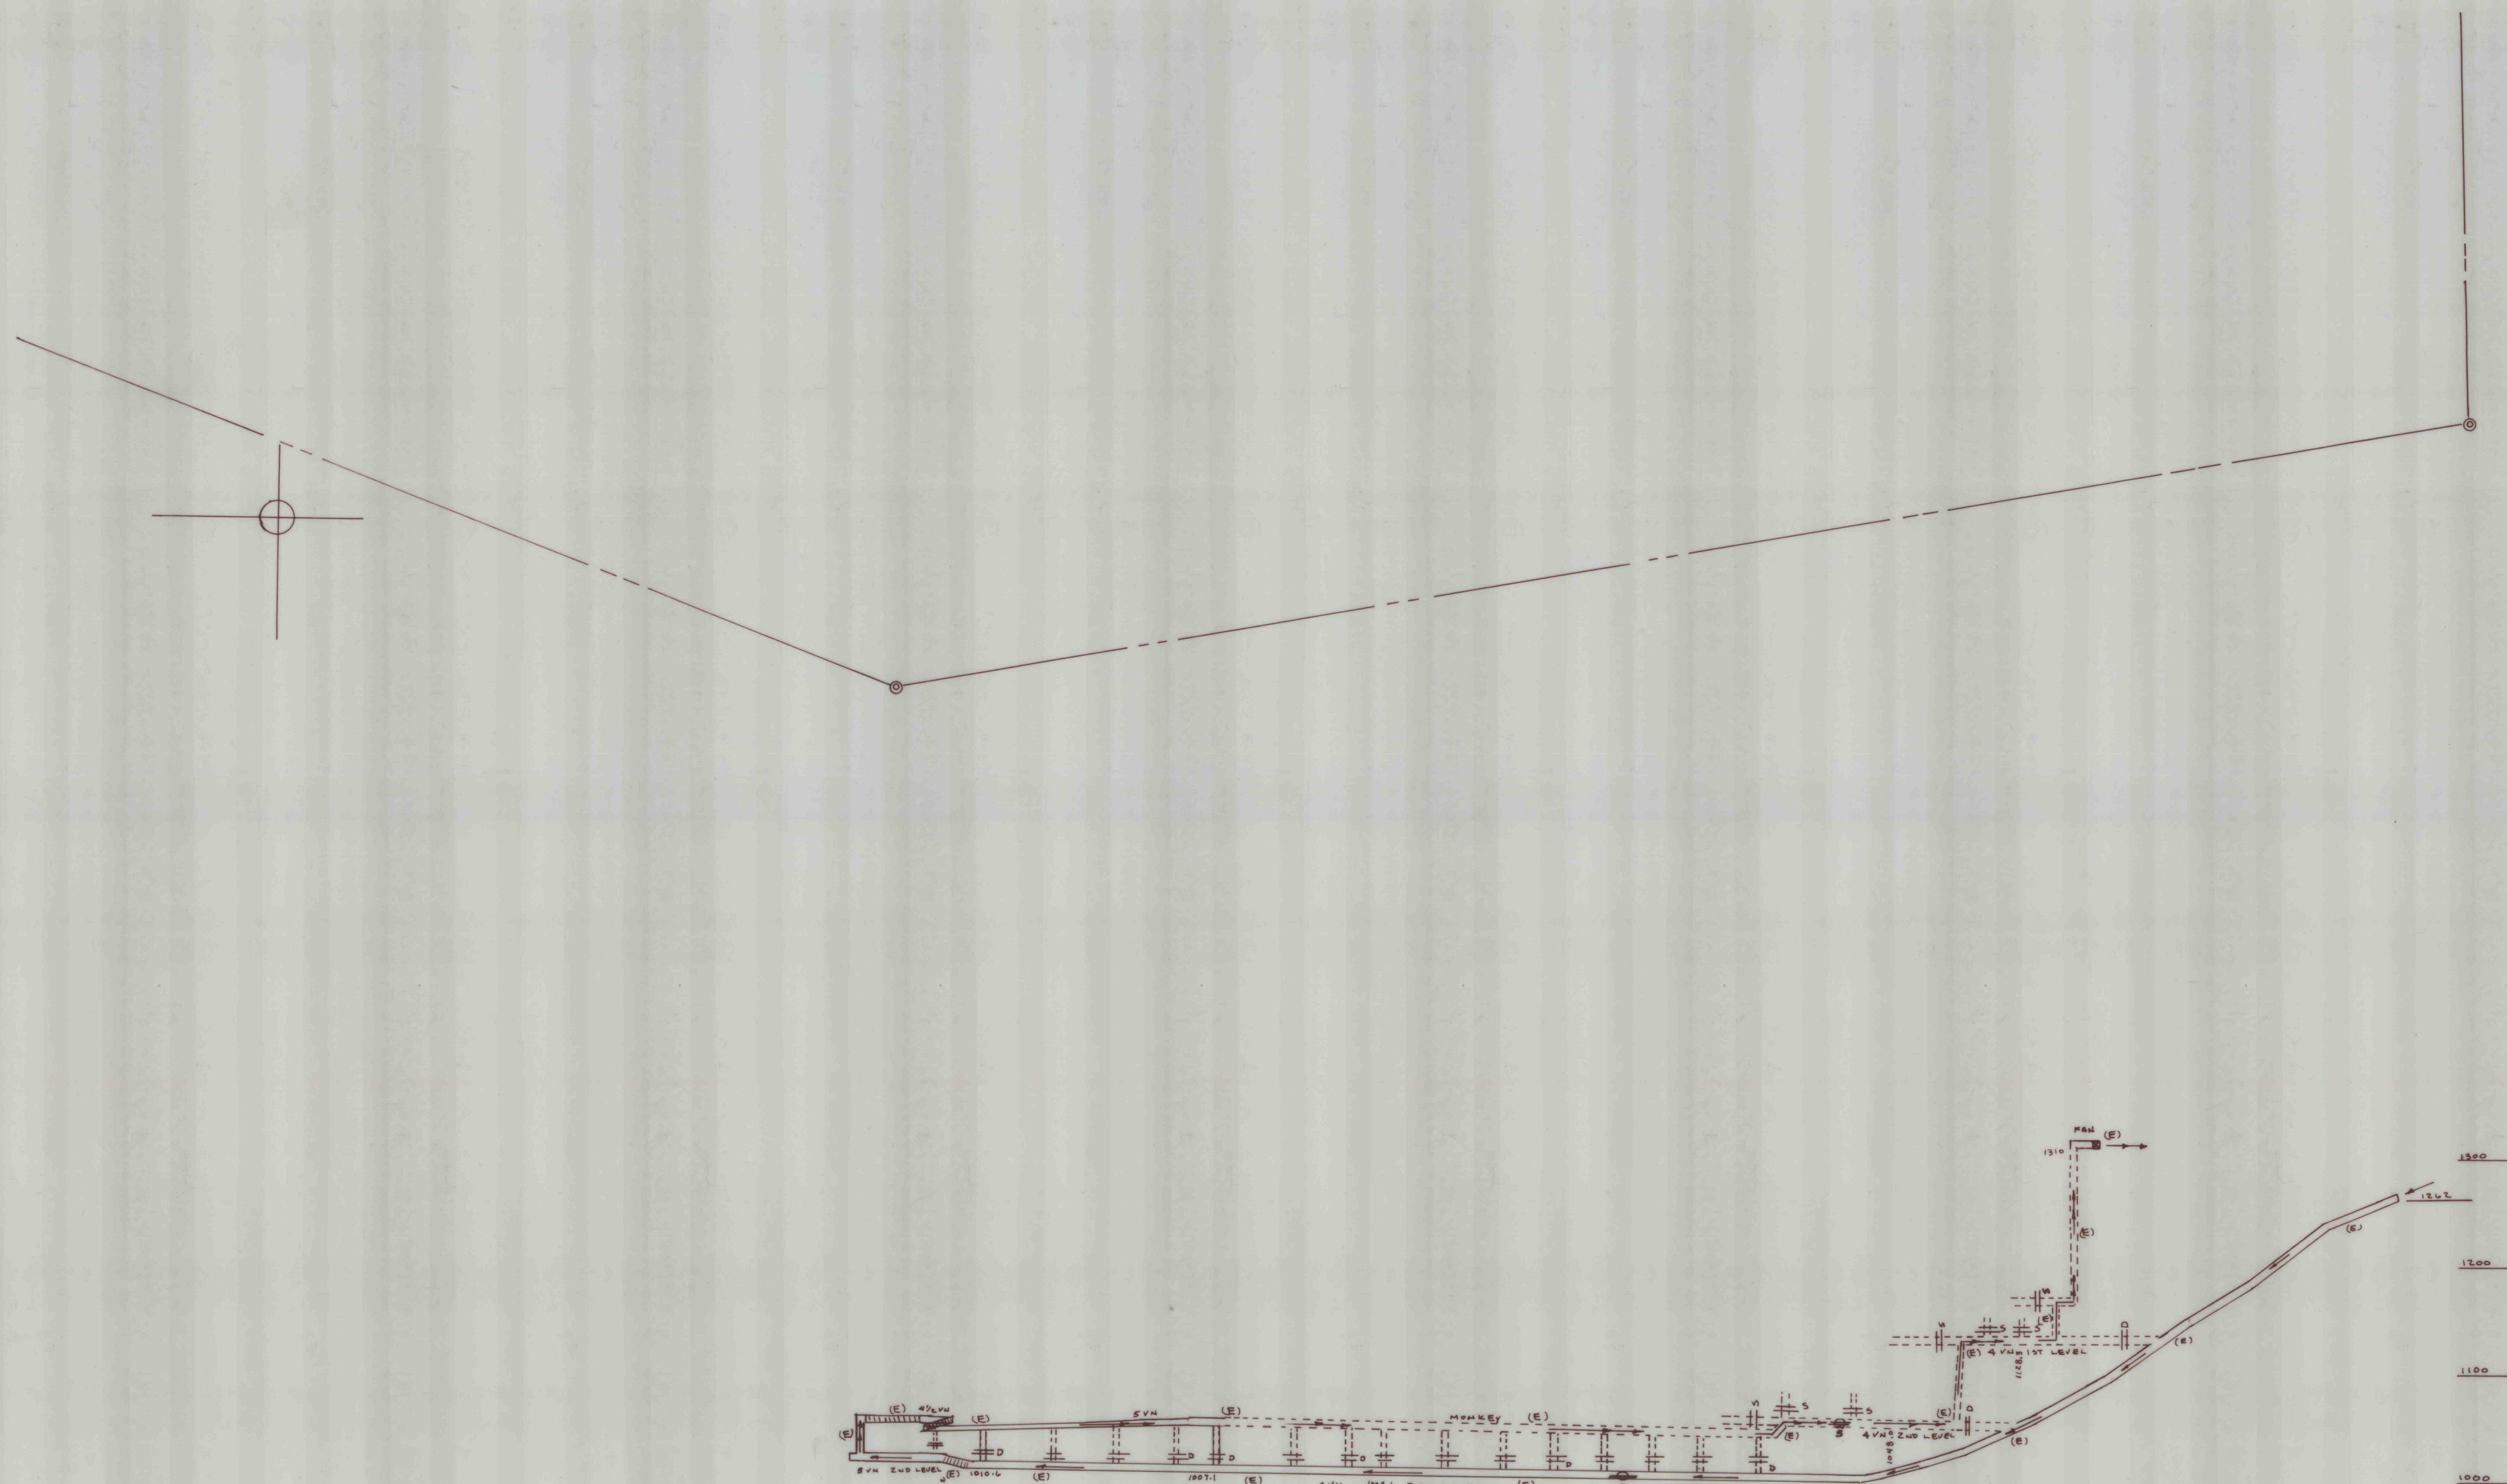


CROSS-SECTION OF VENTILATION AND ESCAPEWAY ROUTES
HORIZONTAL AND VERTICAL SCALE - 1 INCH = 100 FEET

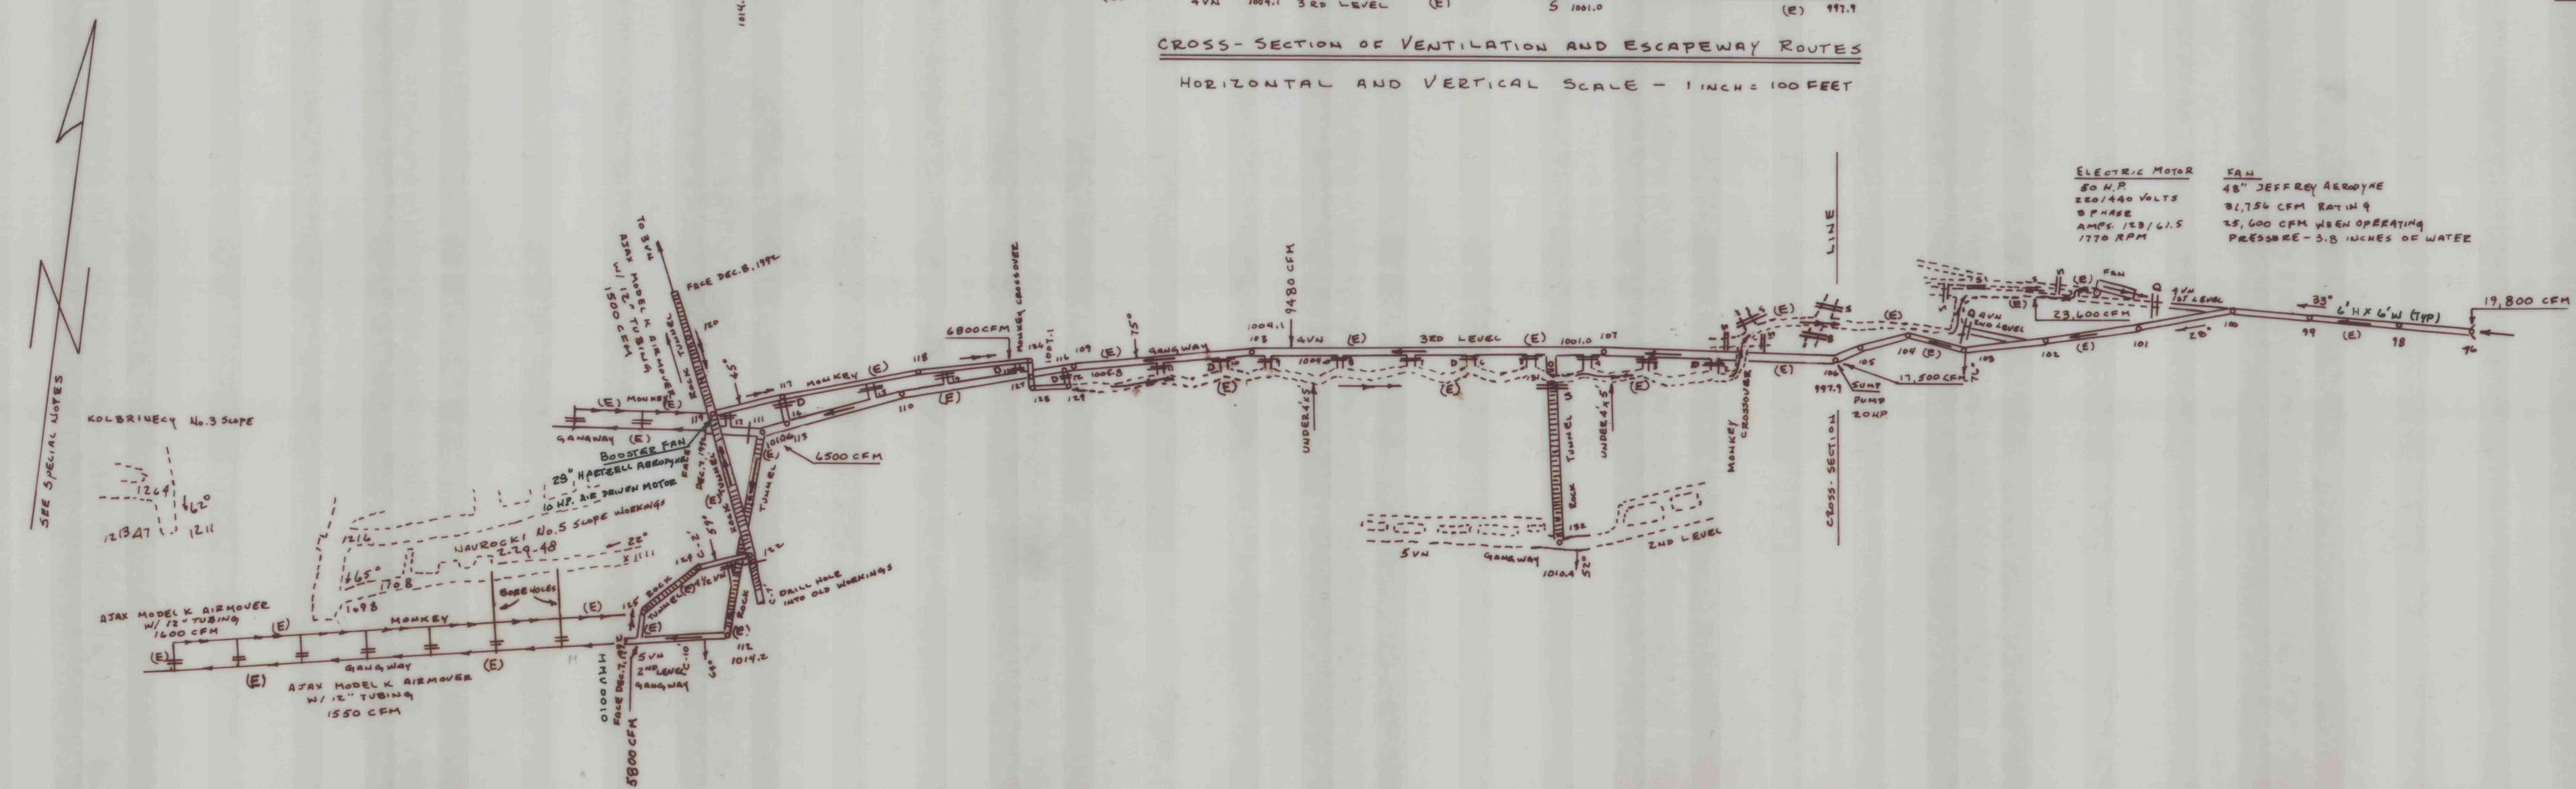

SUBSURFACE HORIZONTAL & VERT. CONTROL DATA

STA.	NORTH	EAST	ELEV.	DESCRIPTION
98	1786.28	-69414.02	1239.0	SPAD/CEILING
99	1782.14	-69404.31	1195.7	SPAD
100	1782.55	-69403.17	1140.9	SPAD
101	1758.44	-69414.48	1096.4	SPAD
102	1739.18	-69404.44	1057.9	SPAD
103	1725.73	-69406.48	1031.2	SPAD
104	1736.11	-69399.56	1019.1	SPAD
105	1737.47	-69395.90	1007.4	SPAD
106	1704.21	-69403.29	1002.6	SPAD
107	1688.89	-70019.31	1009.4	SPAD
108	1655.82	-70288.81	1012.4	SPAD
109	1628.45	-70421.57	1012.5	SPAD
110	1599.56	-70530.51	1016.5	SPAD
111	1547.38	-70652.68	1017.2	SPAD
112	1387.15	-70661.47	1022.8	SPAD
113	1555.78	-70634.55	1018.7	SPAD
116	1625.76	-70429.16	1015.8	SPAD
117	1576.35	-70440.84	1056.2	SPAD
118	1607.93	-70540.57	1047.7	SPAD
119	1556.45	-70492.53	1051.4	SPAD
120	1611.64	-70718.06	1052.0	SPAD
122	1449.89	-70650.74	1057.2	SPAD
124	1455.34	-70688.92	1056.7	SPAD
125	1397.81	-70727.02	1055.8	SPAD
126	1627.53	-70456.26	1041.3	SPAD
127	1617.31	-70453.92	1043.4	SPAD
128	1607.48	-70451.10	1037.5	SPAD
129	1611.16	-70424.34	1022.7	SPAD
131	1677.66	-70056.88	1006.9	SPAD
132	1576.65	-70035.21	1010.4	SPAD

CROSS-SECTION VEINS 3, 4, 5 & 6 LOOKING WEST
HORIZONTAL & VERTICAL 1" = 100'

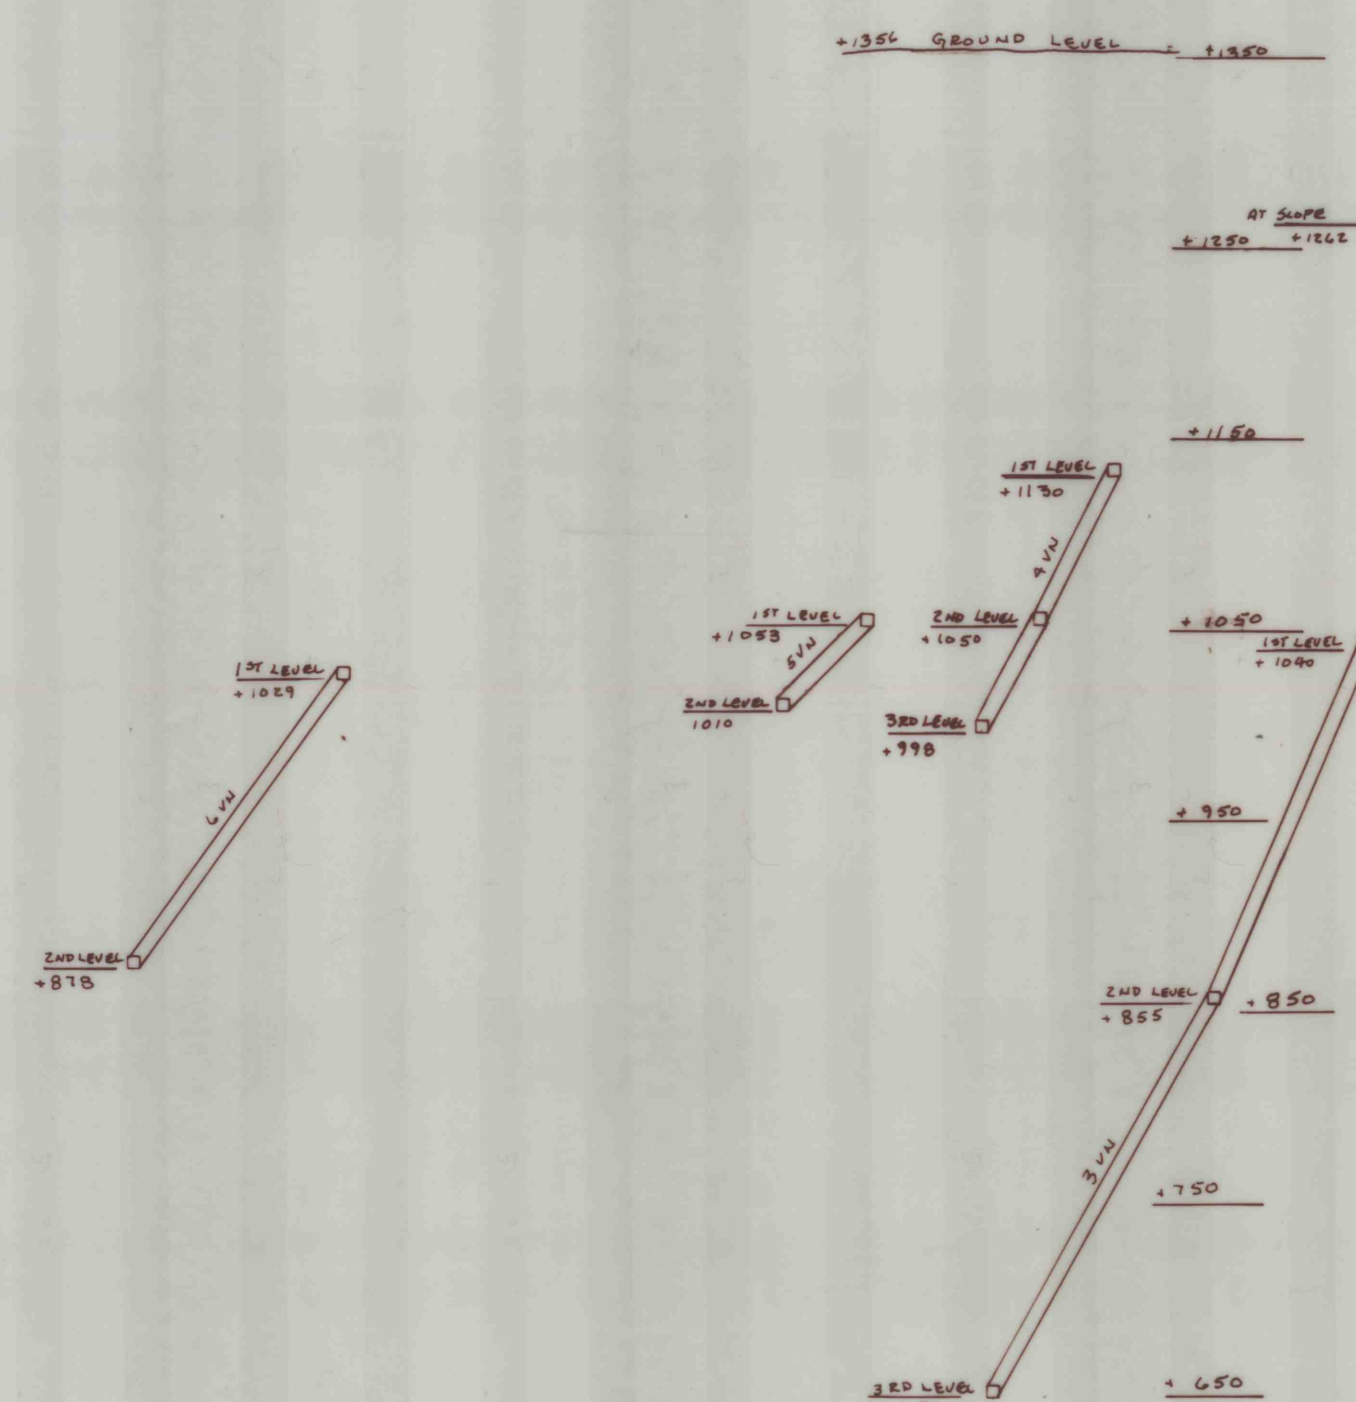


WILLIAM J. MESSNER, P.L.S.
R.D. #1 BOX 1523
HERNDON, PA. 17830
(717) 758-9266
SU-28849-E

William J. Messner

PLAN OF
MINE
AND
VENTILATION
FOR
SNYDER COAL COMPANY
MSHA I.D. #36-02203
DER I.D. #49861303R
R.D. #2 BOX 464
HEBINS, PA. 17938
(717) 682-9698
LOCATED IN
N. AND L. SLOPE
NO. 4 & 5 VEINS - SOUTH DIP
BIG MOUNTAIN
TOWNSHIP OF ZERBY
COUNTY OF NORTHUMBERLAND
COMMONWEALTH OF PENNSYLVANIA
SCALE: AS NOTED
DATE: JANUARY 5, 1993
FILE: SNYDER COAL
PLAN #2 OF 8

REVISED: MAR. 9, 1995

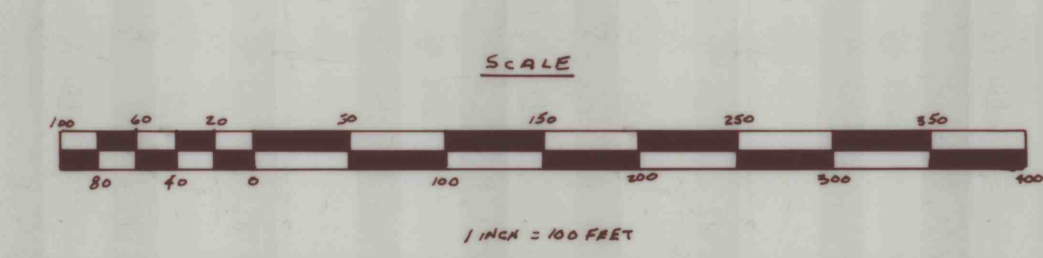

JAN. 25, 1993

7846