

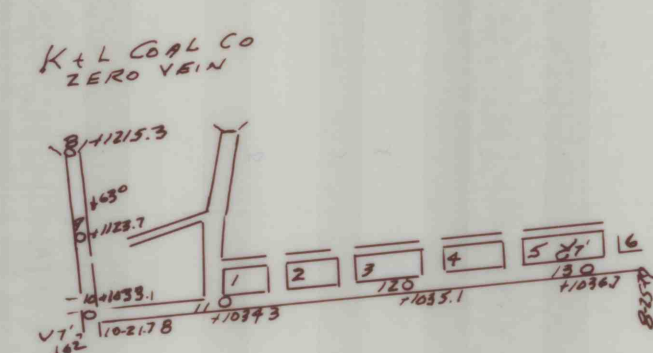


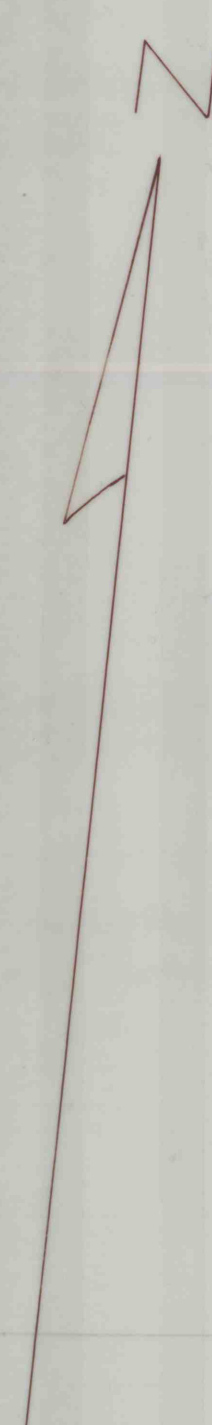

0.9  
1307.4


U. NOYROCKI SLOPE

50 1371.0

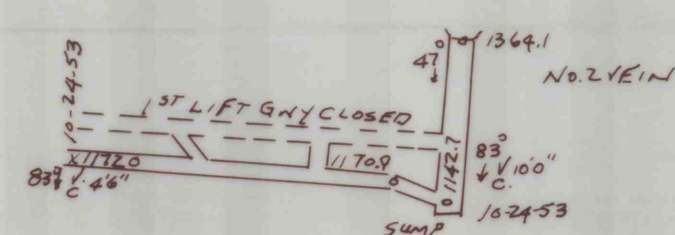


DRIFT muth  
1034.7  
1050±


10502  
Drift T mouth + 867  
854

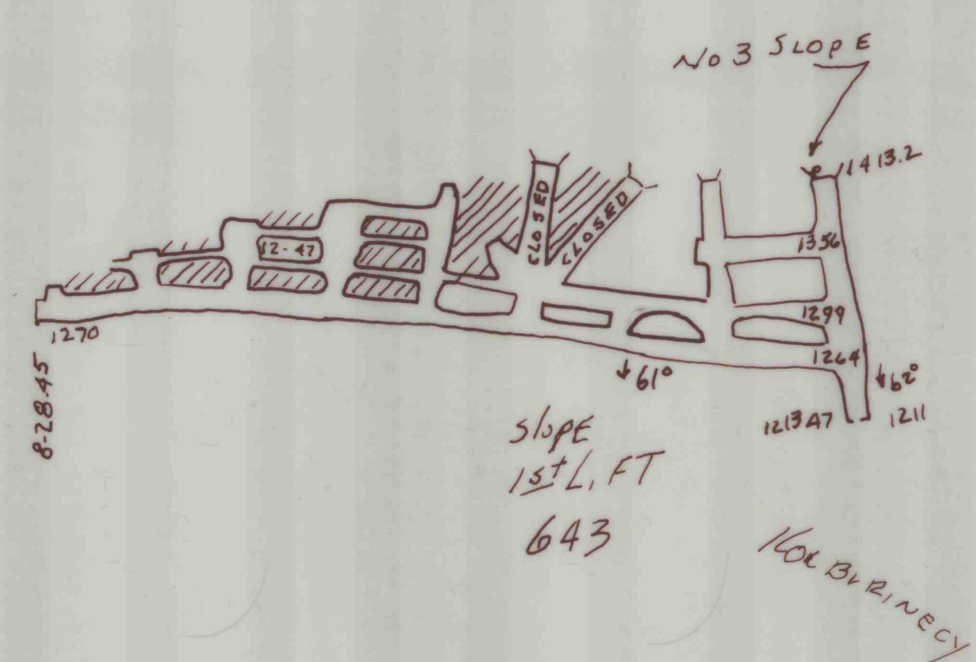

NO 5 SLOPE

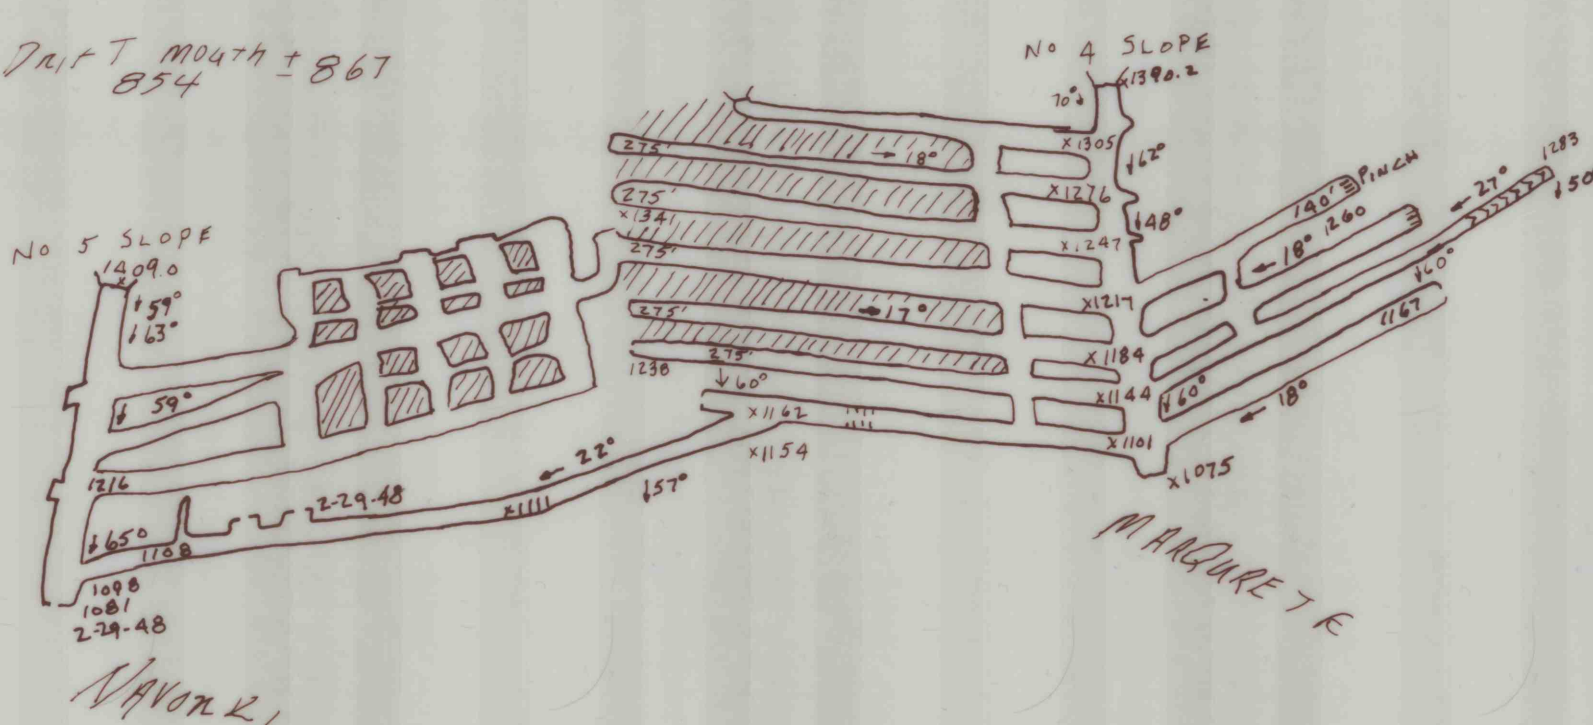

MARGURET

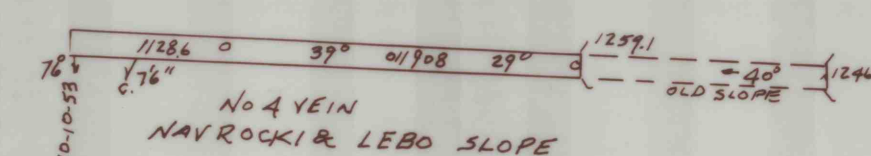

TRACED FROM PLAN  
OF  
NORTH FRANKLIN COLLIERY  
VAINS #2, 3 & 5  
DATE: JULY 1, 1912  
SCALE: 1" = 100'  
PLAN #7 OF 8