


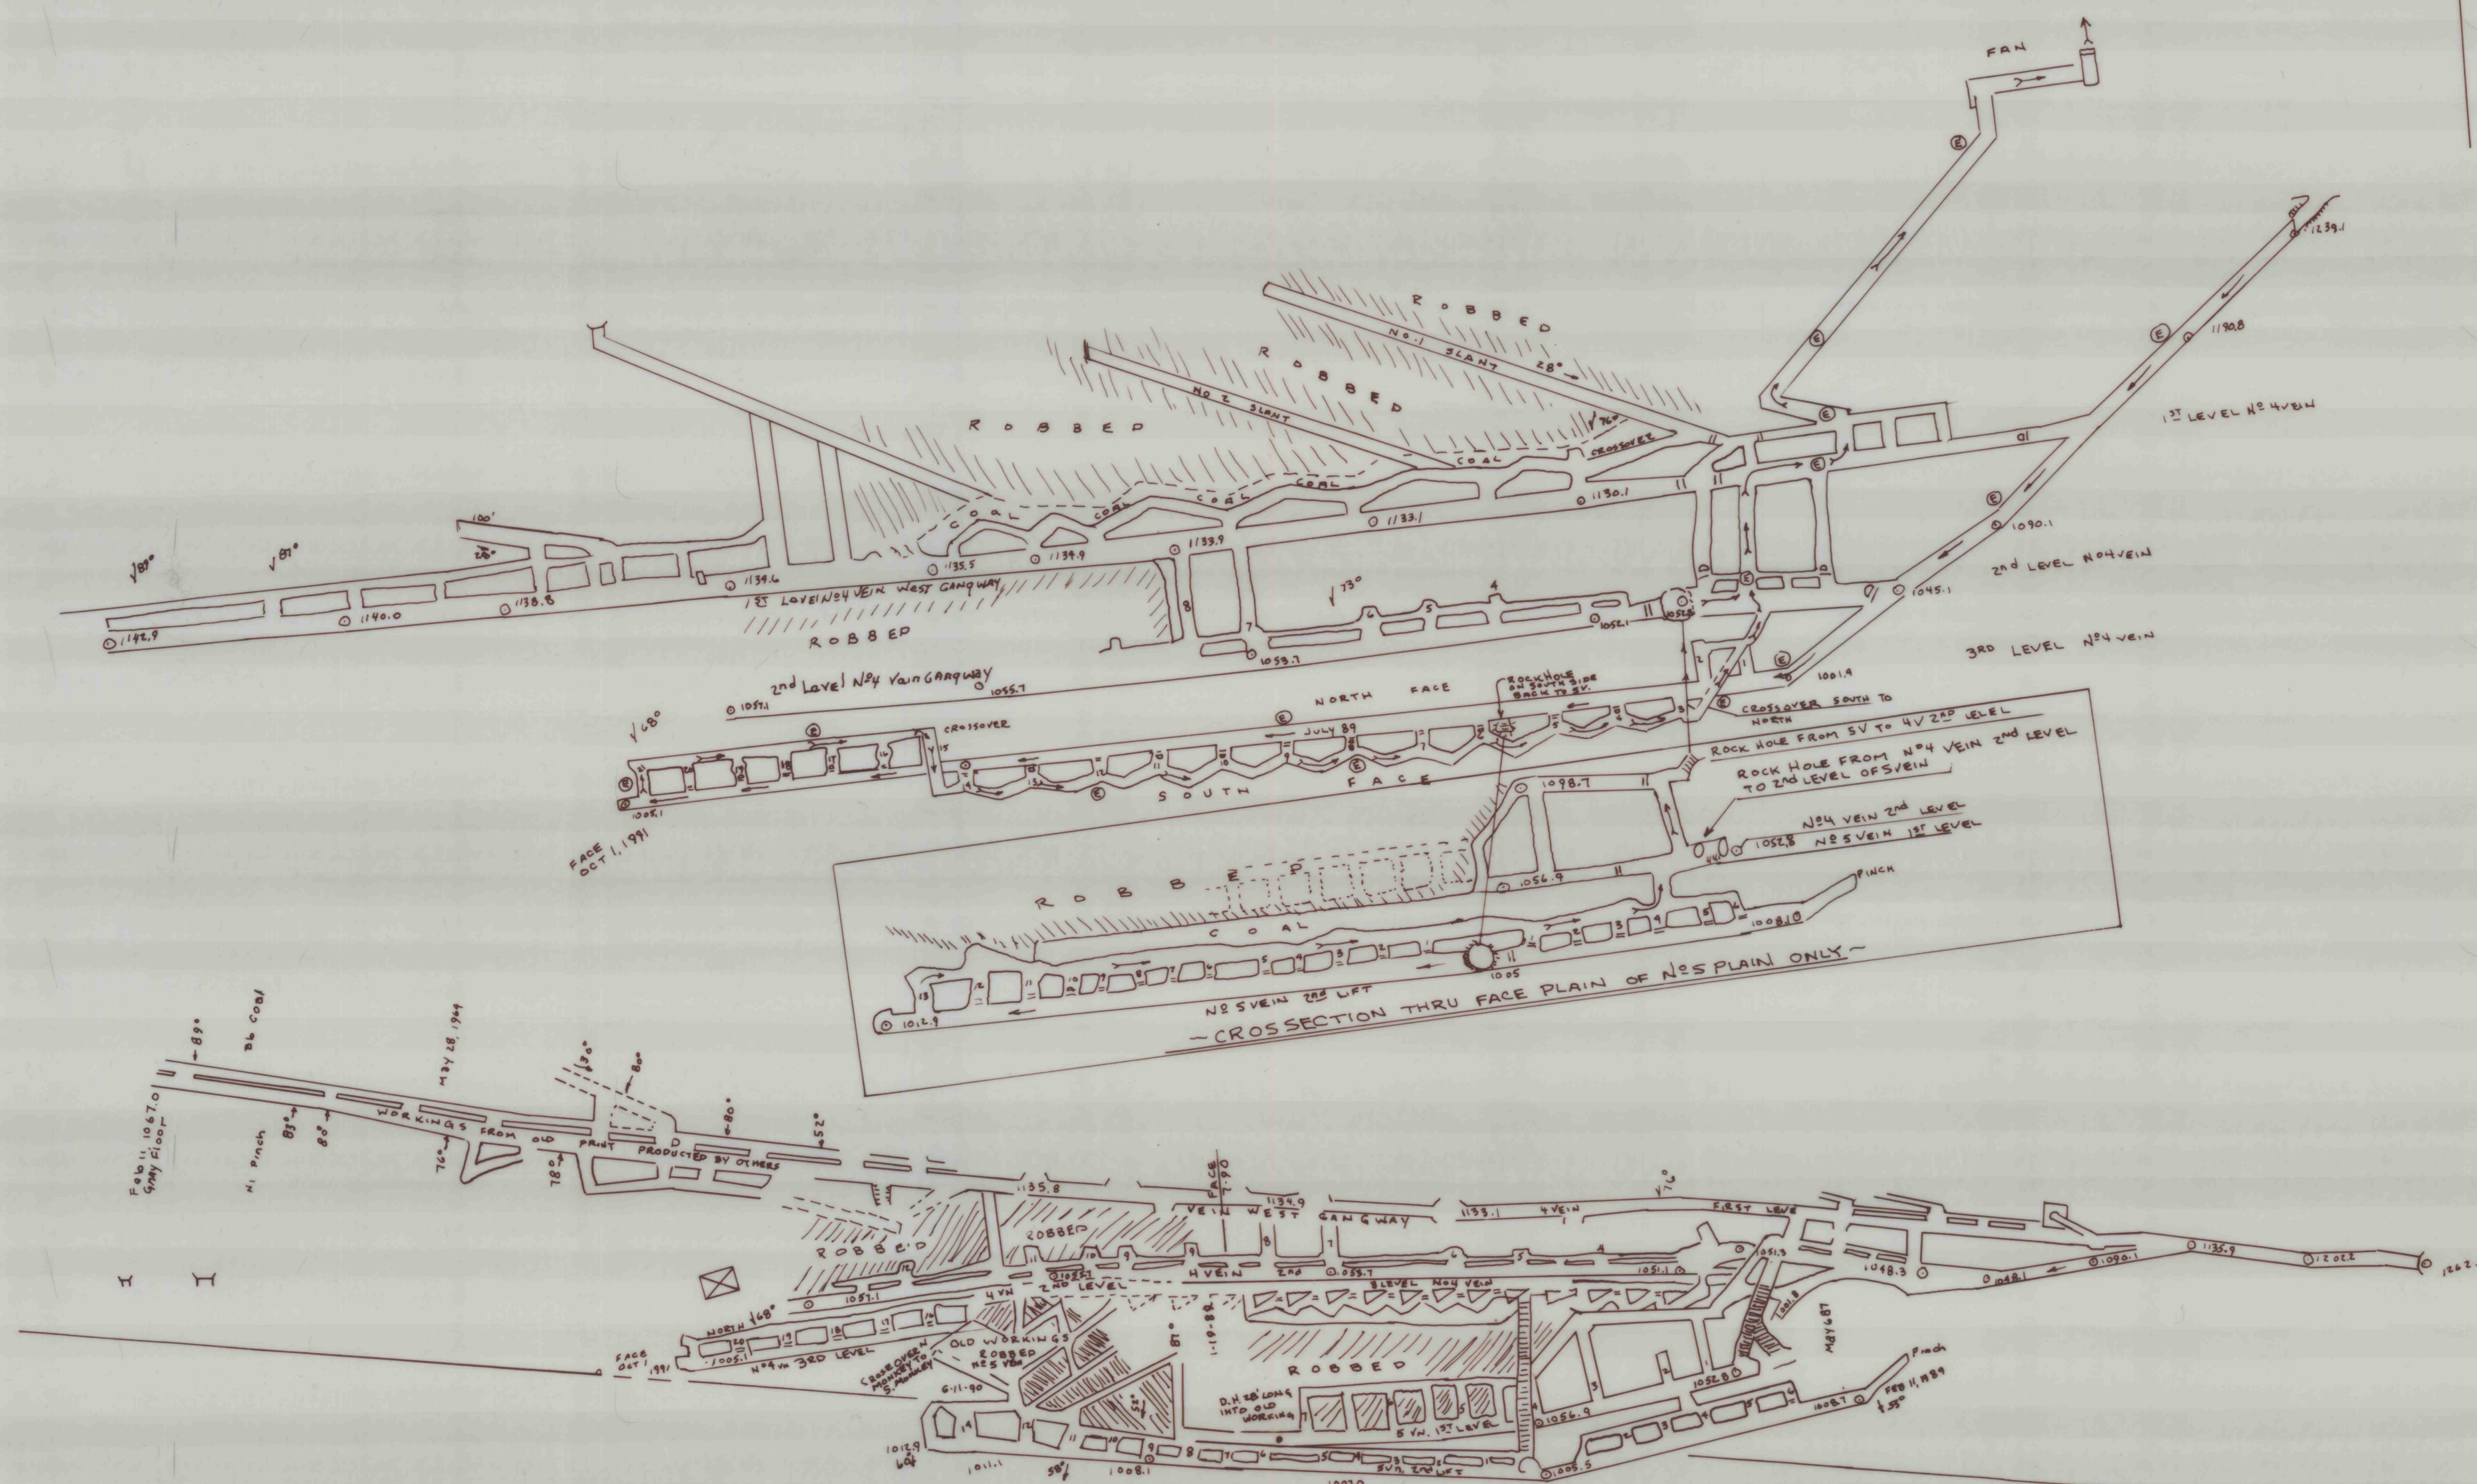

OVERLAY MAP OF ALL LEVELS OF N4 & N5 VEIN
 TRACED FROM MAP OF JERRY E. TRUMBAUER, P.E.
 DATED: 12 NOV. 1991
 MAPPED BY OTHERS

TRACED FROM PLAN
 OF
 SNYDER COAL CO.
 PREPARED BY
 JERRY E. TRUMBAUER, P.E.
 DATE: NOVEMBER 12, 1991
 SCALE: 1" = 100'
 PLAN #3 OF 8