


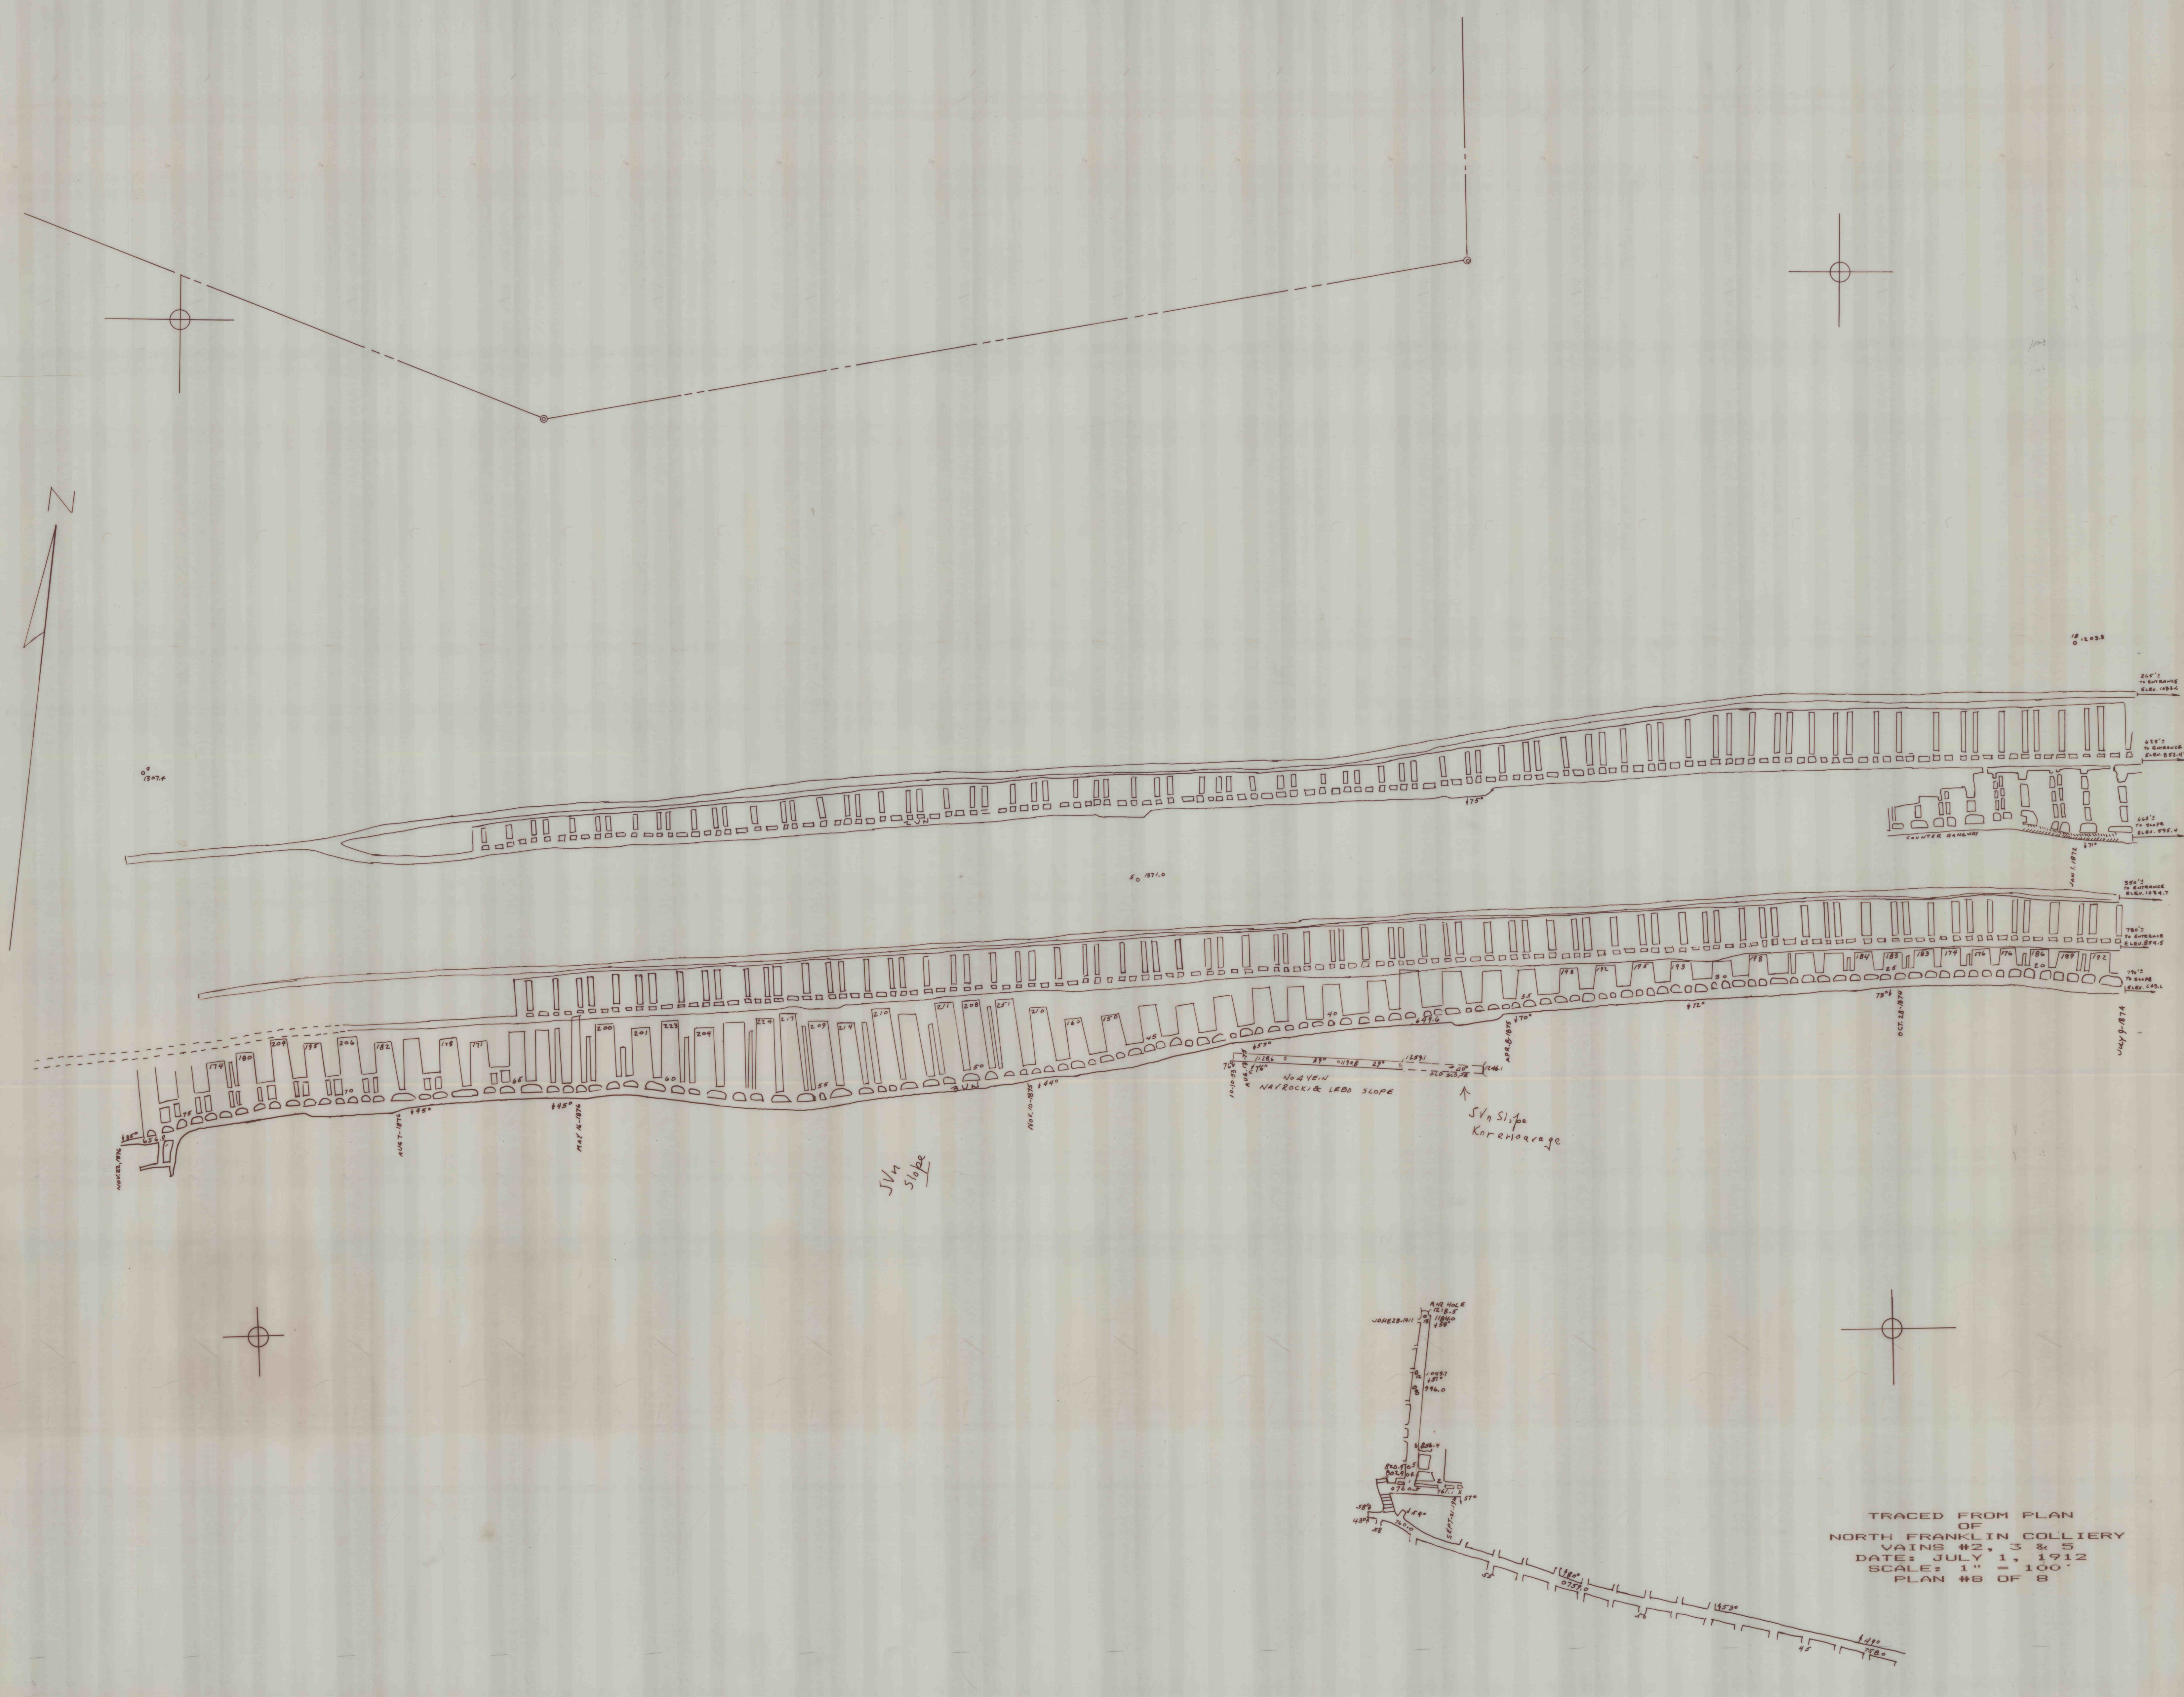

TRACED FROM PLAN
 OF
 NORTH FRANKLIN COLLIERY
 VAINS #2, 3 & 5
 DATE: JULY 1, 1912
 SCALE: 1" = 100'
 PLAN #8 OF 8