

LOCATION MAP



SCALE

1 INCH = 2000 FEET

SURFACE HORIZONTAL & VERTICAL CONTROL DATA


STA.	NORTH	EAST	ELEV.	DESCRIPTION
5	4884.53	4242.45	1299.5	DRILL HOLE
6	4902.38	4360.30	1294.4	DRILL HOLE
11	5037.41	5245.66	1304.5	RAILROAD SPIKE IN ROCK
15	5162.65	5999.44	1247.1	1. PIN IN CONCRETE
26	5482.95	6507.36	1300.4	1. PIN IN CONCRETE
34	5677.76	6114.76	1321.7	1. PIN
61	5886.77	5985.65	1316.6	1. PIN
47	5387.55	4766.72	1395.5	NAIL
52	5313.32	4269.29	1393.5	NAIL

OLD MINE MAPS:

- * NO OTHER MINE MAPS HAVE BEEN DISCOVERED.
- * ANY FUTURE MINE MAP DISCOVERY WILL BE ADDED AT SUCH TIME.
- * NO CERTIFICATION IS EXPRESSED OR IMPLIED AS TO THE ACCURACY, EXISTENCE OR NONEXISTENCE OF THE WORKINGS OF OLD MINE MAPS.

LEGEND

- (E) ESCAPEWAY
- FAH - EXHAUSTING
- O TRAVERSE
- X SPT ELEVATION
- DEPRESSION
- TEMPORARY AIR BATTERIES
- 2" PLANK AIR BATTERIES (PERMANENT)
- 2" PLANK AIR BATTERIES WITH DOOR
- 1" PLANK AIR BATTERIES WITH DOOR AND MANWAY
- SEAL
- DIRECTION OF AIRFLOW IN
- DIRECTION OF AIRFLOW OUT
- OPEN SLOPE
- CLOSED SLOPE
- OVERCAST
- PROPOSED WORKINGS FOR ONE YEAR
- OLD WORKINGS
- NOT LOCATED BY SURVEY
- Q.W.Y. GANGWAY
- V.N. VEIN
- I.P. IRON PIN
- ELEV. ELEVATION
- H.P. HORSE POWER
- AMPS AMPERES
- C.M.C. CONCRETE MOUNT
- R.P.M. REVOLUTIONS PER MINUTE
- B.M. BENCH MARK
- M.M.U. MECHANICAL MOUNTING UNIT
- A.M.S. ATMOSPHERIC MONITORING SYSTEM
- B.E.P. BLEEDER EVALUATION POINT
- C.U. CUBIC INCH

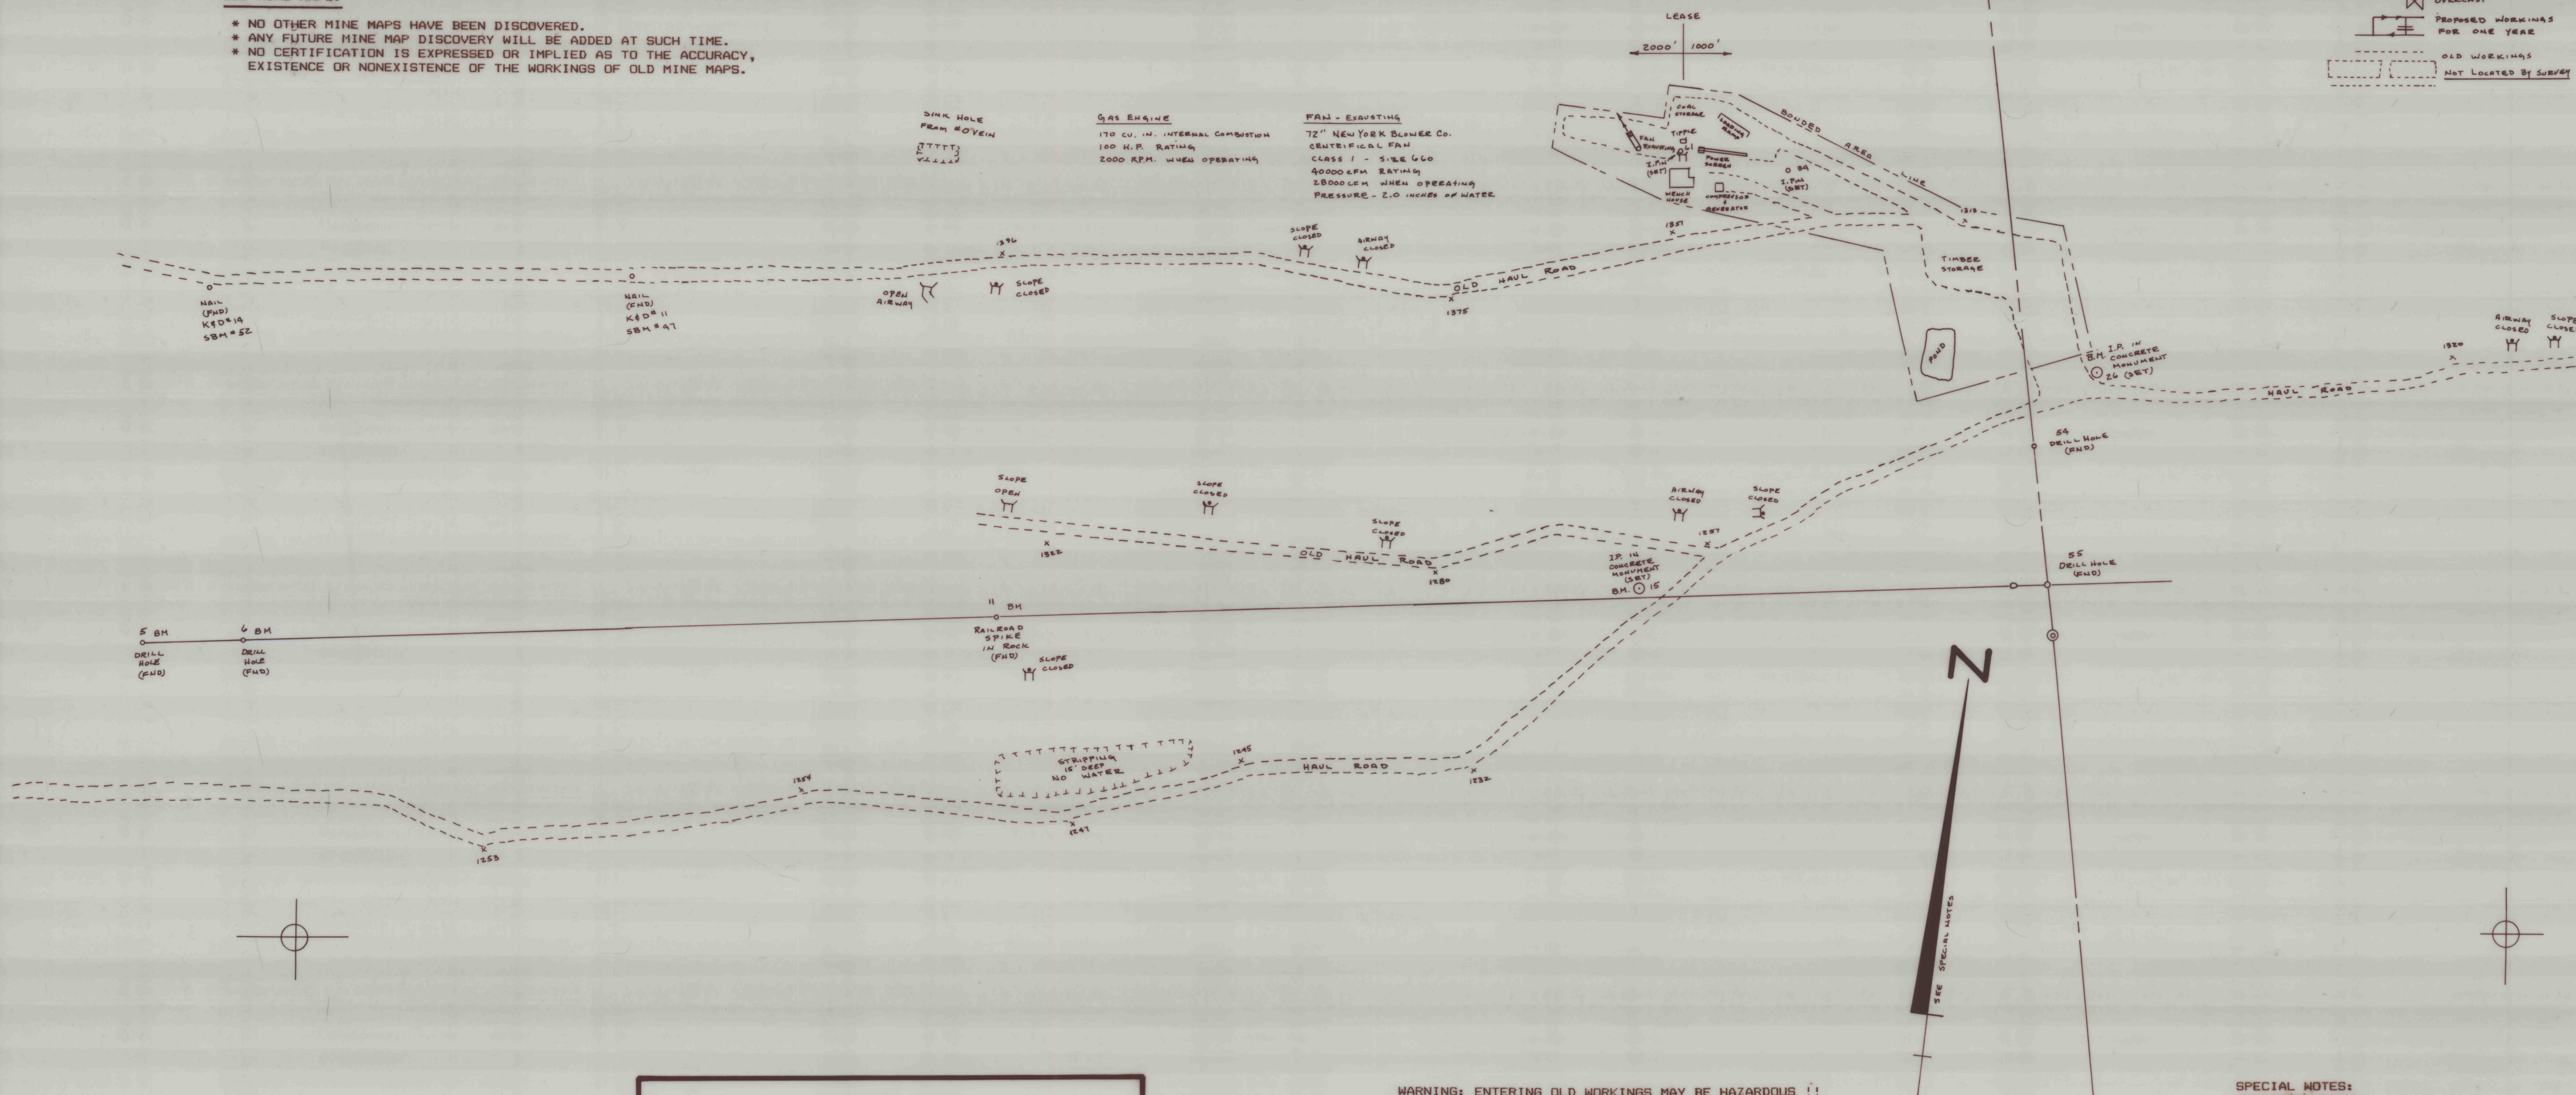

PLAN OF
MINE
AND
VENTILATION
FOR
S B & M COAL COMPANY
MSHA I.D. #36-05495
DER I.D. #49861309T
F.D. #2
HEGINS, PA. 17938
(717) 682-3697
LOCATED IN
M & R SLOPE
NO. ZERO VEIN - SOUTH DIP
BIG MOUNTAIN
TOWNSHIP OF ZERBY
COUNTY OF NORTHUMBERLAND
COMMONWEALTH OF PENNSYLVANIA
SCALE: AS NOTED
DATE: APRIL 30, 1993
FILE: SBM COAL
PLAN: #1 OF 6

WILLIAM J. MESSNER, P.L.S.
R.D. #1 BOX 1523
HERNDON, PA. 17830
(717) 758-9266
SU-28849-E

WARNING: ENTERING OLD WORKINGS MAY BE HAZARDOUS !!

SPECIAL NOTES:

- * COORDINATES AND ELEVATIONS BASED ON DATUM OF MINE MAP OF CHESTNUT COAL COMPANY BY TAYLOR-DOBICK ASSOCIATES, DATED JUNE 1, 1989, REVISED AUGUST 6, 1992.
- * VENTILATION INFORMATION SUPPLIED BY MINE OPERATOR.
- * COAL VEIN INFORMATION SUPPLIED BY MINE OPERATOR.
- * PROPOSED WORKINGS SUPPLIED BY MINE OPERATOR.

