


LOCATION MAP

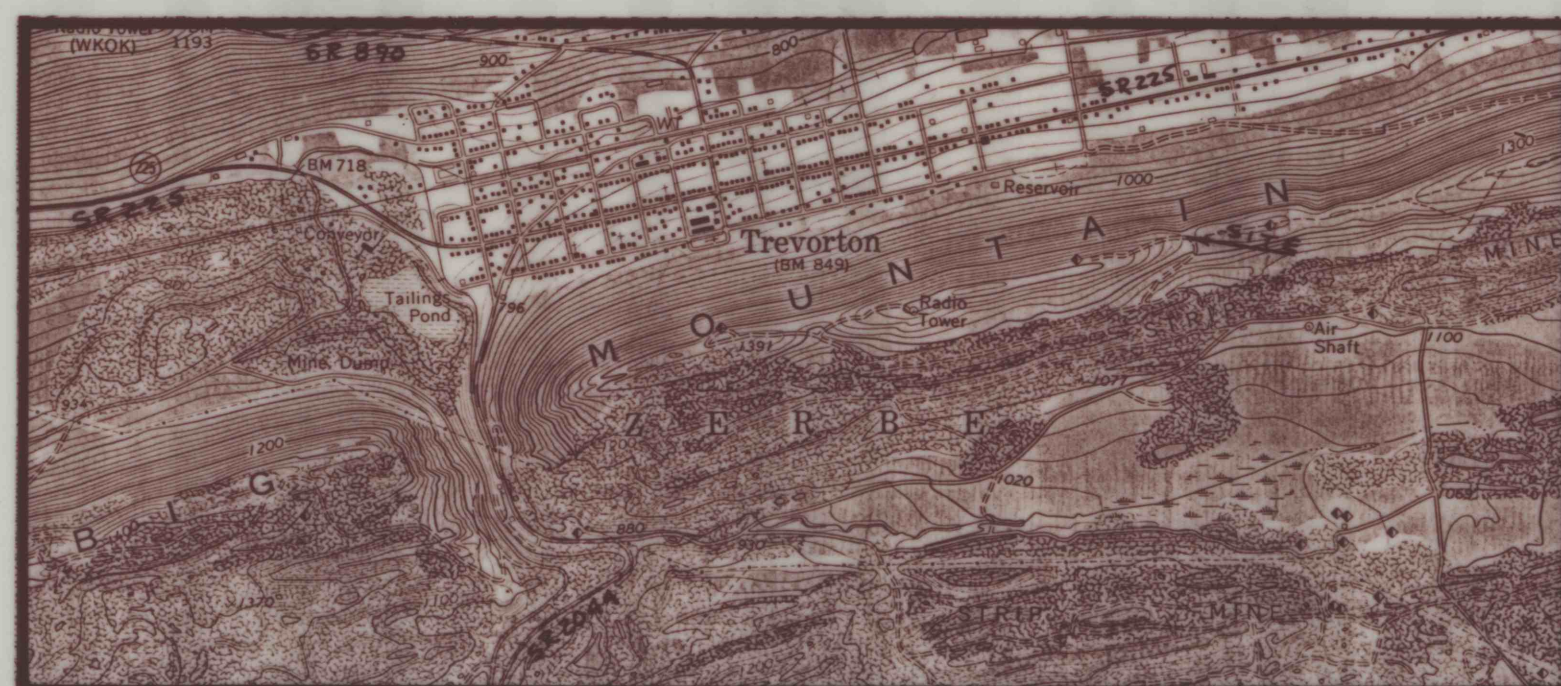

SCALE  
1 INCH = 2000 FEET

SURFACE HORIZONTAL & VERTICAL CONTROL DATA

| STA. | NORTH   | EAST    | ELEV.  | DESCRIPTION            |
|------|---------|---------|--------|------------------------|
| 5    | 4884.53 | 4242.45 | 1299.5 | DRILL HOLE             |
| 6    | 4902.38 | 4360.30 | 1294.4 | DRILL HOLE             |
| 11   | 5037.41 | 5245.66 | 1304.5 | RAILROAD SPIKE IN ROCK |
| 15   | 5142.43 | 5999.44 | 1247.1 | 1. PIN IN CONCRETE     |
| 26   | 5482.95 | 6507.36 | 1300.4 | 1. PIN IN CONCRETE     |
| 34   | 5677.76 | 6114.76 | 1321.7 | 1. PIN                 |
| 61   | 5686.77 | 5985.65 | 1316.6 | 1. PIN                 |
| 47   | 5387.55 | 4766.72 | 1395.5 | NAIL                   |
| 52   | 5315.32 | 4269.29 | 1395.5 | NAIL                   |

OLD MINE MAPS:

- \* NO OTHER MINE MAPS HAVE BEEN DISCOVERED.
- \* ANY FUTURE MINE MAP DISCOVERY WILL BE ADDED AT SUCH TIME.
- \* NO CERTIFICATION IS EXPRESSED OR IMPLIED AS TO THE ACCURACY, EXISTENCE OR NONEXISTENCE OF THE WORKINGS OF OLD MINE MAPS.




GAS ENGINE  
170 CU. IN. INTERNAL COMBUSTION  
100 H.P. RATING  
2000 R.P.M. WHEN OPERATING

FAN - EXHAUSTING  
PRESSURE - 2.0 INCHES OF WATER

LEASE  
2000' 1000'

- LEGEND
- (E) ESCAPEWAY
  - RAV - EXHAUSTING
  - O FENCE
  - X SPOT ELEVATION
  - DEPRESSION
  - TEMPERARY AIR BATTERIES
  - 2" PLANK AIR BATTERIES (PERMANENT)
  - 2" PLANK AIR BATTERIES WITH DUNE
  - 2" PLANK AIR BATTERIES WITH DUNE AND MANWAY
  - SEAL
  - DIRECTION OF AIRFLOW IN
  - DIRECTION OF AIRFLOW OUT
  - OPEN SLOPE
  - CLOSED SLOPE
  - OVERCAST
  - PROPOSED WORKINGS FOR ONE YEAR
  - OLD WORKINGS NOT LOCATED BY SURVEY
  - PREVIOUS YEARS WORKINGS NOT LOCATED BY SURVEY
  - QWY AIRWAY
  - VEIN
  - T.P. TRAIL P.N.
  - ELEV. ELEVATION
  - H.P. HORSE POWER
  - AMPS AMPERES
  - CONC. CONCRETE MOUNTAIN
  - R.P.M. REVOLUTIONS PER MINUTE
  - B.M. BENCH MARK
  - M.M.U. MECHANIZED MINING UNIT
  - A.M.S. ATMOSPHERIC MONITORING SYSTEM
  - B.E.P. BLEEDER EVALUATION POINT
  - CU. IN. CUBIC INCH

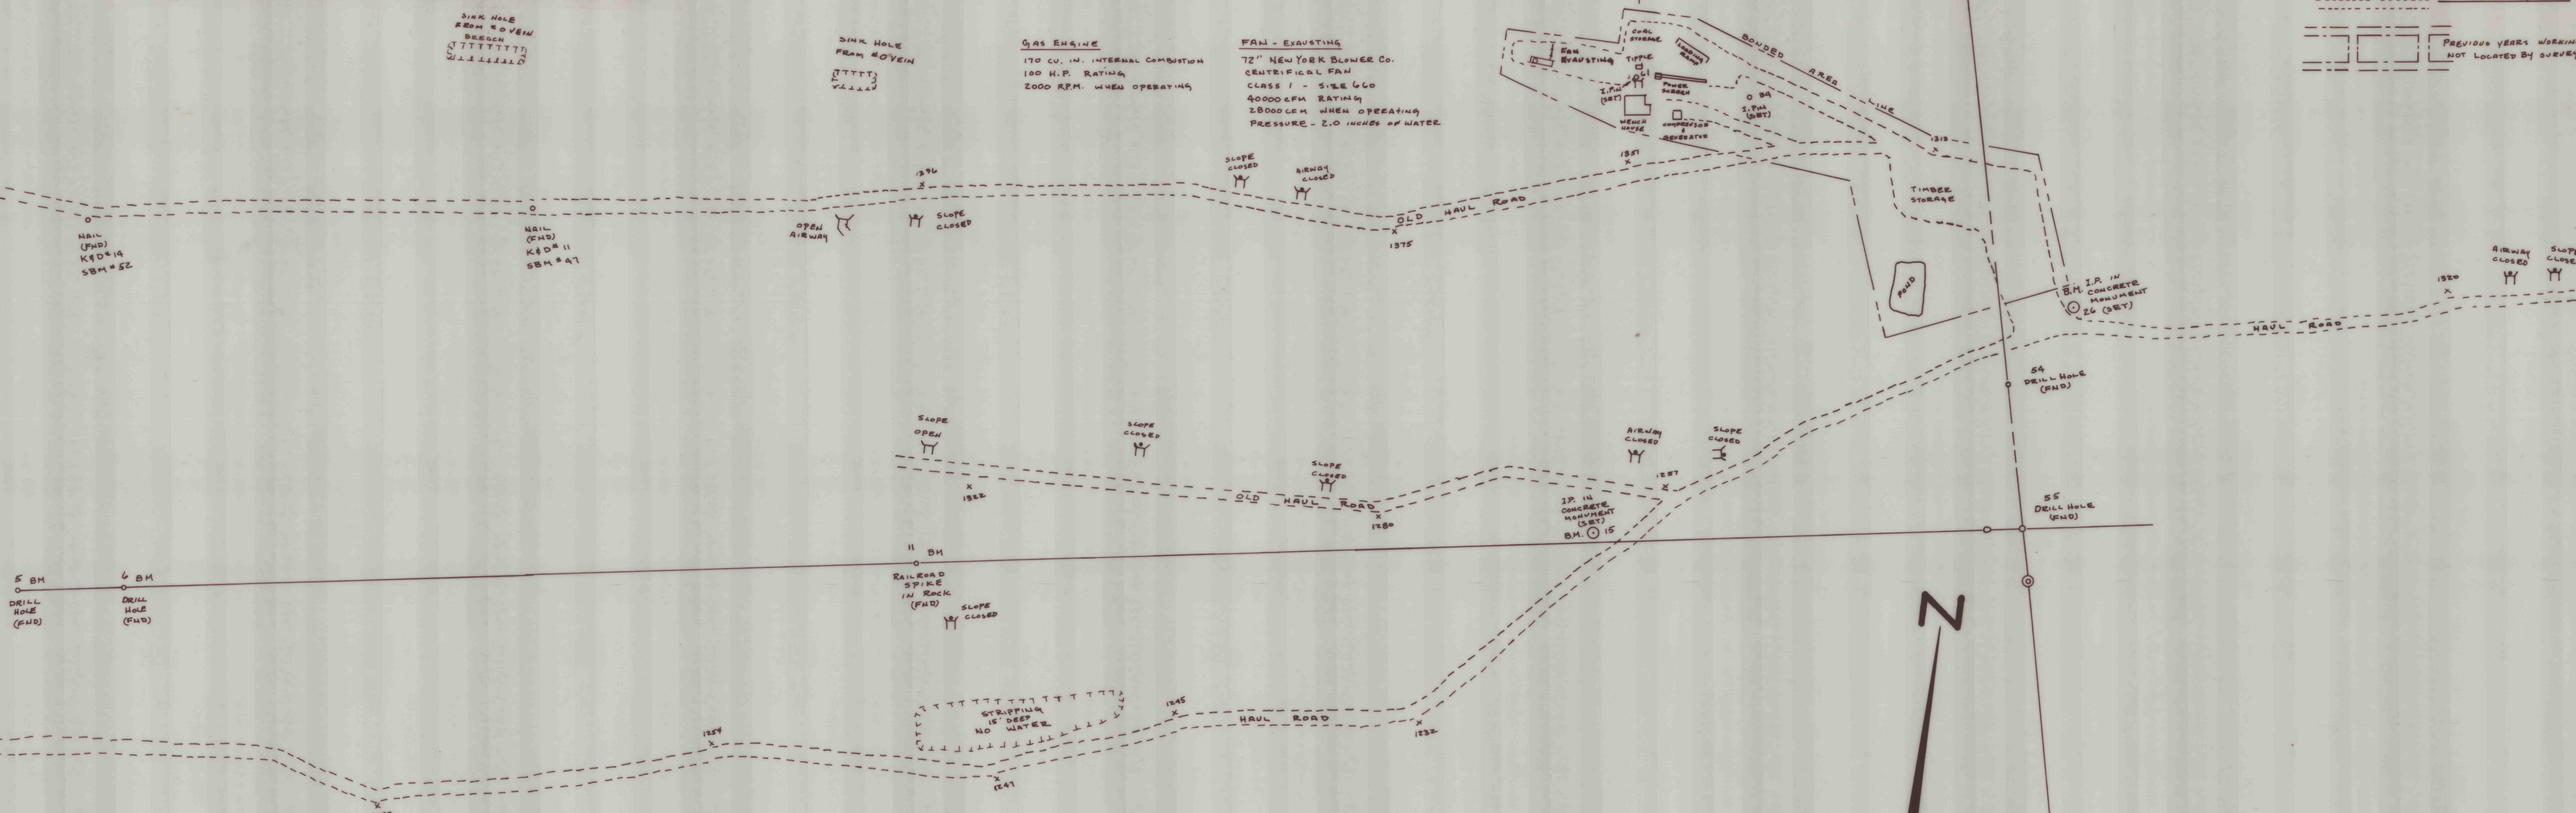


5 BH  
DRILL HOLE  
(PHD)

6 BH  
DRILL HOLE  
(PHD)

PLAN OF  
MINE  
AND  
VENTILATION  
FOR  
S B & M COAL COMPANY  
MSHA I.D. #34-05495  
DER I.D. #49861309T  
R.D. #2  
HEGINS, PA. 17938  
(717) 682-3697  
LOCATED IN  
M & R SLOPE  
NO. ZERO VEIN - SOUTH DIP  
BIG MOUNTAIN  
TOWNSHIP OF ZERBY  
COUNTY OF NORTHUMBERLAND  
COMMONWEALTH OF PENNSYLVANIA  
SCALE: AS NOTED  
DATE: APRIL 30, 1993  
FILE: SBM COAL  
PLAN: #1 OF 6

REVISED: MAY 15, 1994

WARNING: ENTERING OLD WORKINGS MAY BE HAZARDOUS !!

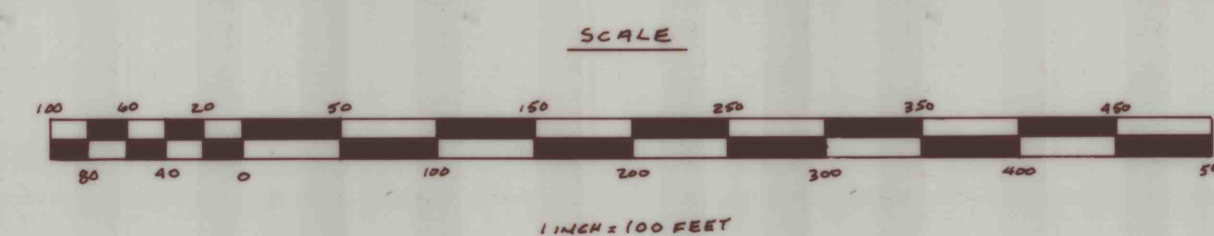

SPECIAL NOTES:

- \* COORDINATES AND ELEVATIONS BASED ON DATUM OF MINE MAP OF CHESTNUT COAL COMPANY BY TAYLOR-DOBECK ASSOCIATES, DATED JUNE 1, 1989, REVISED AUGUST 6, 1992.
- \* VENTILATION INFORMATION SUPPLIED BY MINE OPERATOR.
- \* COAL VEIN INFORMATION SUPPLIED BY MINE OPERATOR.
- \* PROPOSED WORKINGS SUPPLIED BY MINE OPERATOR.

WILLIAM J. MESSNER, P.L.S.  
R.D. #1 BOX 1523  
HERNDON, PA. 17930  
(717) 758-9266  
SU-28849-E

*William J. Messner*

RECEIVED

JUN 1 1994  
U.S. DEPT. OF LABOR  
BUREAU OF MINES  
SHANOKA, PA.

RECEIVED

JUN 1 1994  
U.S. DEPT. OF LABOR  
BUREAU OF MINES  
SHANOKA, PA.