




SCALE

SURFACE HORIZONTAL & VERTICAL CONTROL DATA				
STA.	NORTH	EAST	ELEV.	DESCRIPTION
5	4884.53	4242.45	1299.5	DRILL HOLE
6	4902.38	4360.30	1294.4	DRILL HOLE
11	5037.41	5245.66	1304.5	RAILROAD
15	5162.63	5999.44	1247.1	1. PIN IN
26	5482.95	6507.36	1300.4	1. PIN IN
34	5677.76	6114.76	1321.7	1. PIN
61	5686.77	5985.65	1316.6	1. PIN
47	5387.55	4766.72	1395.5	NAIL
52	5313.32	4269.29	1393.5	NAIL

OLD MINE MAPS:

- * NO OTHER MINE MAPS HAVE BEEN DISCOVERED.
- * ANY FUTURE MINE MAP DISCOVERY WILL BE ADDED AT SUCH TIME.
- * NO CERTIFICATION IS EXPRESSED OR IMPLIED AS TO THE ACCURACY, EXISTENCE OR NONEXISTENCE OF THE WORKINGS OF OLD MINE MAPS.

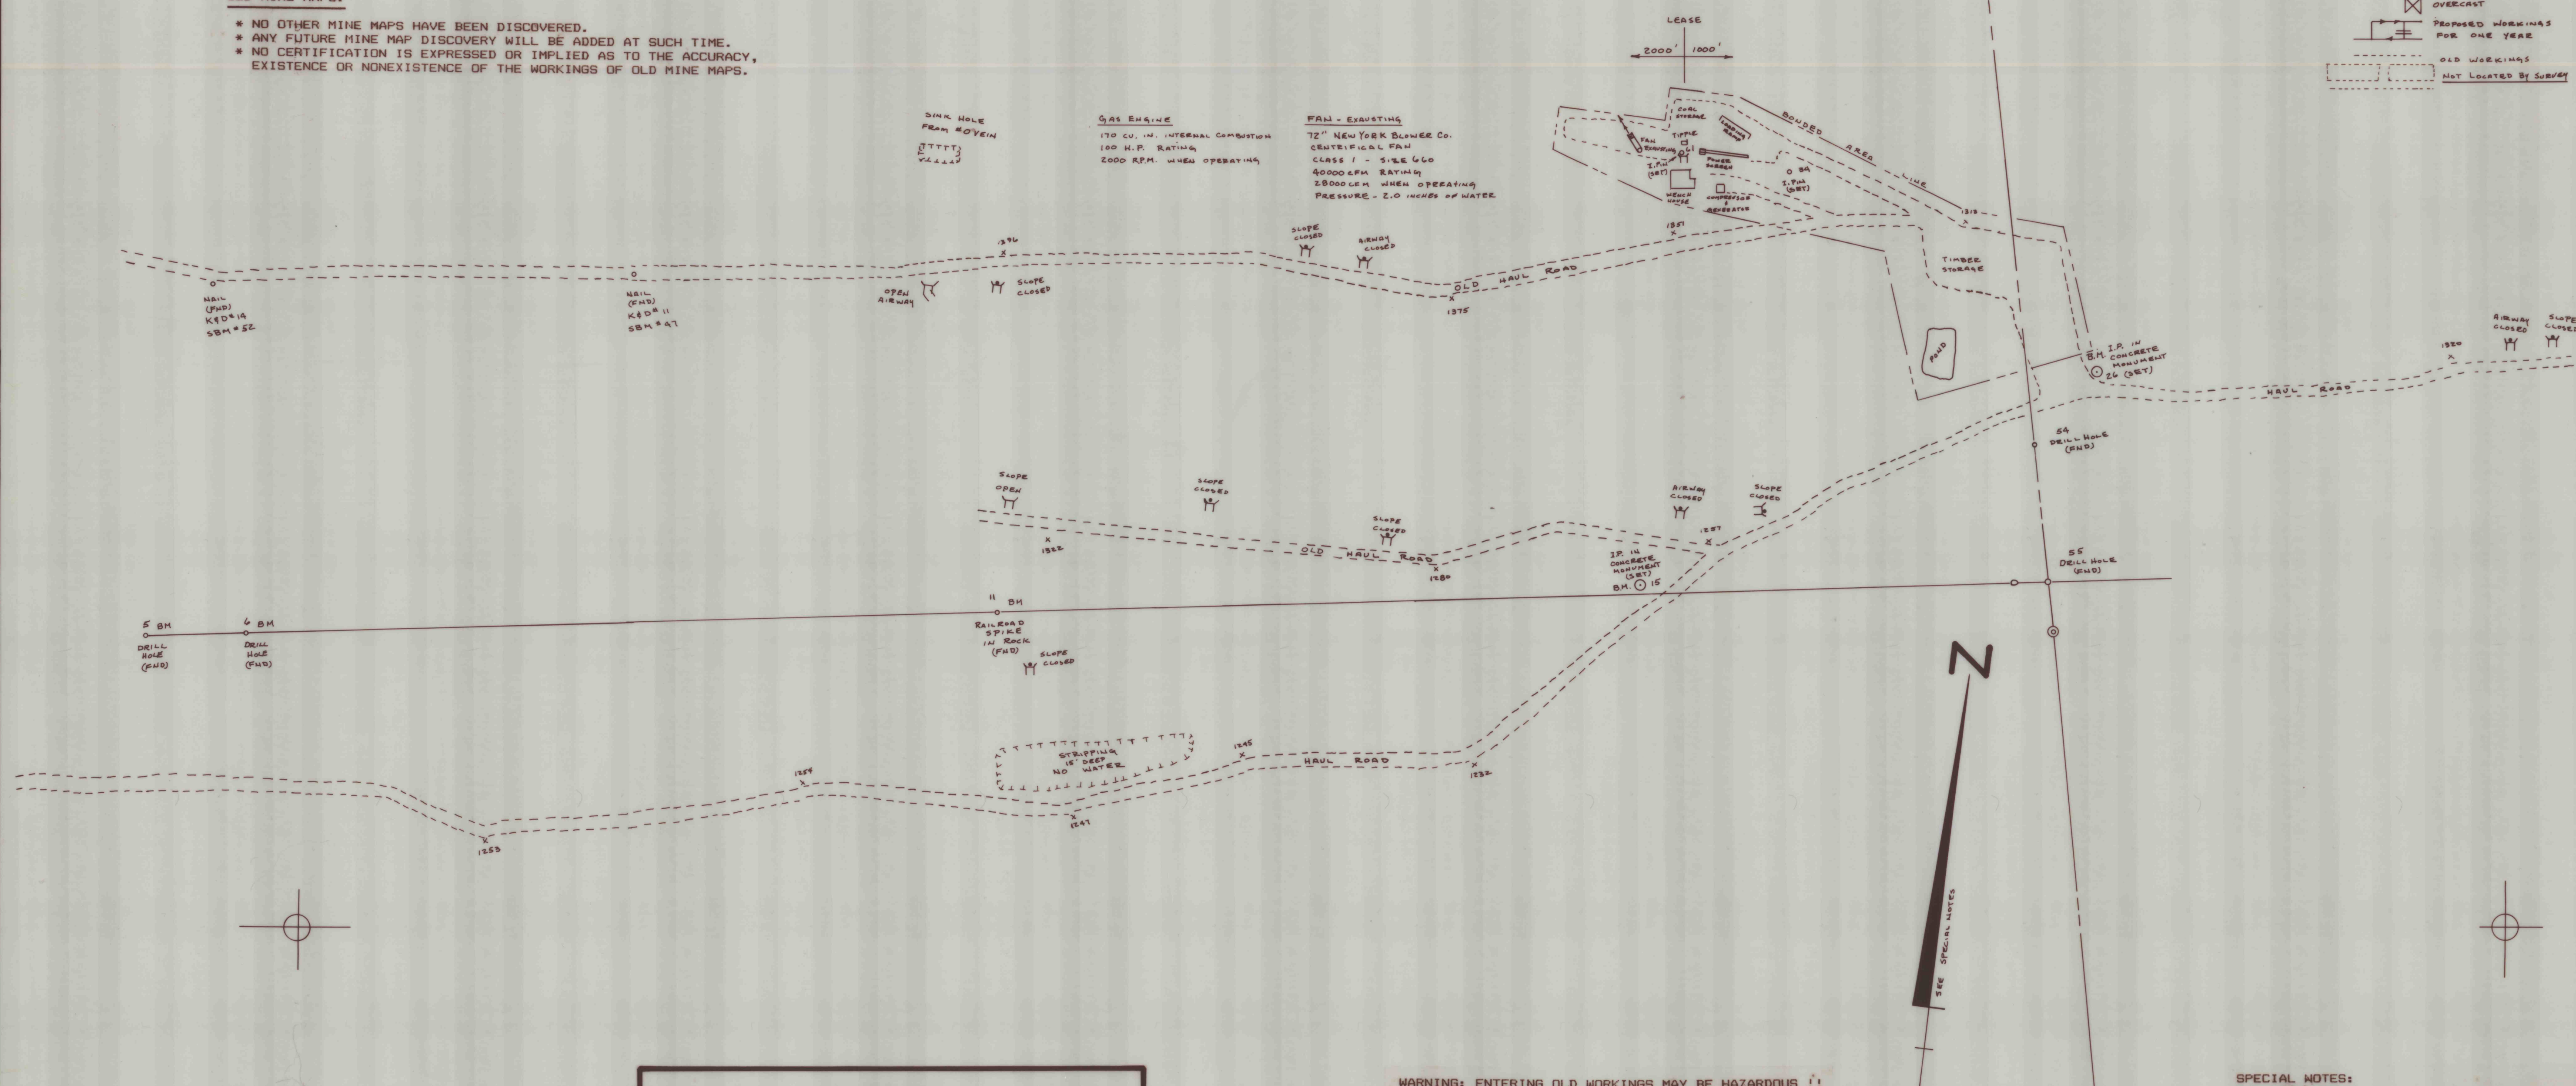


WARNING: ENTERING OLD WORKINGS MAY BE HAZARDOUS !!

SPECIAL NOTES:

- * COORDINATES AND ELEVATIONS BASED ON DATUM OF MINE MAP OF CHESTNUT COAL COMPANY BY TAYLOR-DOBECK ASSOCIATES, DATED JUNE 1, 1989, REVISED AUGUST 6, 1992.
- * VENTILATION INFORMATION SUPPLIED BY MINE OPERATOR.
- * COAL VEIN INFORMATION SUPPLIED BY MINE OPERATOR.
- * PROPOSED WORKINGS SUPPLIED BY MINE OPERATOR.

WILLIAM J. MESSNER, P.L.S.
R.D. #1 BOX 1523
HERNDON, PA. 17830
(717) 758-9266
SU-28849-E

PLAN OF
MINE
AND
VENTILATION
FOR
S B & M COAL COMPANY
MSHA I.D. #36-05495
DER I.D. #49861309T
R.D. #2
HEGINS, PA. 17938
(717) 682-3697
LOCATED IN
M & R SLOPE
NO. ZERO VEIN - SOUTH DIP
BIG MOUNTAIN
TOWNSHIP OF ZERBY
COUNTY OF NORTHUMBERLAND
COMMONWEALTH OF PENNSYLVANIA
SCALE: AS NOTED
DATE: APRIL 30, 1993
FILE: SBM COAL
PLAN: #1 OF 6

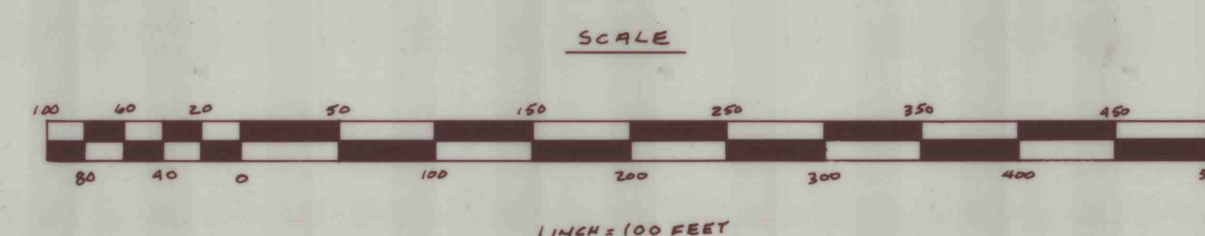

