
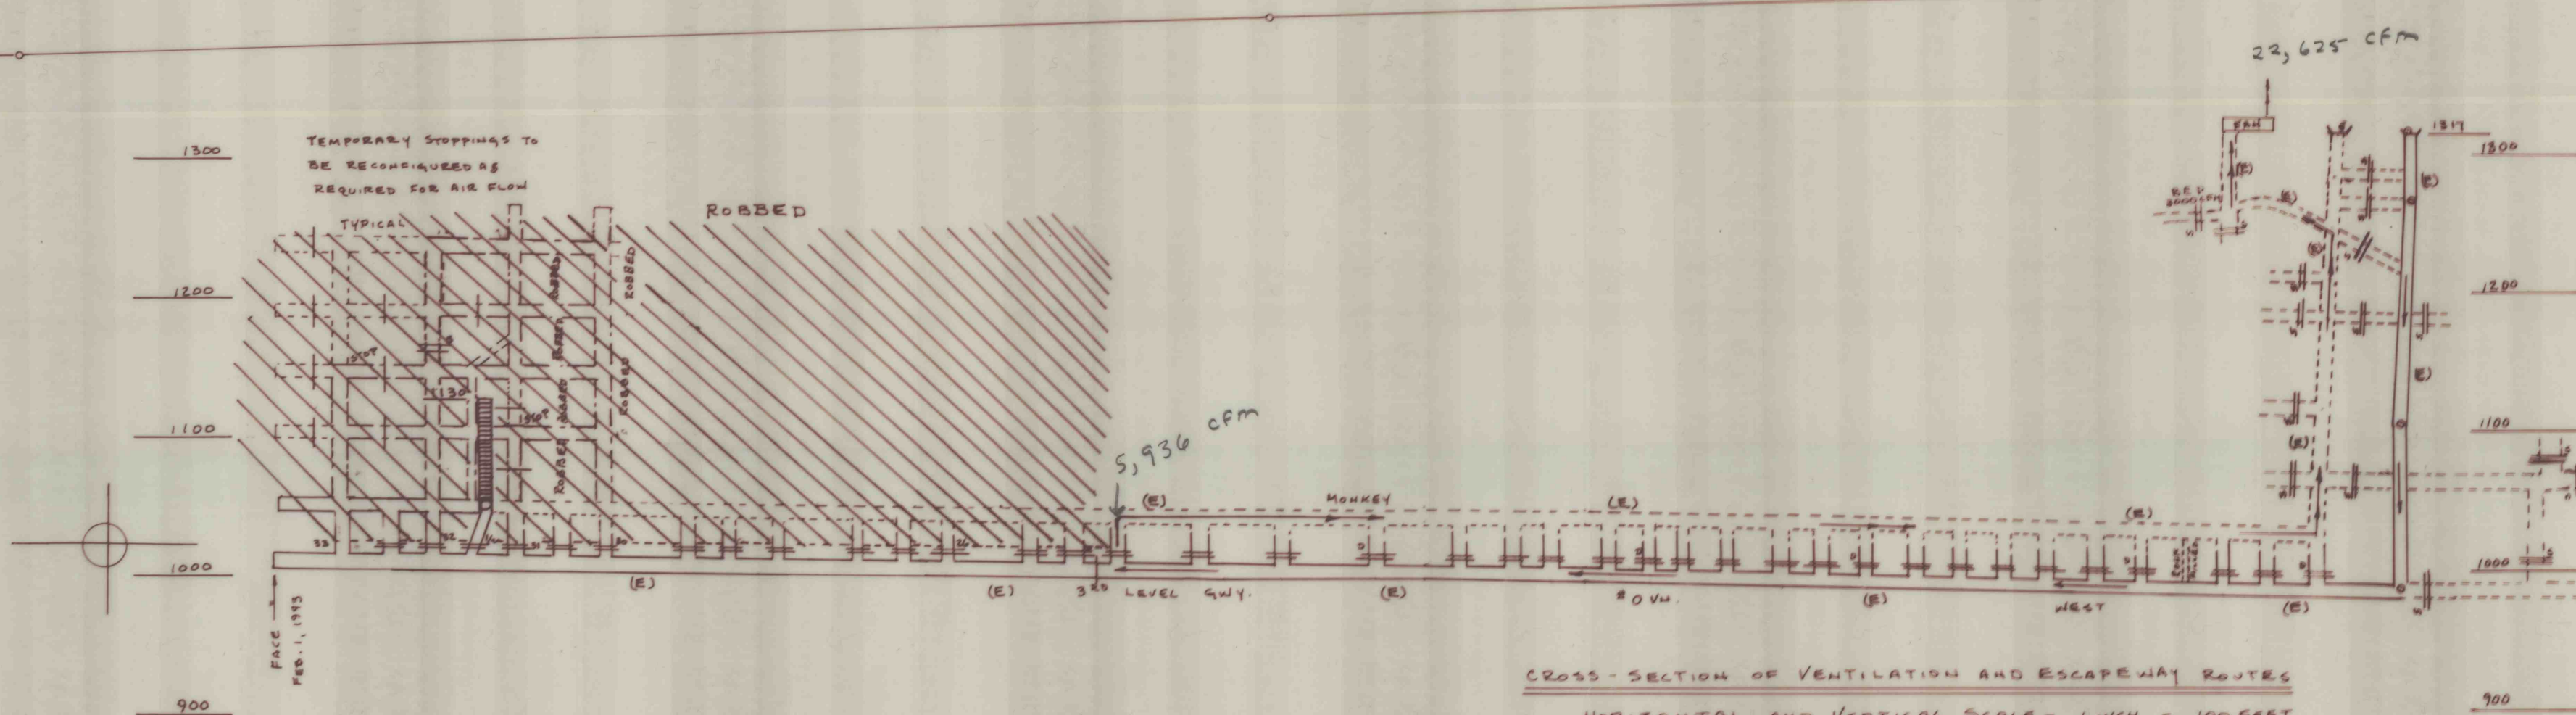


SUBSURFACE HORIZONTAL & VERTICAL CONTROL DATA

STA.	NORTH	EAST	ELEV.	DESCRIPTION
71	5450.12	5995.49	1246.4	SPAD IN CEILING
72	5566.57	5995.46	1106.0	SPAD IN FLOOR
73	5498.14	6005.97	987.7	SPAD IN CEILING
74	5490.71	5765.51	991.7	SPAD IN CEILING
75	5481.79	5557.62	995.9	SPAD IN CEILING
76	5479.98	5415.96	997.9	SPAD IN CEILING
77	5481.73	5506.28	1005.1	SPAD IN CEILING
78	5474.16	5155.35	1005.1	SPAD IN CEILING
79	5471.90	4941.64	1006.2	SPAD IN CEILING
80	5455.59	4561.15	1011.8	SPAD IN CEILING
82	5479.26	4557.24	1053.9	SPAD IN CEILING

ONE YEAR PROJECTION:

- * GANGWAY AND MONKEY HAVE BEEN STOPPED.
- * NO FUTURE EXTENSION OF MINING OF THIS GANGWAY WILL OCCURE.
- * THE MINE WILL ~~REMAIN~~ ROB TOWARD THE SLOPE.

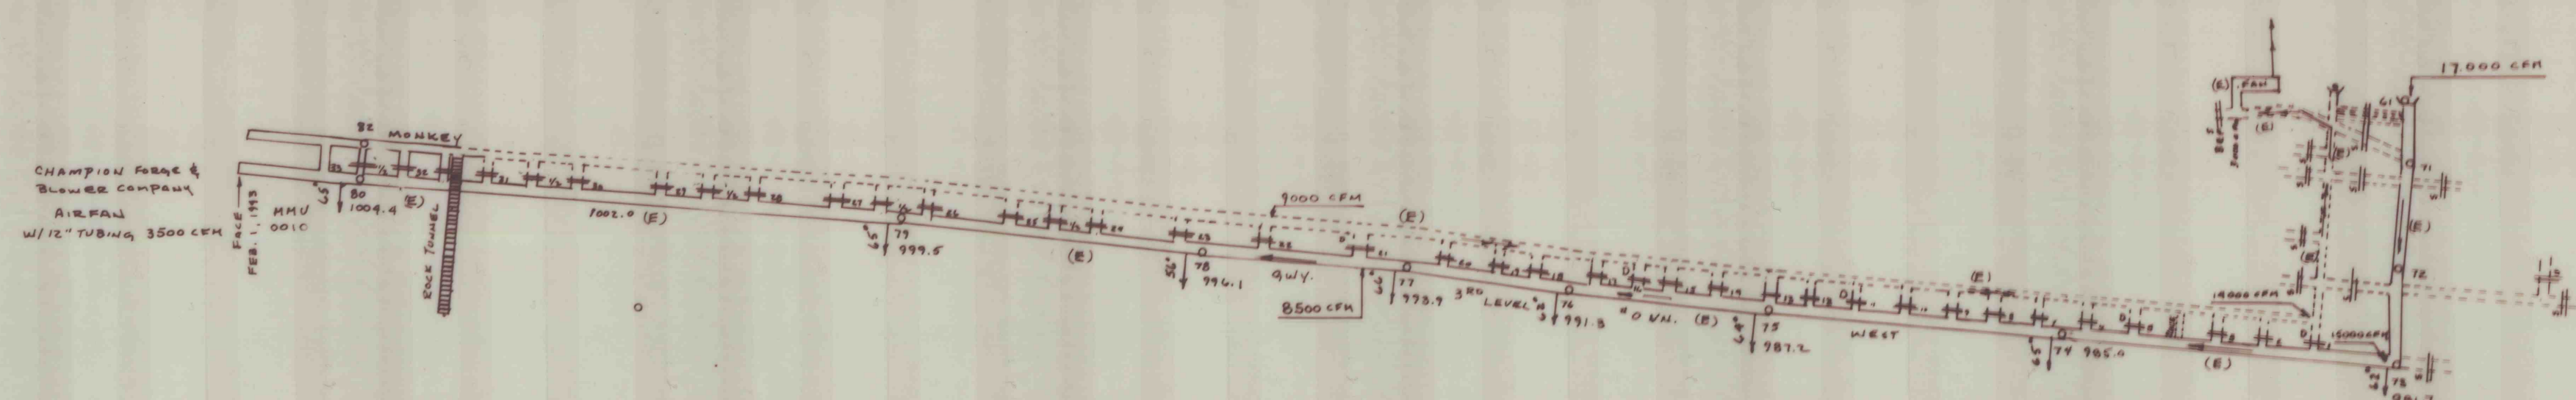

PLAN OF
MINE
AND
VENTILATION
FOR
S B & M COAL COMPANY
MSHA I.D. #36-05495
DER I.D. #49861309T
R.D. #2
HEGINS, PA. 17938
(717) 682-3697
LOCATED IN
M & R SLOPE
NO. ZERO VEIN - SOUTH DIP
BIG MOUNTAIN
TOWNSHIP OF ZERBY
COUNTY OF NORTHUMBERLAND
COMMONWEALTH OF PENNSYLVANIA
SCALE: AS NOTED
DATE: APRIL 30, 1993
FILE: SBM COAL
PLAN: #2 OF 6

WILLIAM J. MESSNER, P.L.S.
R.D. #1 BOX 1523
HERNDON, PA. 17830
(717) 758-9266
SU-28849-E

William J. Messner

REVISED: MAY 5, 1994
JAN 26, 1996

RECEIVED

FEB 5 1996

U.S. DEPT. OF LABOR
MSHA
WILKES-BARRE, PA.

RECEIVED

FEB 24 1996

U.S. DEPT. OF LABOR
MSHA
WILKES-BARRE, PA.