

2852



SCALE
1 INCH = 2000 FEET

OLD MINE MAPS:
* NO OTHER MINE MAPS HAVE BEEN DISCOVERED.
* ANY FUTURE MINE MAP DISCOVERY WILL BE ADDED AT SUCH TIME.
* NO CERTIFICATION IS EXPRESSED OR IMPLIED AS TO THE ACCURACY, EXISTENCE OR NONEXISTENCE OF THE WORKINGS OF OLD MINE MAPS.

WARNING: ENTERING OLD WORKINGS MAY BE HAZARDOUS!

SPECIAL NOTES:

- * COORDINATES AND ELEVATIONS BASED ON DATUM OF MINE MAP OF K&L COAL COMPANY BY TAYLOR-DOBECK ASSOCIATES, JUNE 12, 1992.
- * VENTILATION INFORMATION SUPPLIED BY MINE OPERATOR.
- * COAL VEIN INFORMATION SUPPLIED BY MINE OPERATOR.
- * PROPOSED WORKINGS SUPPLIED BY MINE OPERATOR.


SURFACE HORIZONTAL & VERTICAL CONTROL DATA

STA.	NORTH	EAST	ELEV.	DESCRIPTION
46	1749.99	-4955.12	1272.4	1. PIN IN CONCRETE
47	1882.45	-4920.32	1276.2	DRILL HOLE
51	1709.10	-4942.72	1275.2	1. PIN IN CONCRETE
53	1759.34	-7042.27	1286.4	DRILL HOLE
57	1602.44	-7071.40	1423.0	DRILL HOLE
72	1576.76	-71006.19	1431.9	DRILL HOLE
76	1788.45	-49560.24	1261.7	1. PIN
141	1432.58	-72205.67	1411.9	MAIL
142	1505.99	-72214.79	1380.3	MAIL
144	1507.14	-72341.32	1360.4	DRILLHOLE

LEGEND

- (E) ESCAPEMENT
- (F) FALL - EXHAUSTING
- (T) TRAVERSE
- (X) SPOT ELEVATION
- (D) DEPRESSION
- TENTATIVE AIR BATTERIES
- 2" PLUMB AIR BATTERIES (PERMANENT)
- 1" PLUMB AIR BATTERIES WITH OARS
- DIRECTION OF AIRFLOW IN
- DIRECTION OF AIRFLOW OUT
- C.F.M. CUBIC FEET PER MINUTE
- OPEN SLOPE
- CLOSED SLOPE
- OVERCAST
- ANY REMAINS
- V.M. VEIN
- I.P. ISOLATION
- ELEV. ELEVATION
- H.P. HORSE POWER
- AMP. AMPERES
- PROPOSED WORKINGS FOR ONE YEAR
- OLD WORKINGS NOT LISTED BY SURVEY
- CON. CON. CONCRETE MOUNT
- R.M. REVOLUTIONS PER MINUTE
- B.M. BENCH MARK
- SEAL

To K&L Coal Co.
No. 1 Slope - ZERBY VEIN - SOUTH DIP

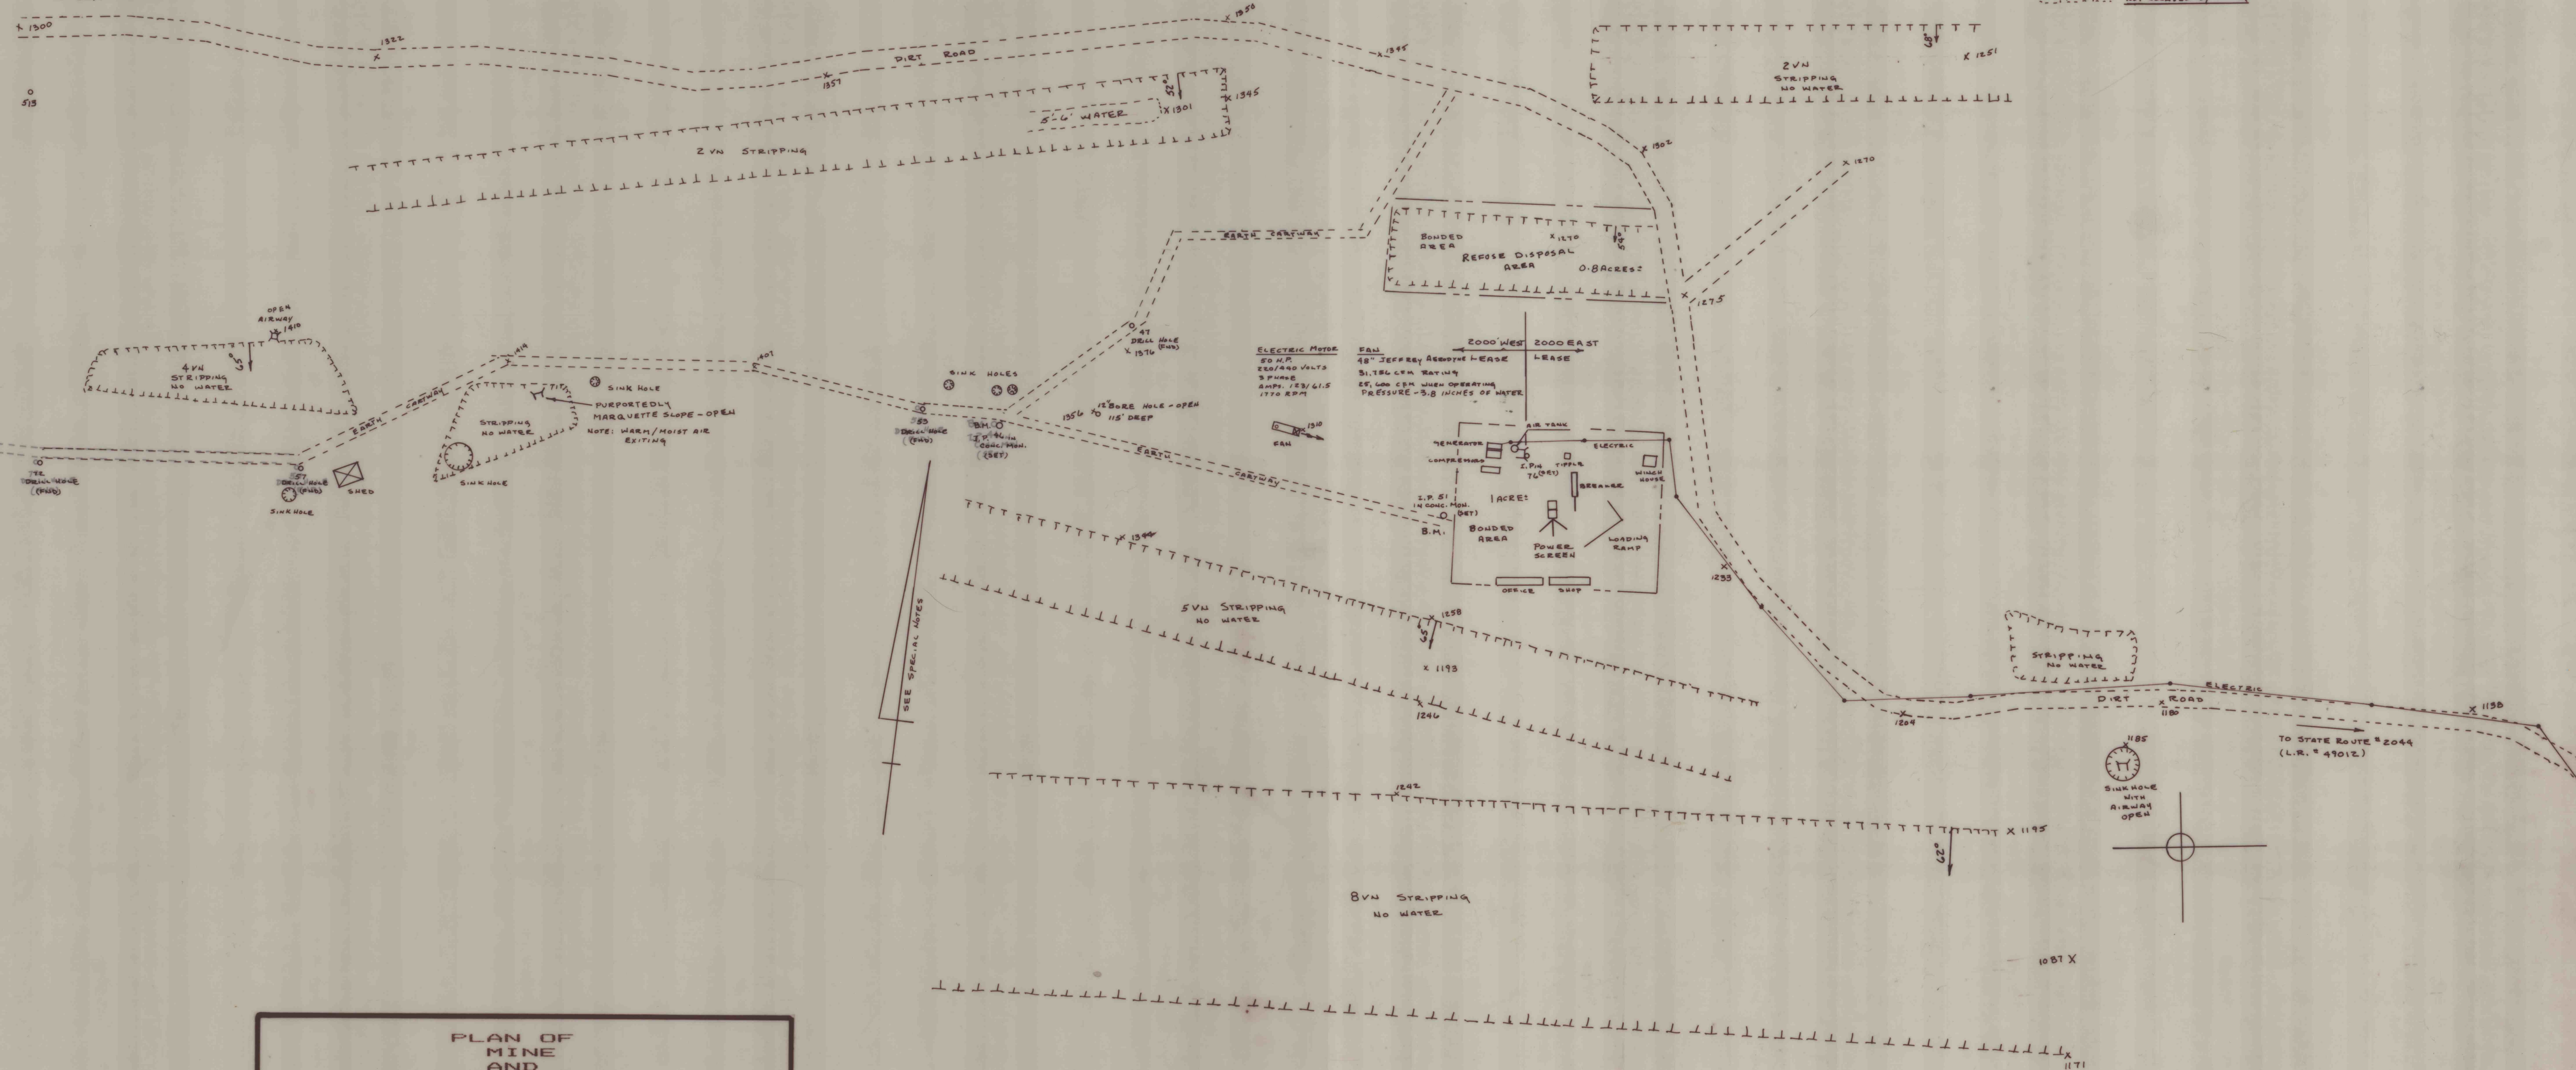

REL

RECEIVED

AUG 17 1993
U.S. DEPT. OF LABOR
MINE SAFETY AND HEALTH
WILKES-BARRE, PA.

WILLIAM J. MESSNER, P.L.S.
R.D. #1 BOX 1523
HERNDON, PA. 17830
(717) 758-9266
SU-28849-E

William J. Messner

PLAN OF MINE AND VENTILATION FOR SNYDER COAL COMPANY
MSHA I.D. #36-02203
DER I.D. #49861303R
R.D. #2 BOX 464
HEGINS, PA. 17938
(717) 682-9698
LOCATED IN N. AND L. SLOPE NO. 4 & 5 VEINS - SOUTH DIP BIG MOUNTAIN TOWNSHIP OF ZERBY COUNTY OF NORTHUMBERLAND COMMONWEALTH OF PENNSYLVANIA
SCALE: AS NOTED
DATE: JANUARY 5, 1993
FILE: SNYDER COAL PLAN #14 OF 8

REVISED: MARCH 15, 1994
AUGUST 8, 1995

