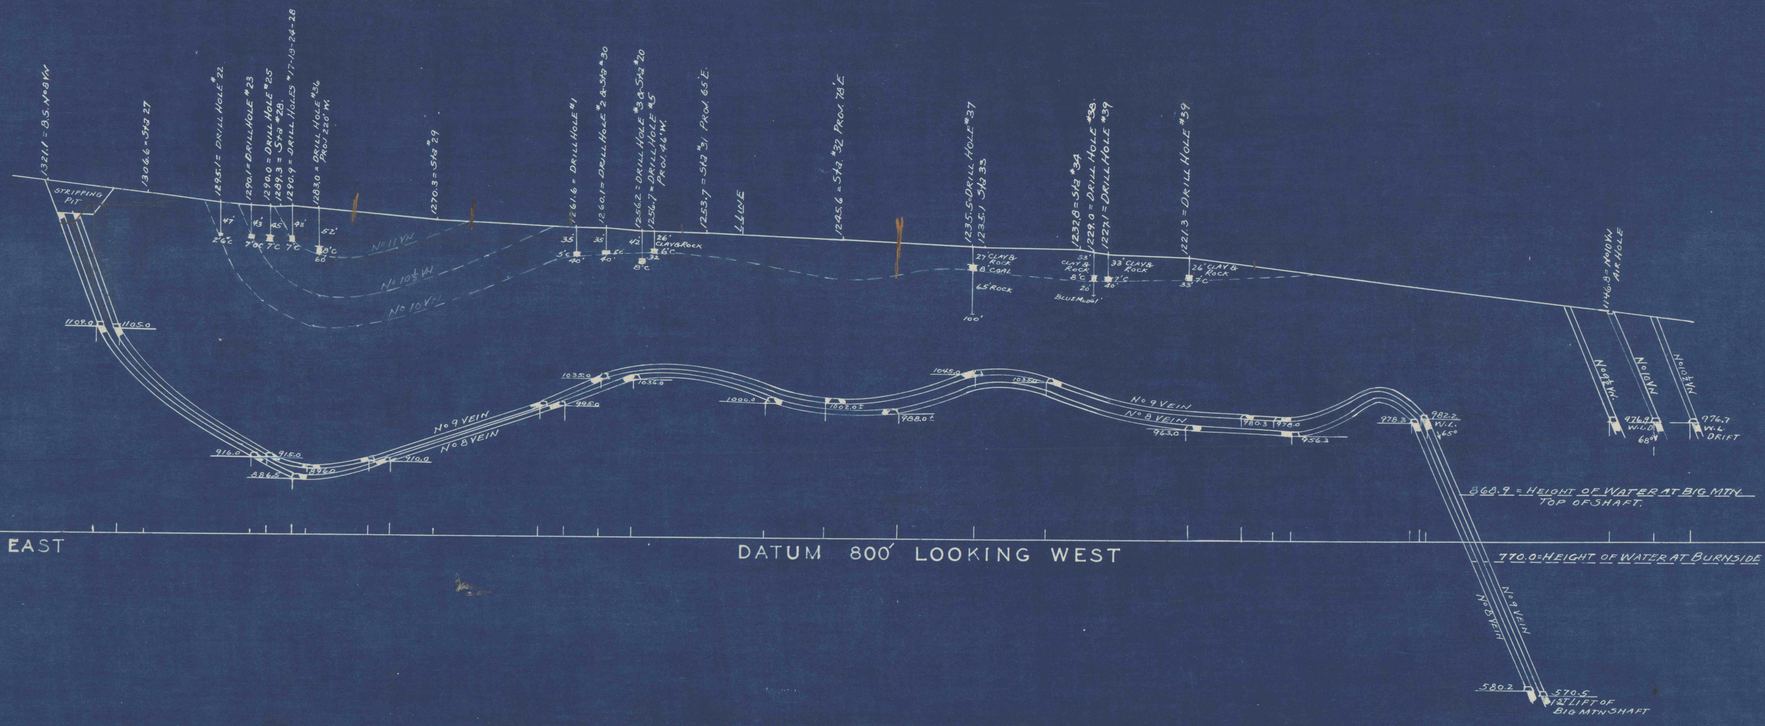
BASE LINE "O" N&S
STRIPPING PIT
No 11 VEIN
No 10 VEIN
No 9 VEIN
No 8 VEIN
No 9 VEIN
No 8 VEIN
No 9 VEIN
No 8