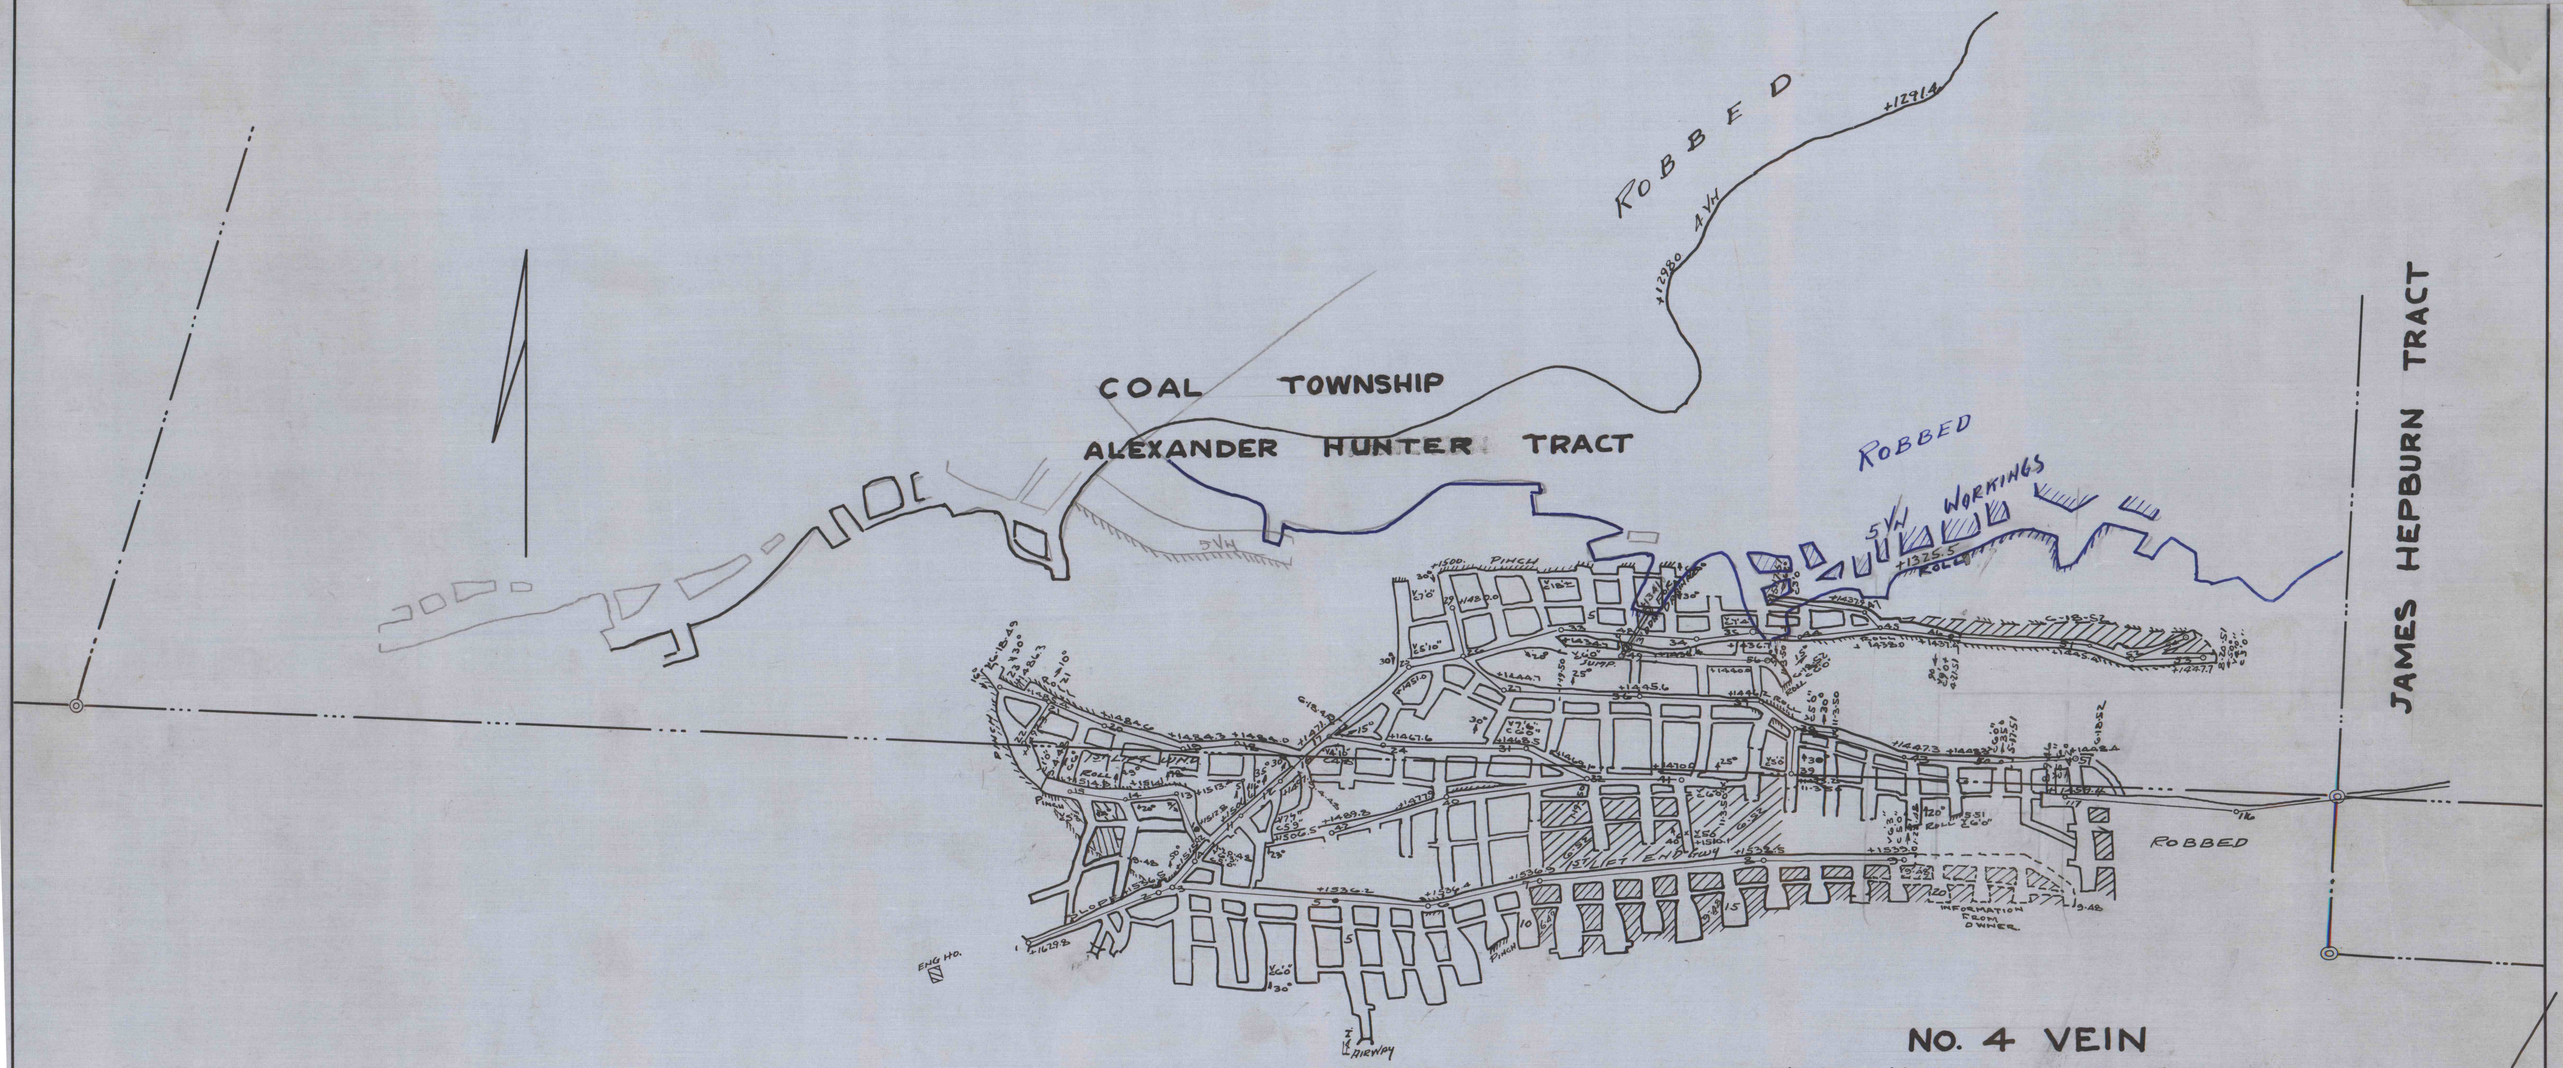

ALEXANDER HUNTER TRACT

WEST CAMERON TOWNSHIP

NO. 4 VEIN
MAP SHOWING MINE WORKINGS OF DANIEL . R. LATSHA

SCALE 1" = 100'

LAWRENCE. G. LEBO
REG SURVEYOR
SHAMOKIN, PA