


JAMES HEPBURN TRACT

COAL TOWNSHIP
ALEXANDER HUNTER TRACT

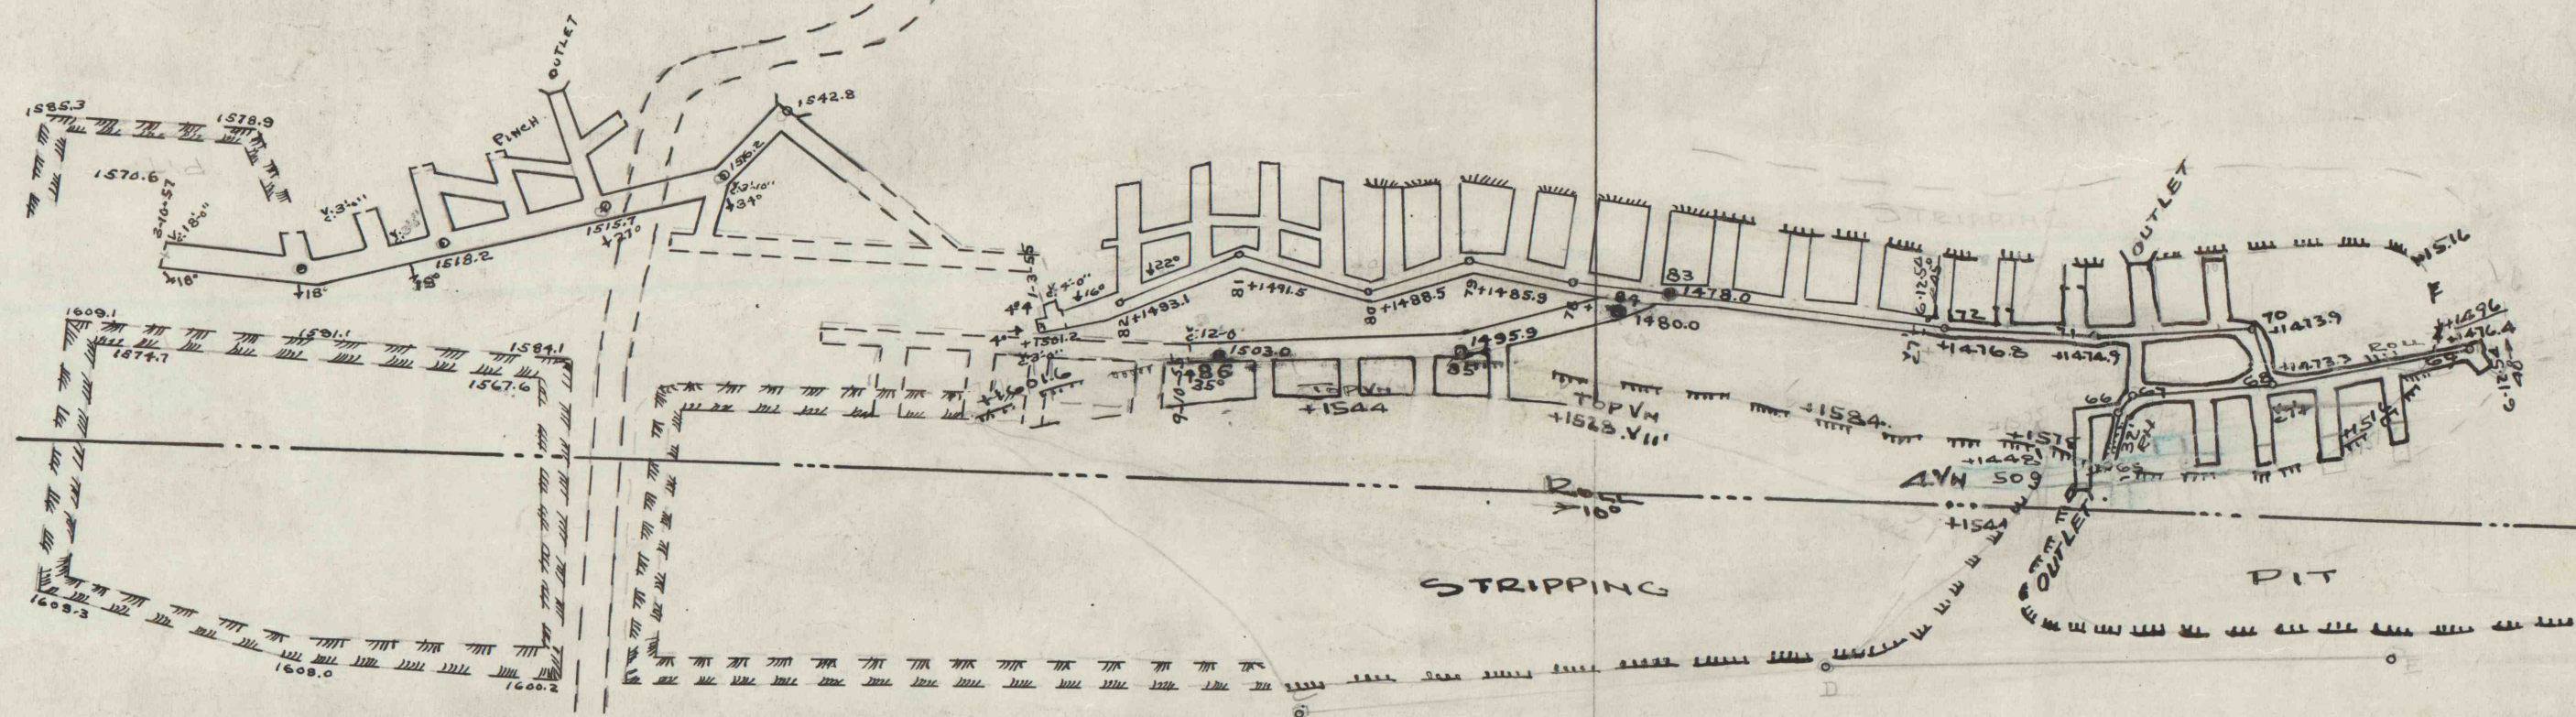

ALEXANDER HUNTER TRACT
WEST CAMERON TOWNSHIP

NO 5 VEIN
MAP SHOWING MINE WORKINGS
OF
ANDREW BOSLEGO
SCALE 1"=100'

EAST CAMERON TOWNSHIP