


ENTERPRISE COLLIERY

M^cINTYRE TRACT

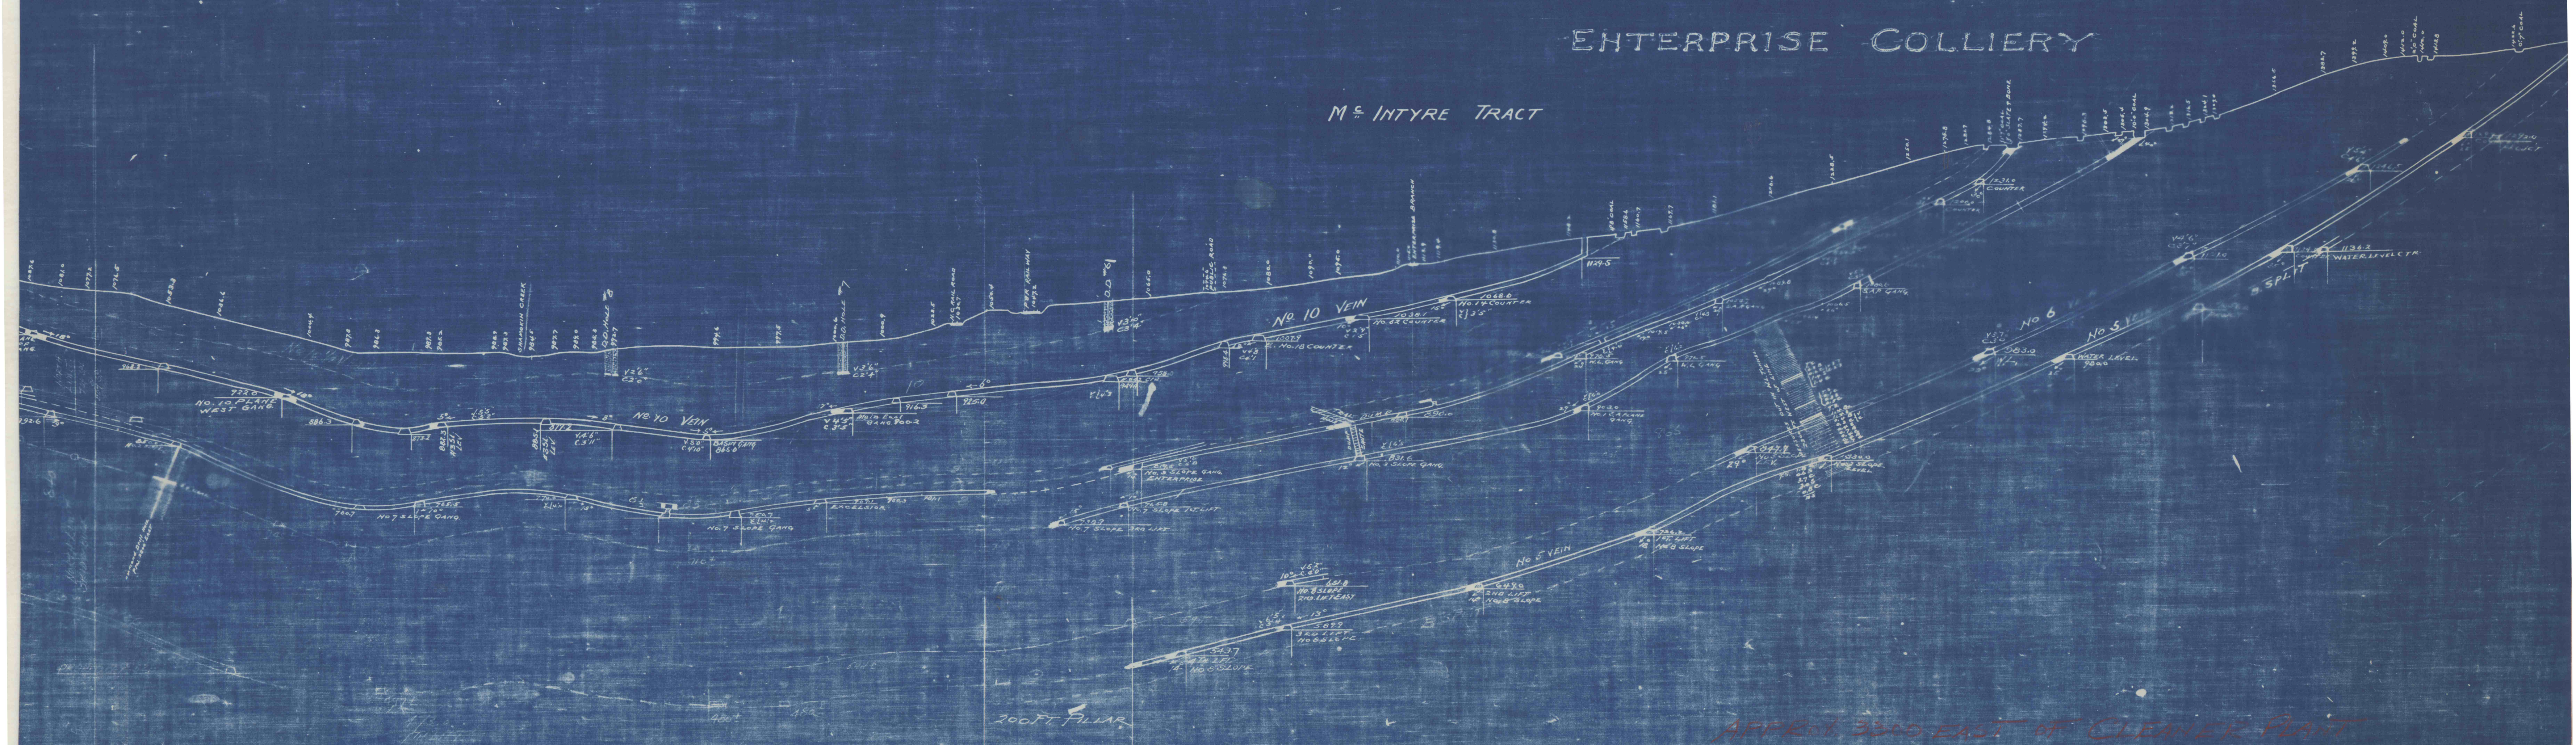

APPROX 3500 EAST OF CLEANER PLANT

Looking East