


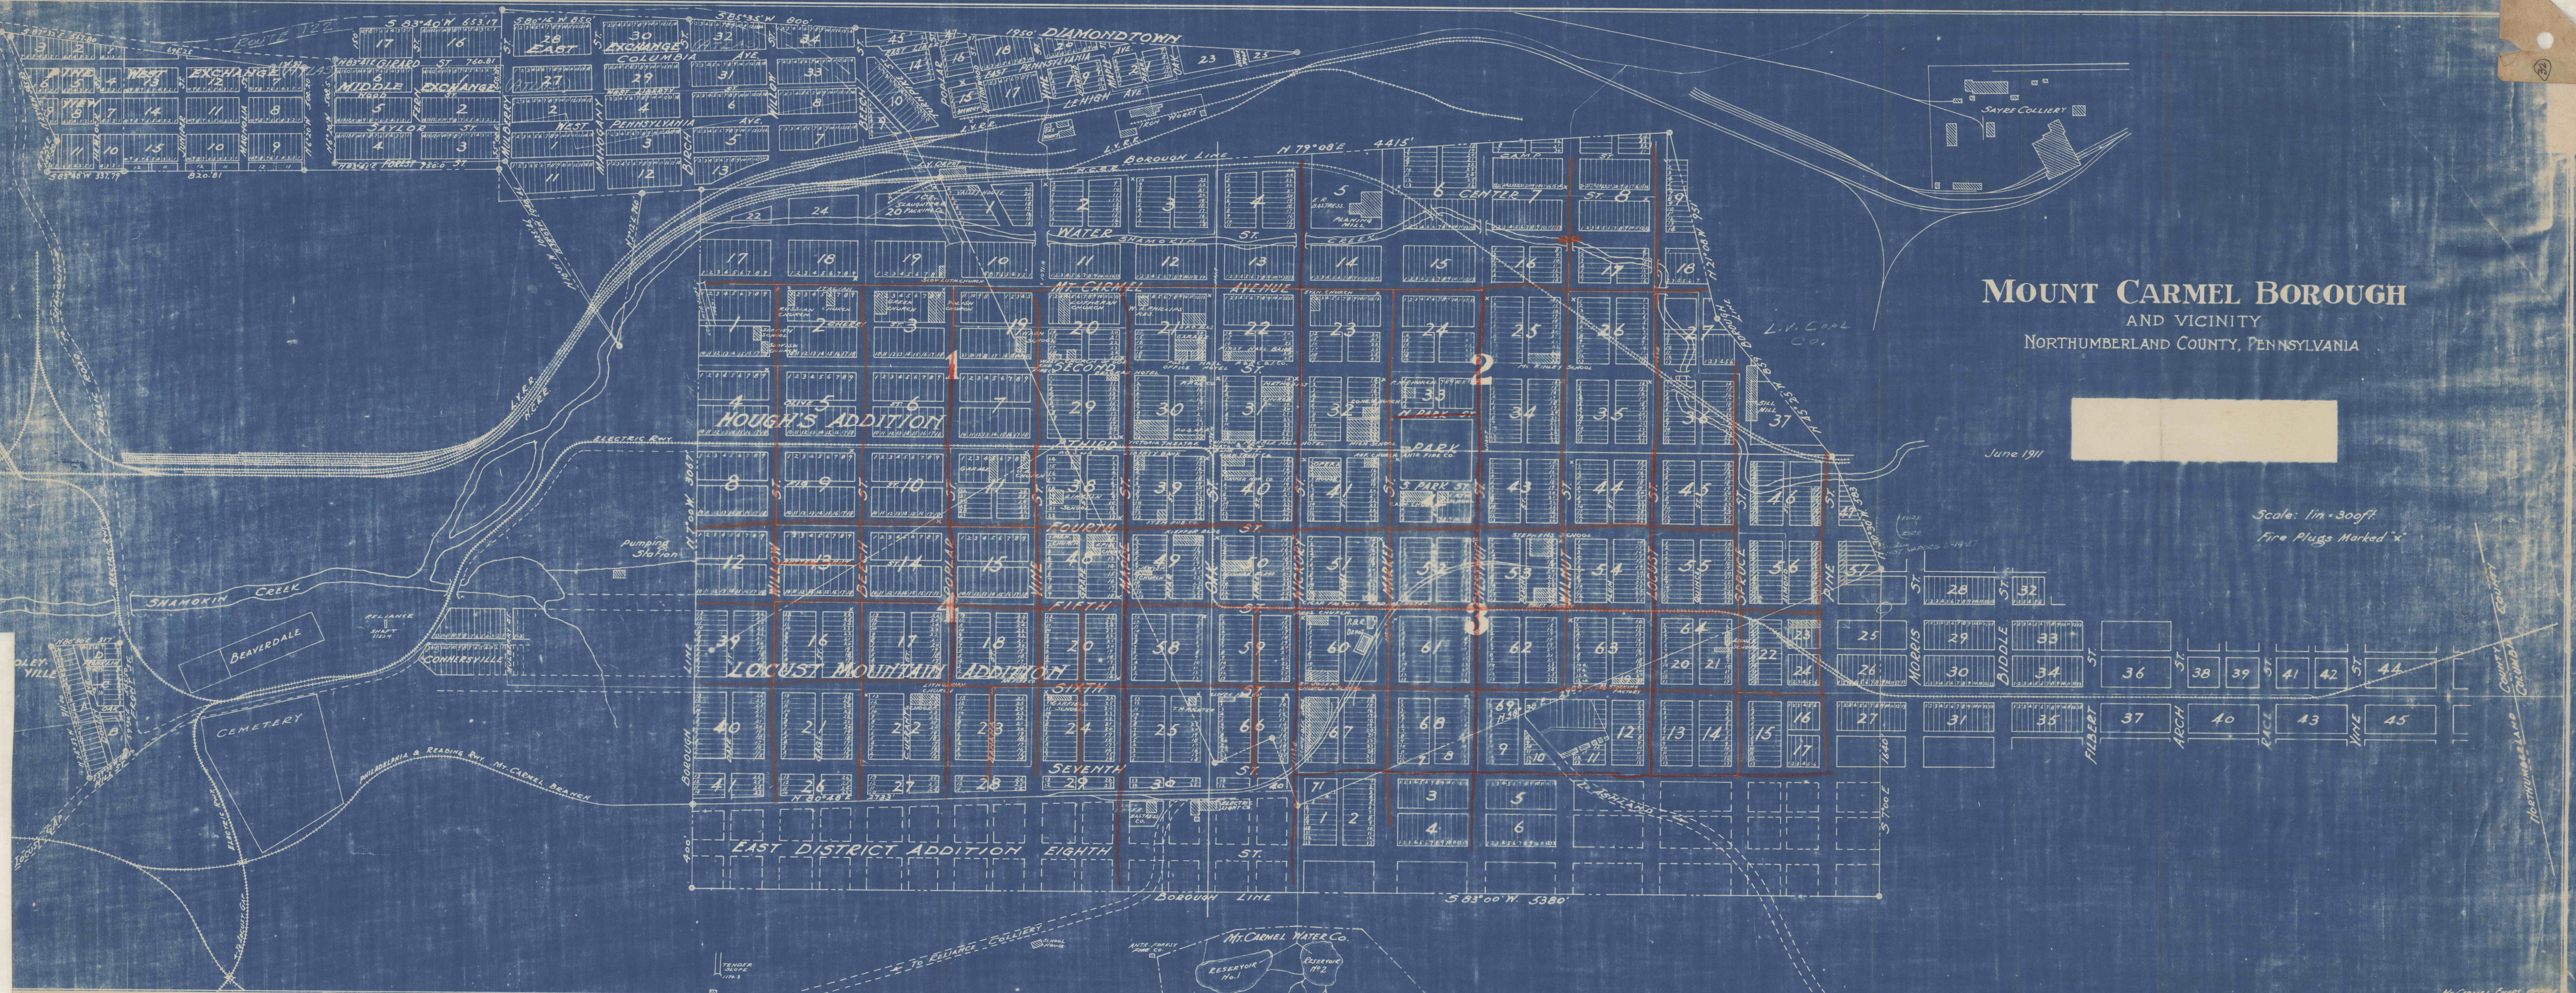

MOUNT CARMEL BOROUGH
AND VICINITY
NORTHUMBERLAND COUNTY, PENNSYLVANIA

June 1911

Scale: 1 in = 300 ft.
Fire Plugs Marked "x"