


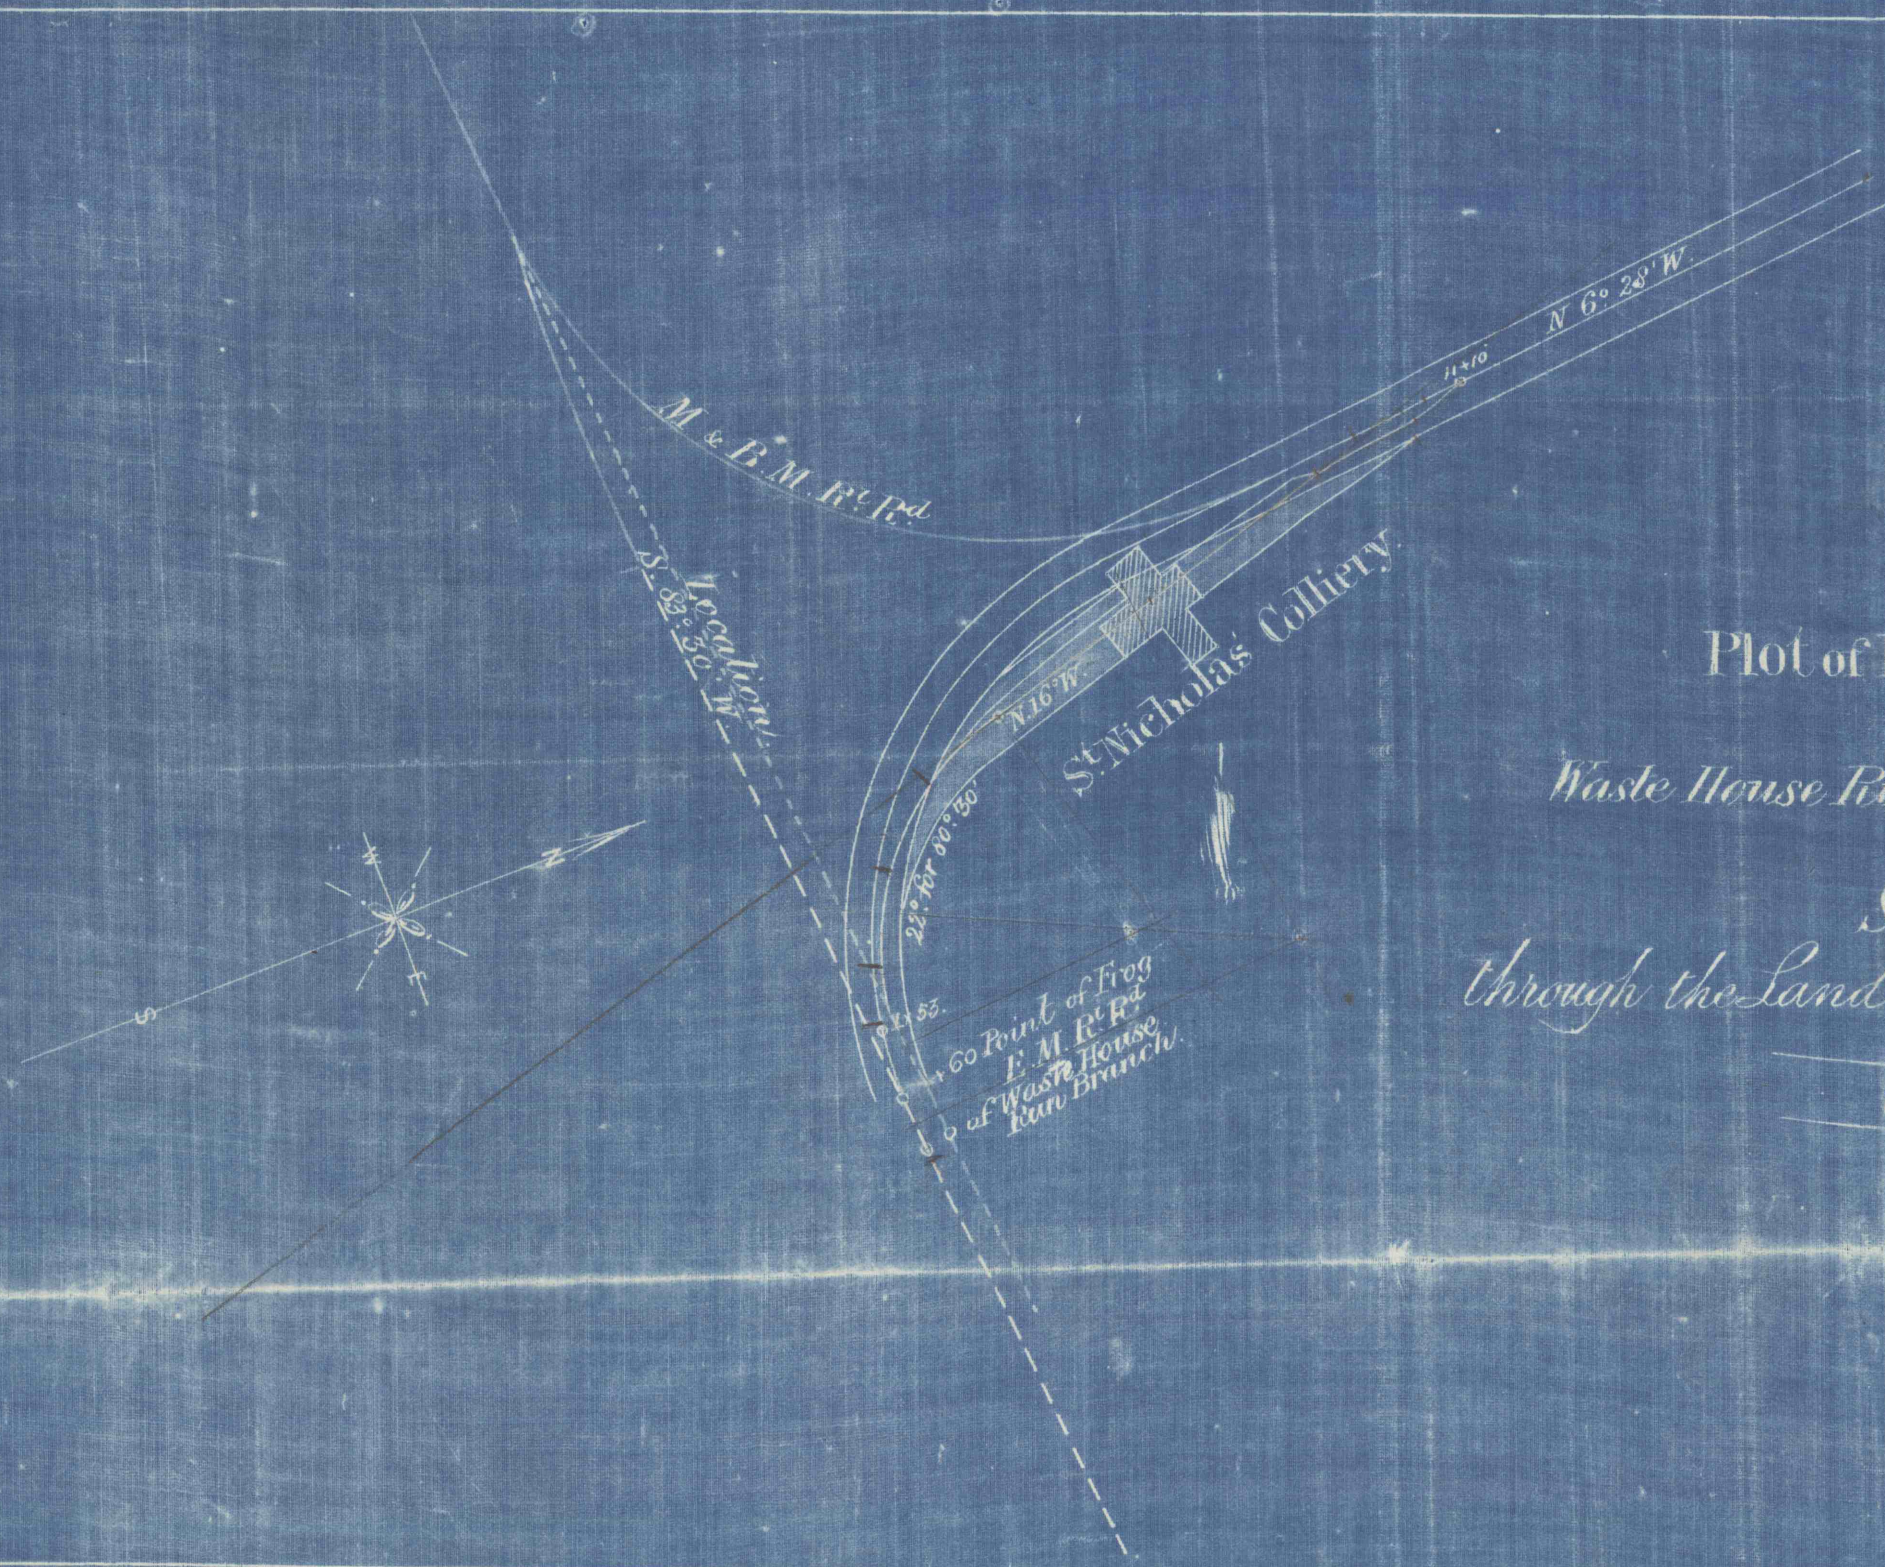

Plot of Right of Way of a Lateral
 from
 Waste House Run Branch of the M & B. M. R. R.
 to the
 St. Nicholas Colliery
 through the Land of the Philadelphia & Mahanoy Coal Co.

Scale: 200 ft to 1 Inch.

Signed } Correct
 Frank Carter