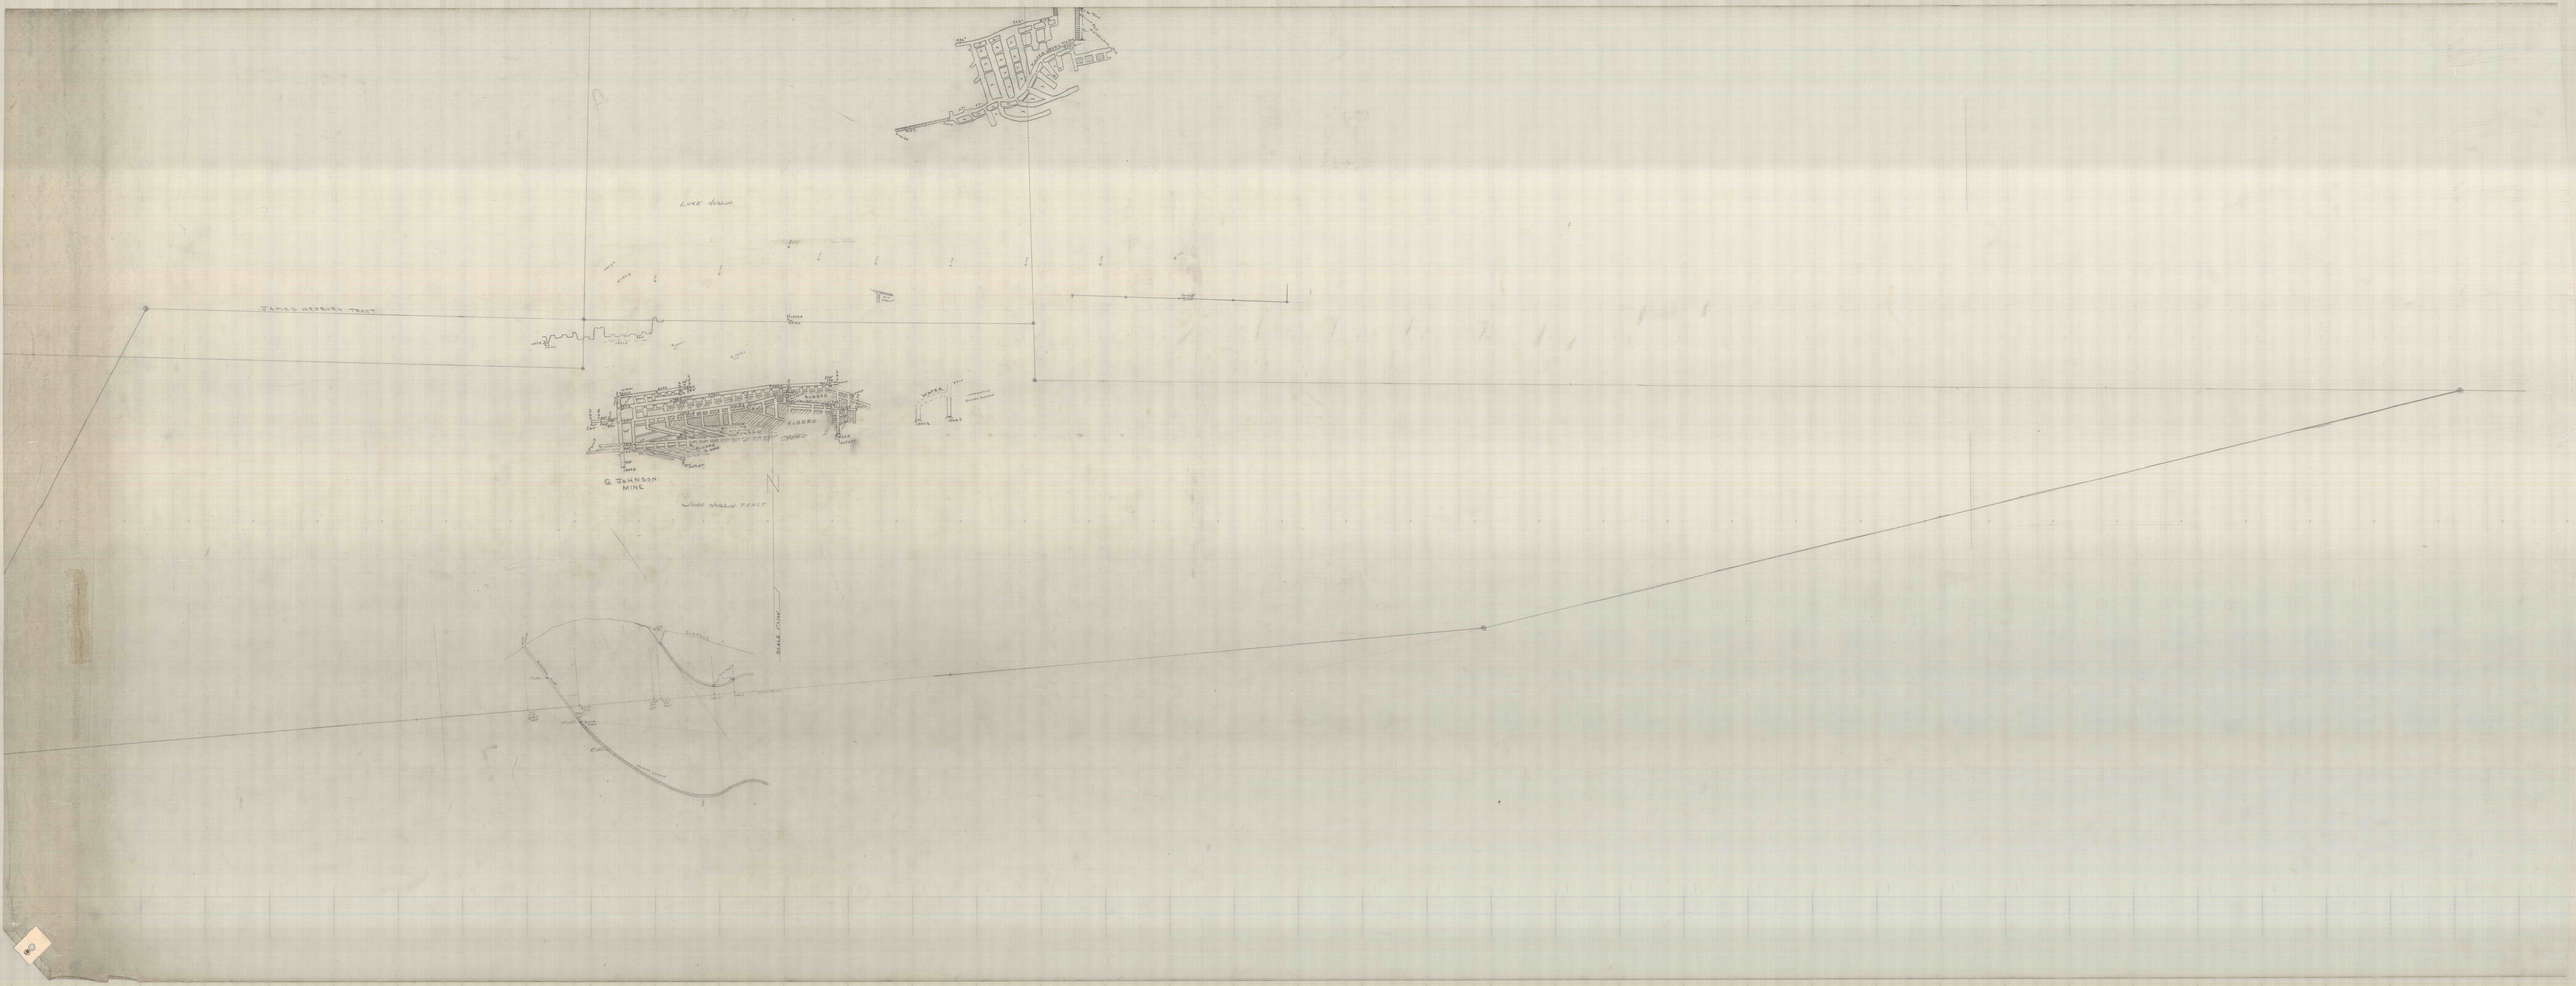
JAMES HEPBURN TRACT
G. JOHNSON MINE
JOHN HOGAN TRACT
SCALE 1" = 100'
N