



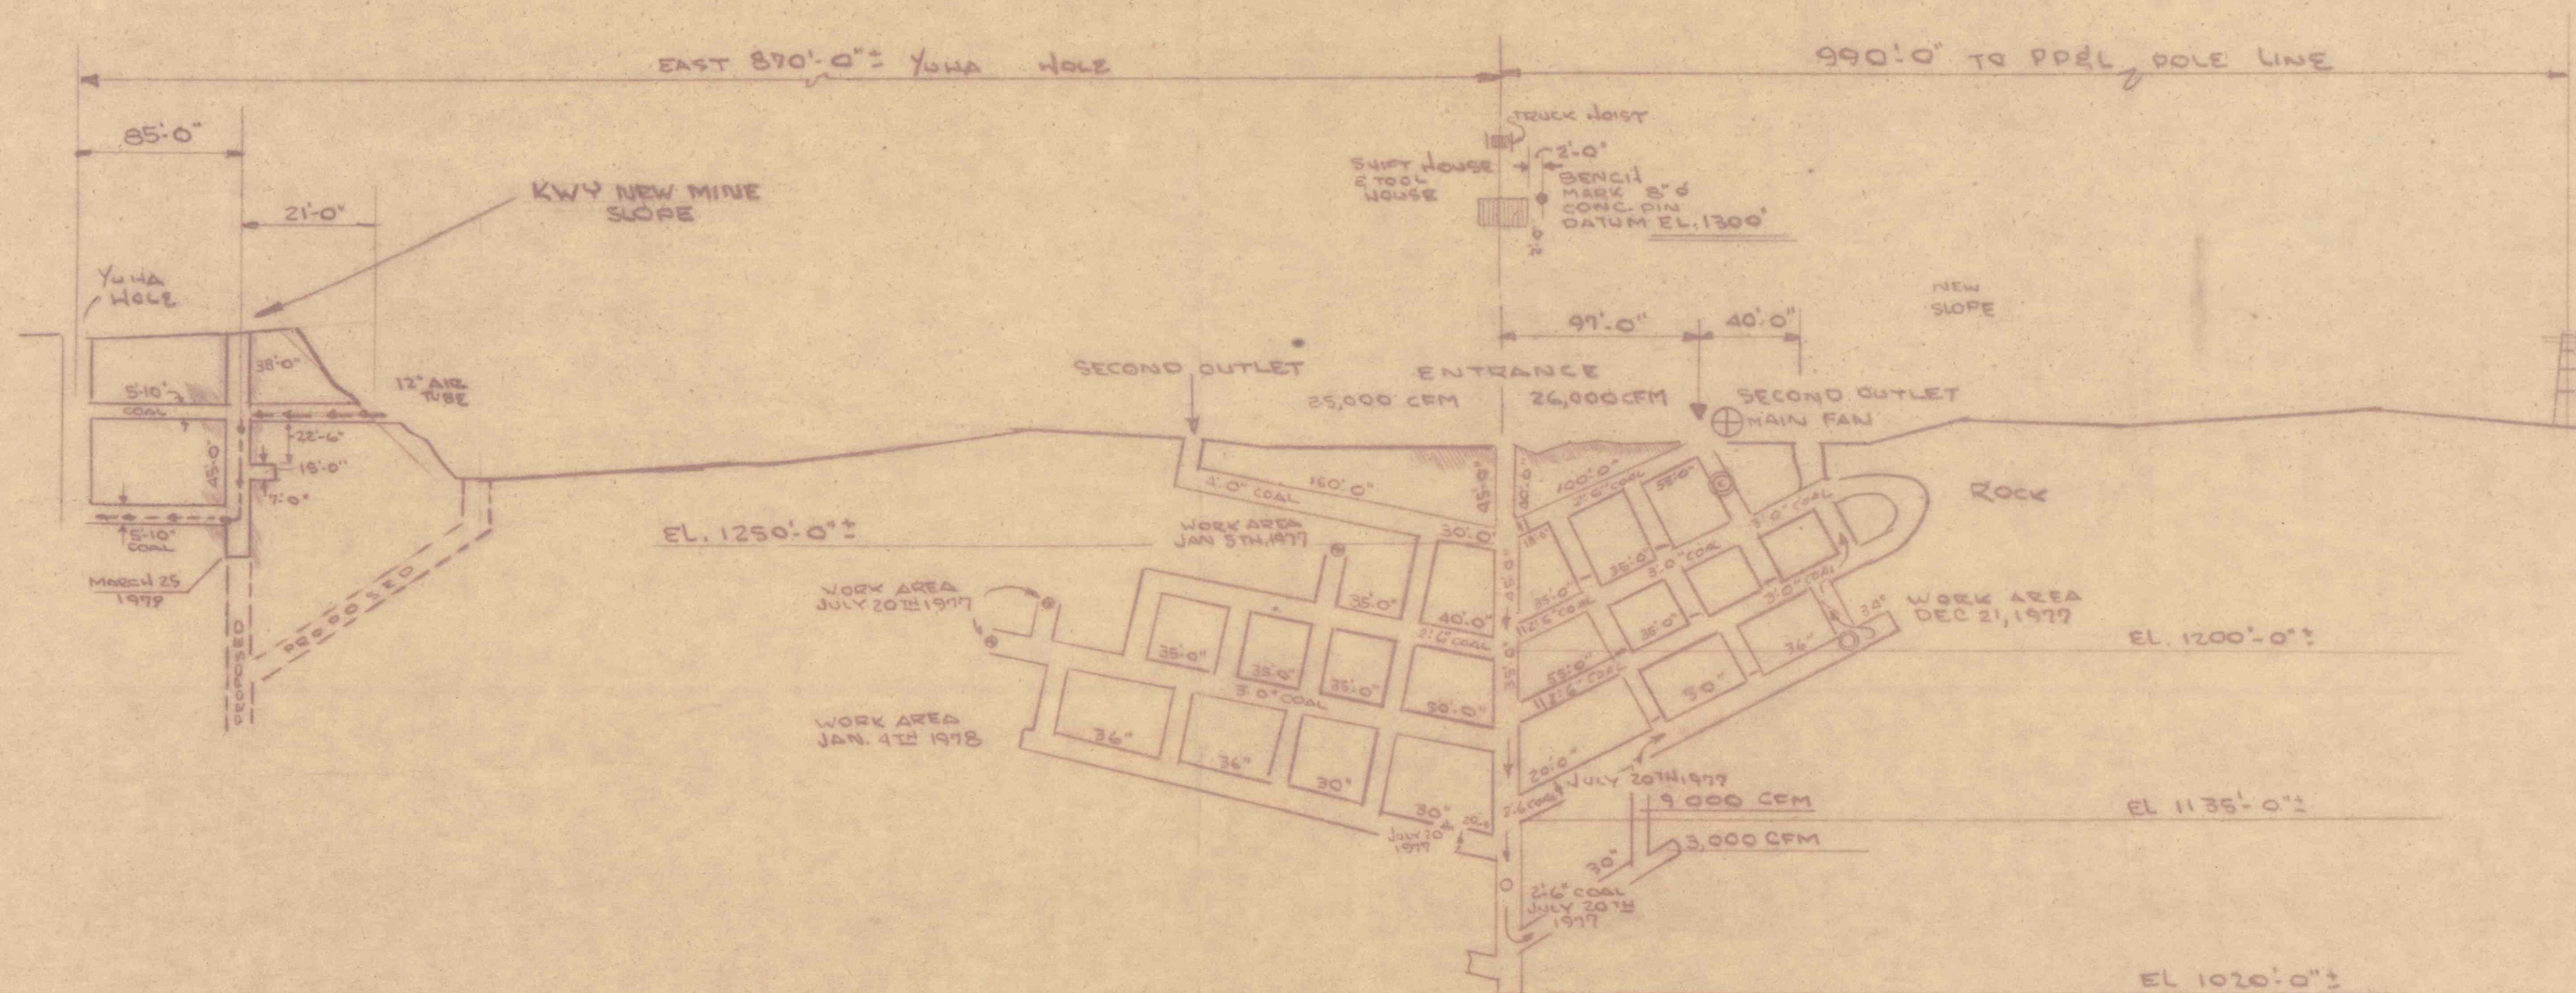

N91 SLOPE ID 36-0-5906
 K.W.Y. COAL CO. EXCELSIOR PA.
 3 1/2 VAIN - 45° PITCH SCALE 1"=100'-0"

ORIGINAL JAN 5TH 1977
 REVISED JULY 20TH 1977
 REVISED FEB 2ND 1978
 REVISED JUNE 17TH 1979

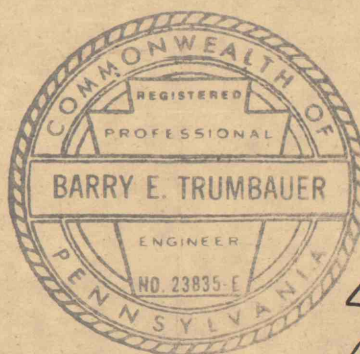

Barry E. Trumbauer
 6/20/79

LEGEND

- ⊕ MAIN FAN
- INTAKE AIR
- ↘ RETURN AIR
- = PERMANENT STOPPING
- TEMPORARY STOPPING
- BRATTICE
- Ⓢ ESCAPE WAY RETURN AIR WAY
- Ⓡ ESCAPE WAY INTAKE AIR