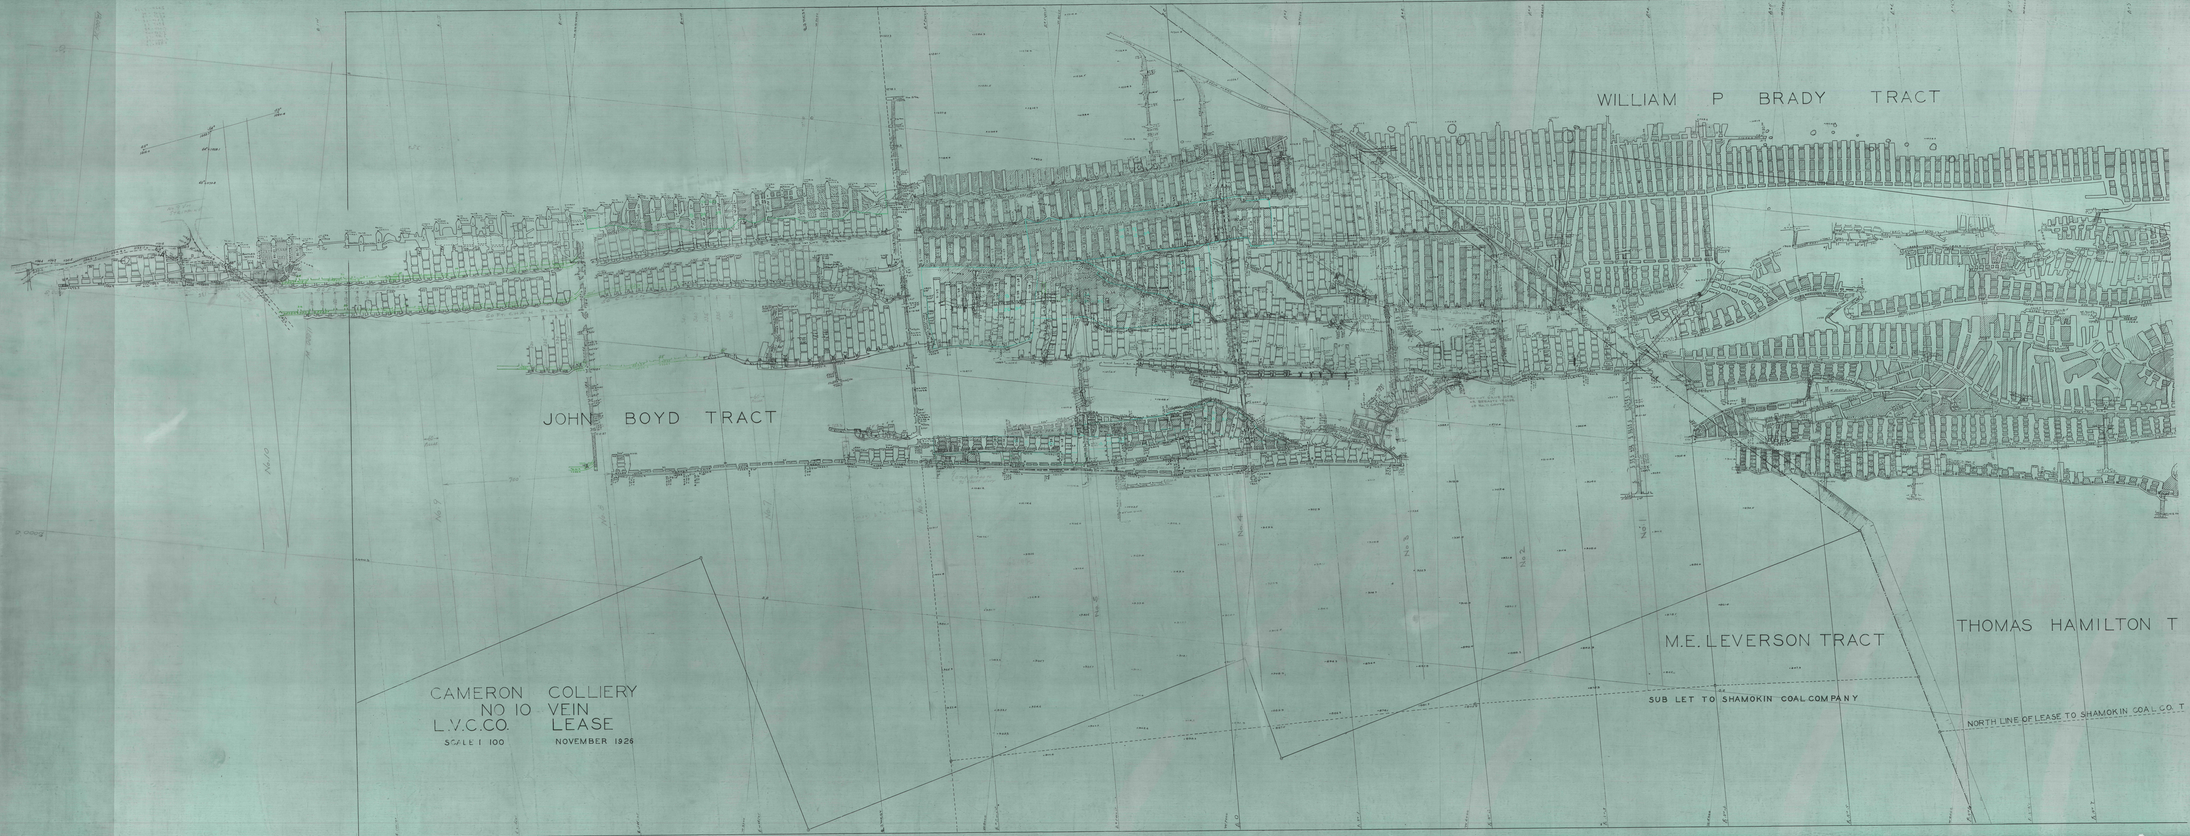
WILLIAM P BRADY TRACT
JOHN BOYD TRACT
M.E. LEVERSON TRACT
THOMAS HAMILTON T
SUB LET TO SHAMOKIN COAL COMPANY
NORTH LINE OF LEASE TO SHAMOKIN COAL CO. T
CAMERON COLLIERY
NO 10 VEIN
L.V.C.CO. LEASE
SCALE 1 100
NOVEMBER 1926