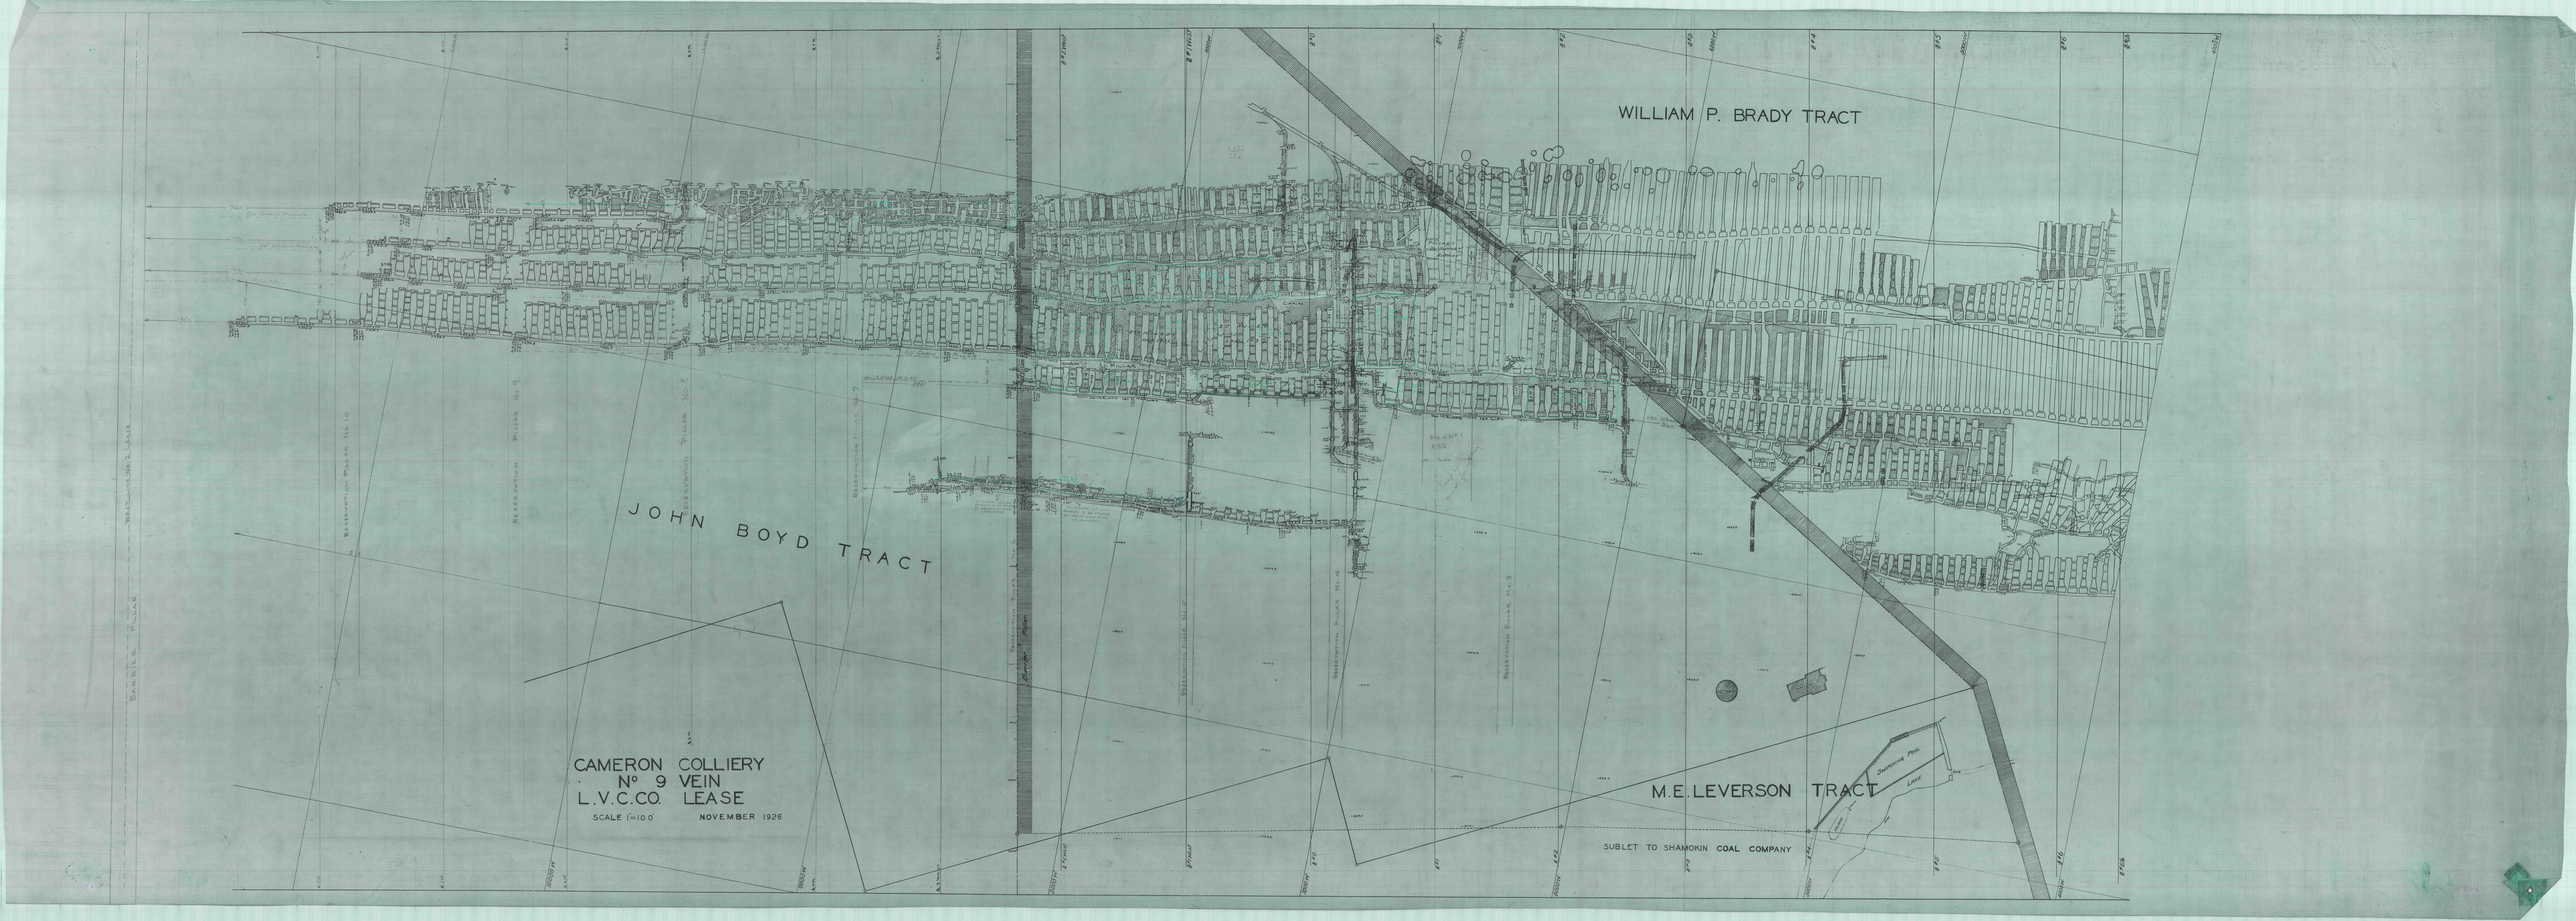
WILLIAM P. BRADY TRACT
JOHN BOYD TRACT
M.E. LEVERSON TRACT
SUBLET TO SHAMOKIN COAL COMPANY
CAMERON COLLIERY
Nº 9 VEIN
L.V.C.CO. LEASE
SCALE 1"=100'
NOVEMBER 1926