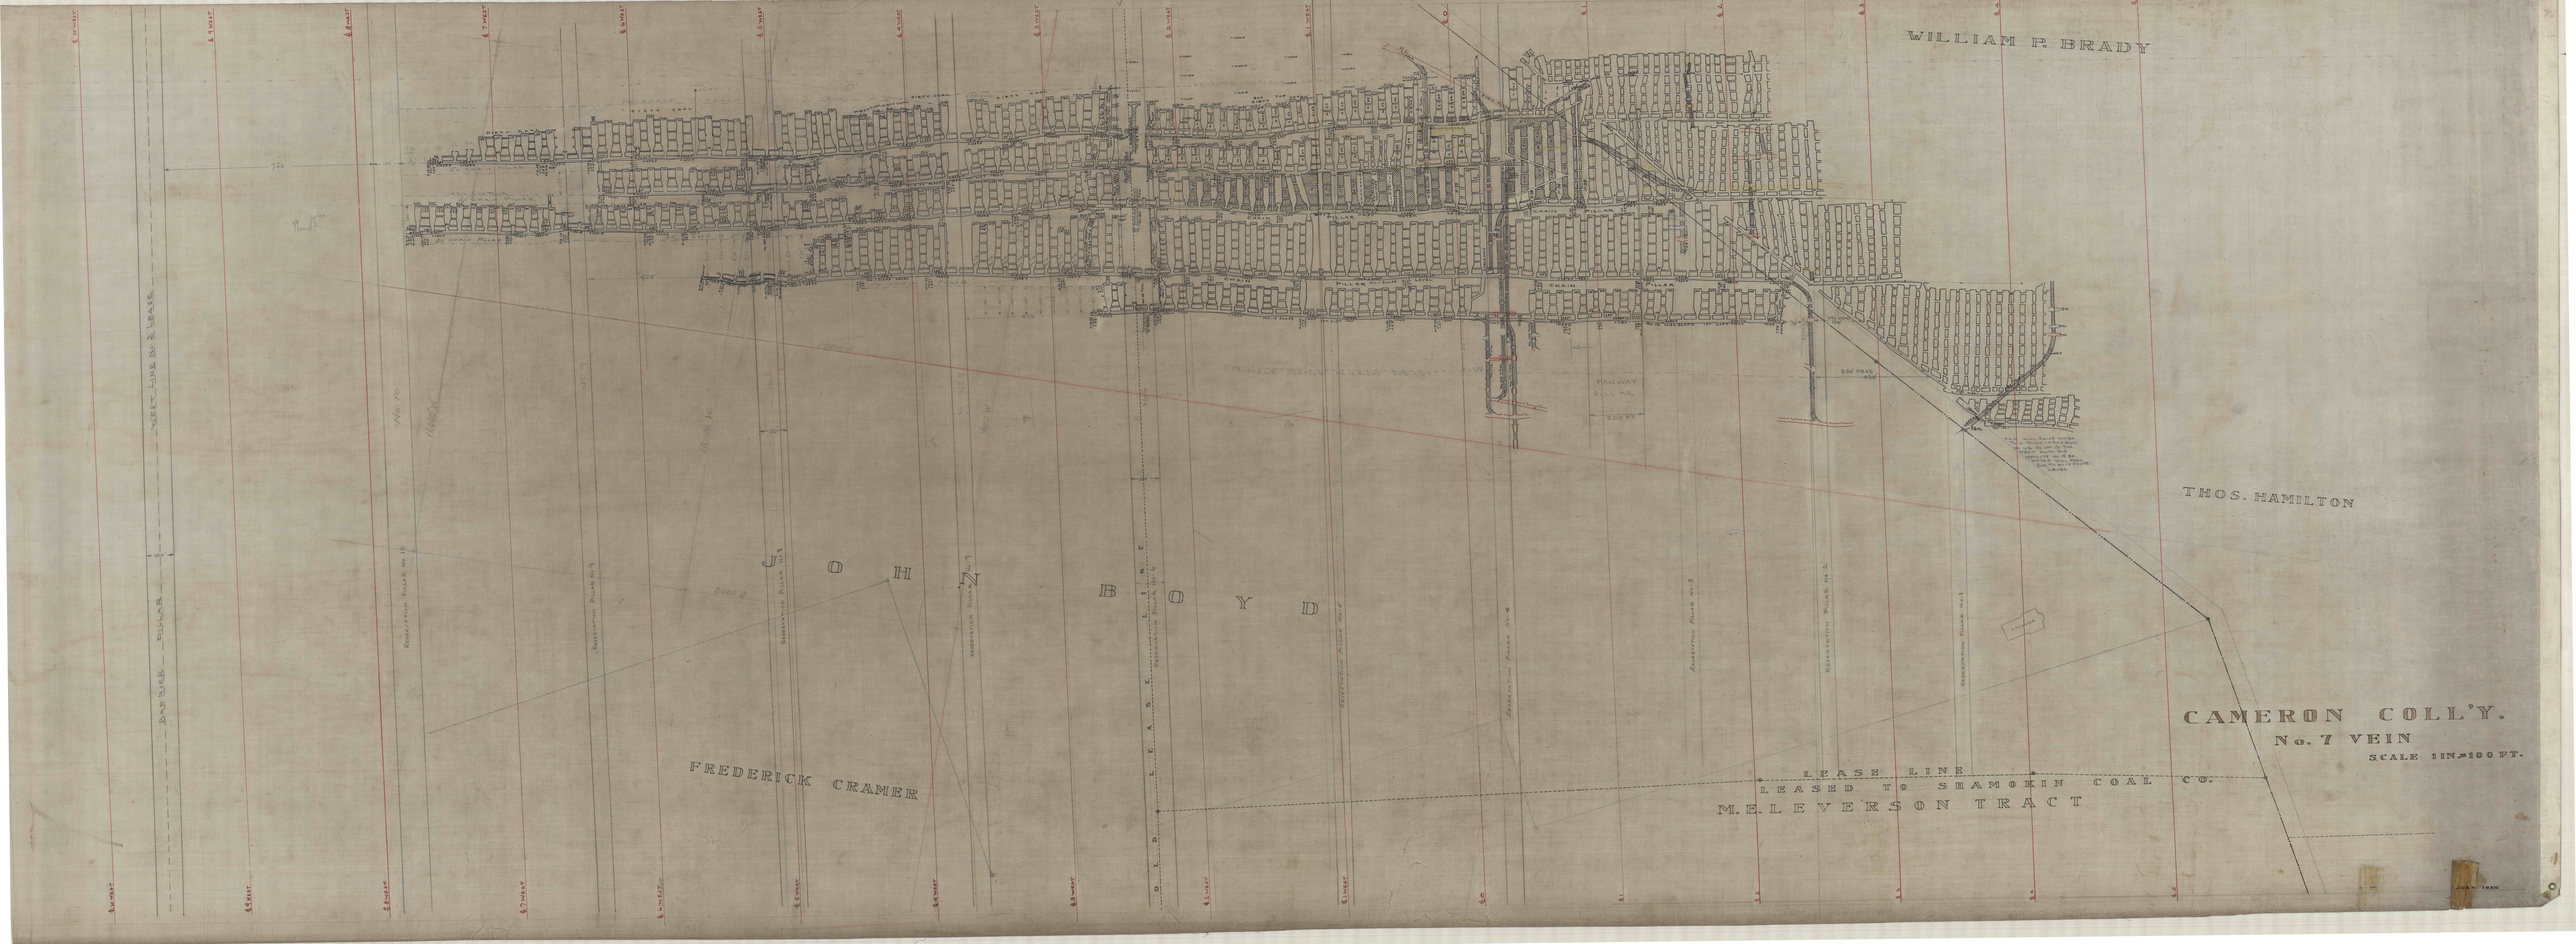
WILLIAM P. BRADY
THOS. HAMILTON
JOHN BOYD
FREDERICK CRAMER
M.E. LEVERSON TRACT
LEASE LINE
LEASED TO SHAMOKIN COAL CO.
OLD LEASE LINE
WEST LINE No 2 LEASE
BARRIER PILLAR
CAMERON COLL'Y.
No. 7 VEIN
SCALE 1IN.=100 FT.