STEVENS COAL COMPANY
CAMERON COLLIERY
SECTION No 5W

N
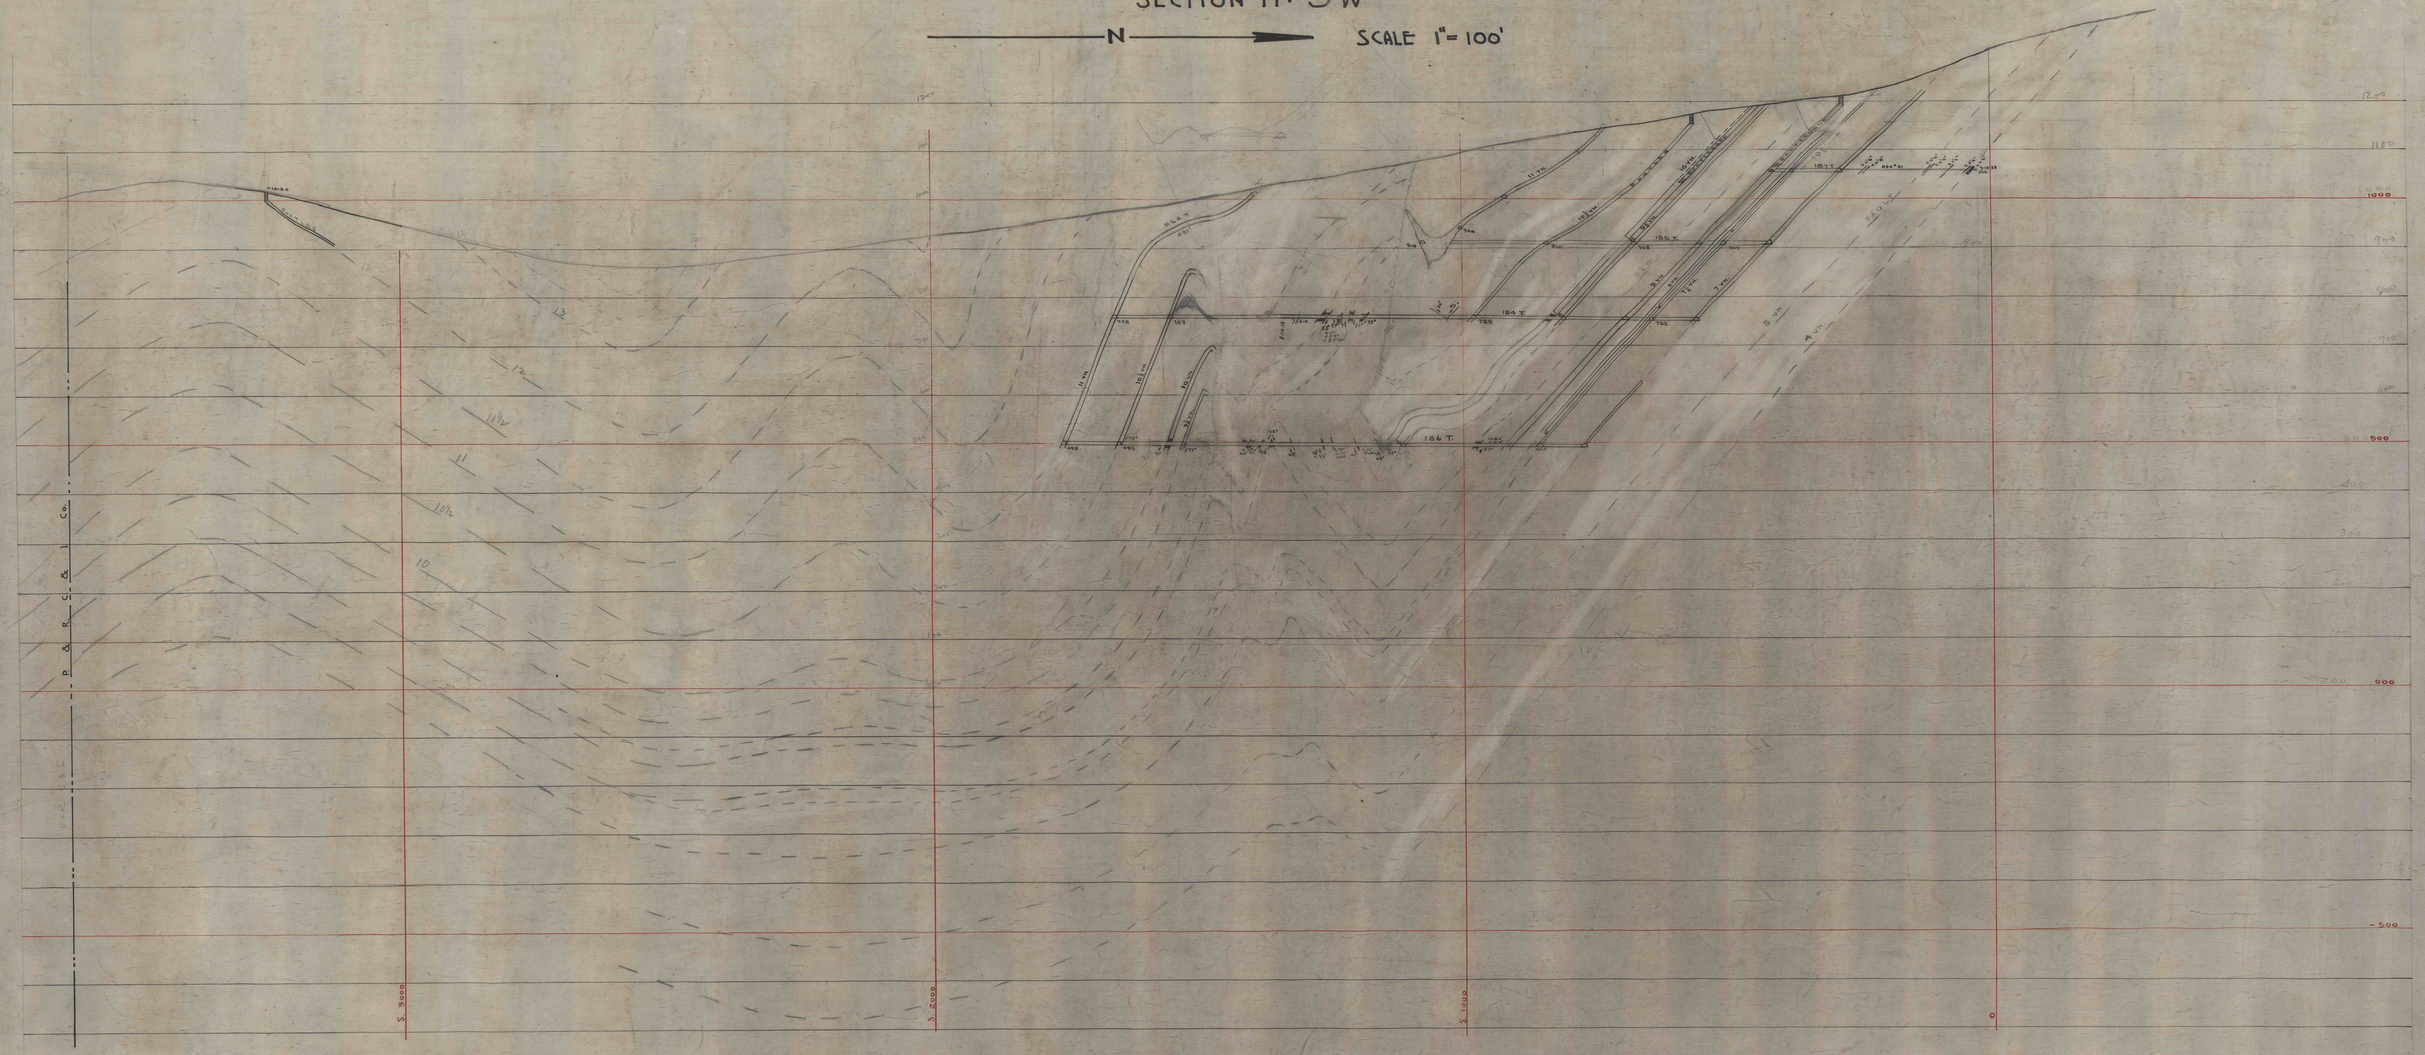
SCALE 1" = 100'