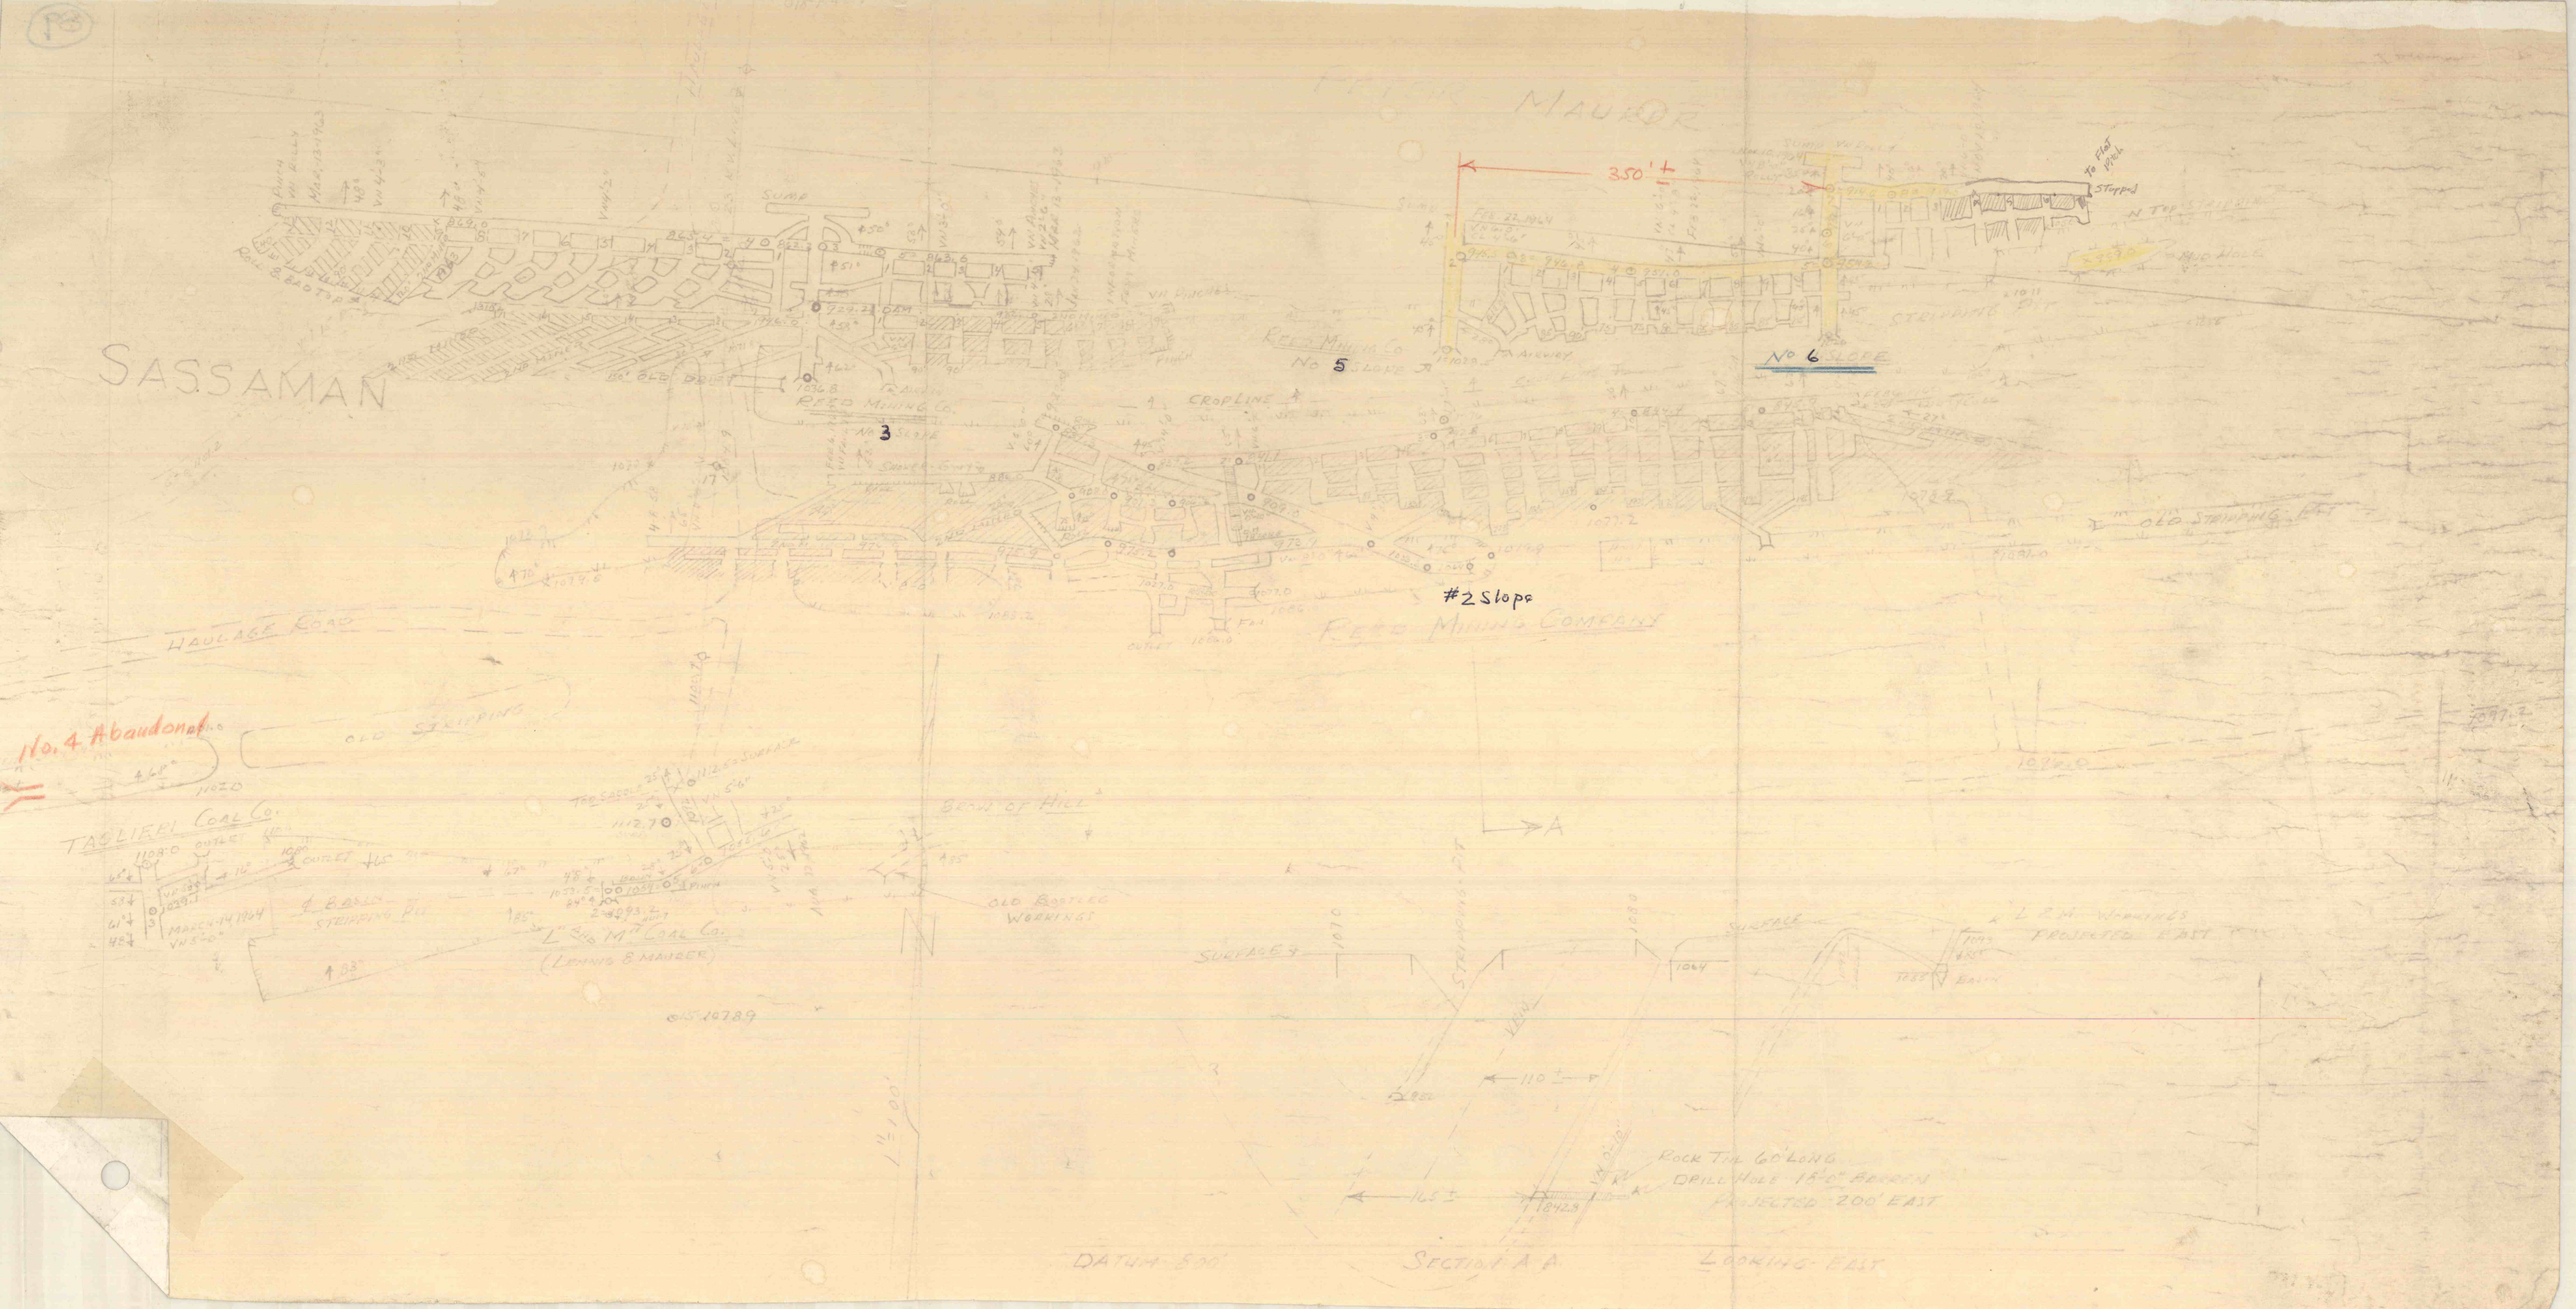
SASSAMAN
MAUKER
350' ±
No 6
No 5
3
#2 Slope
REED MINING COMPANY
REED MINING CO
CROPLINE
OLD STRIPPING
HAULAGE ROAD
No. 4 Abandoned
TAGLIERI COAL CO.
BROW OF HILL
OLD BOOTLEG WORKINGS
L & M COAL CO.
(LEHING & MAUGER)
SURFACE
STRIPPING PIT
ROCK TOP 60' LONG
DRILL HOLE 18'0" BROWN
PROJECTED 200' EAST
DATUM 800'
SECTION A-A
LOOKING EAST