


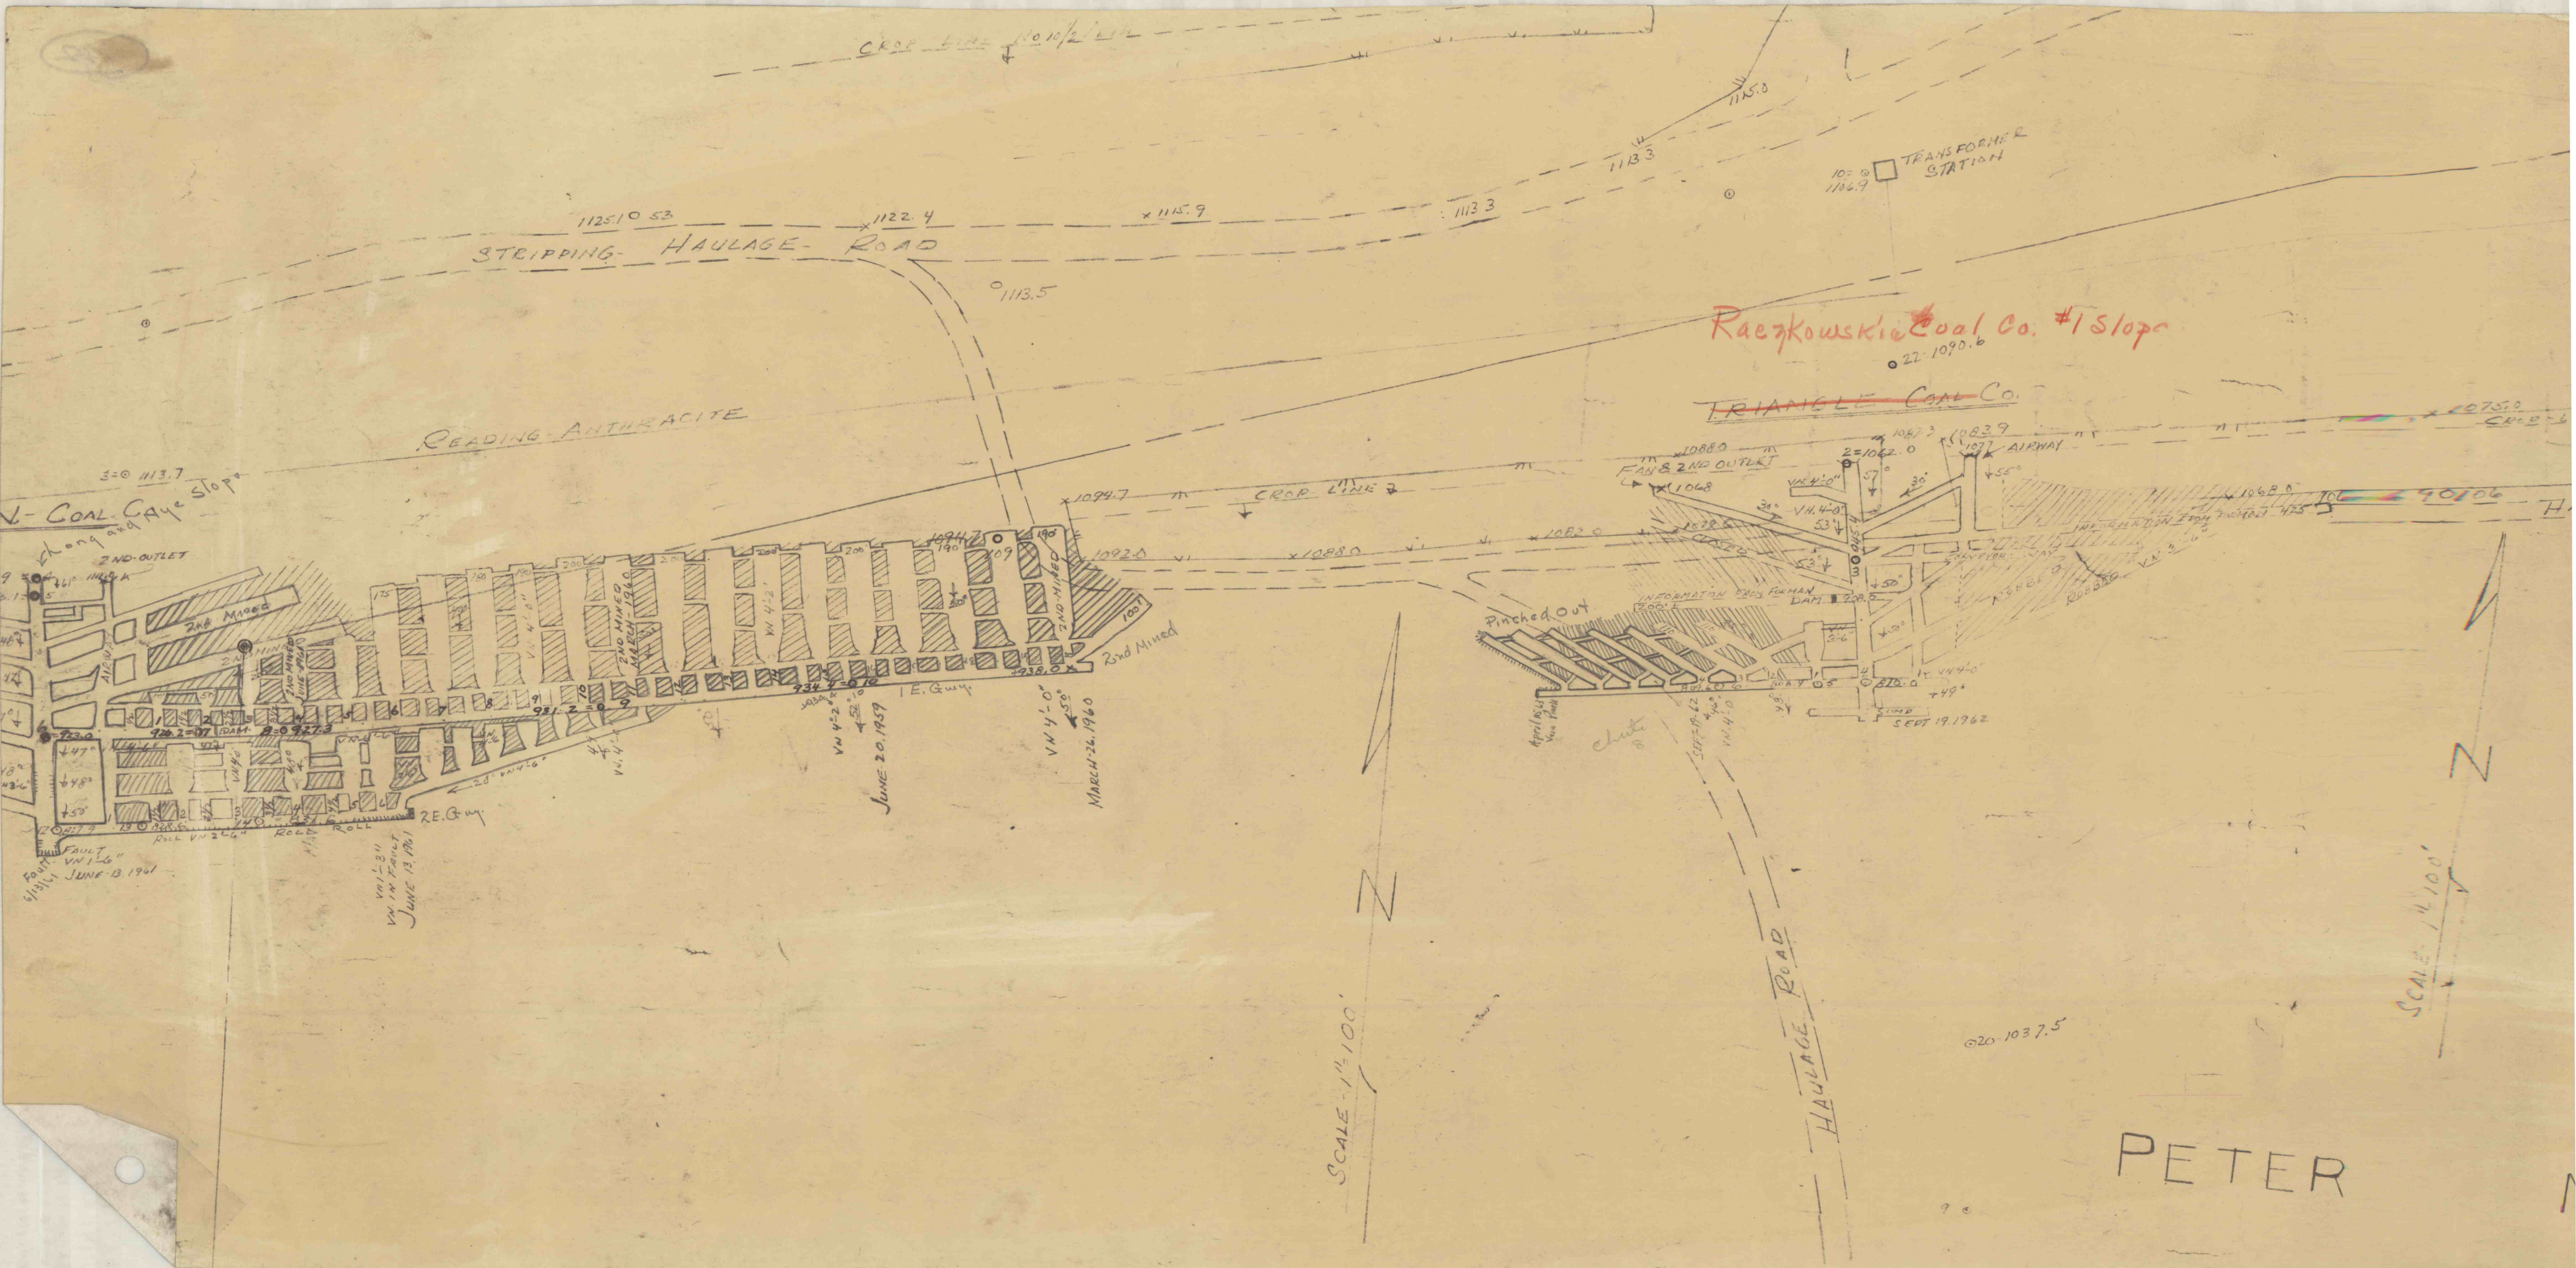

Raczkowski Coal Co. #1 Slope

TRIANGLE COAL CO.

SCALE 1"=100'

SCALE 1"=100'

PETER