


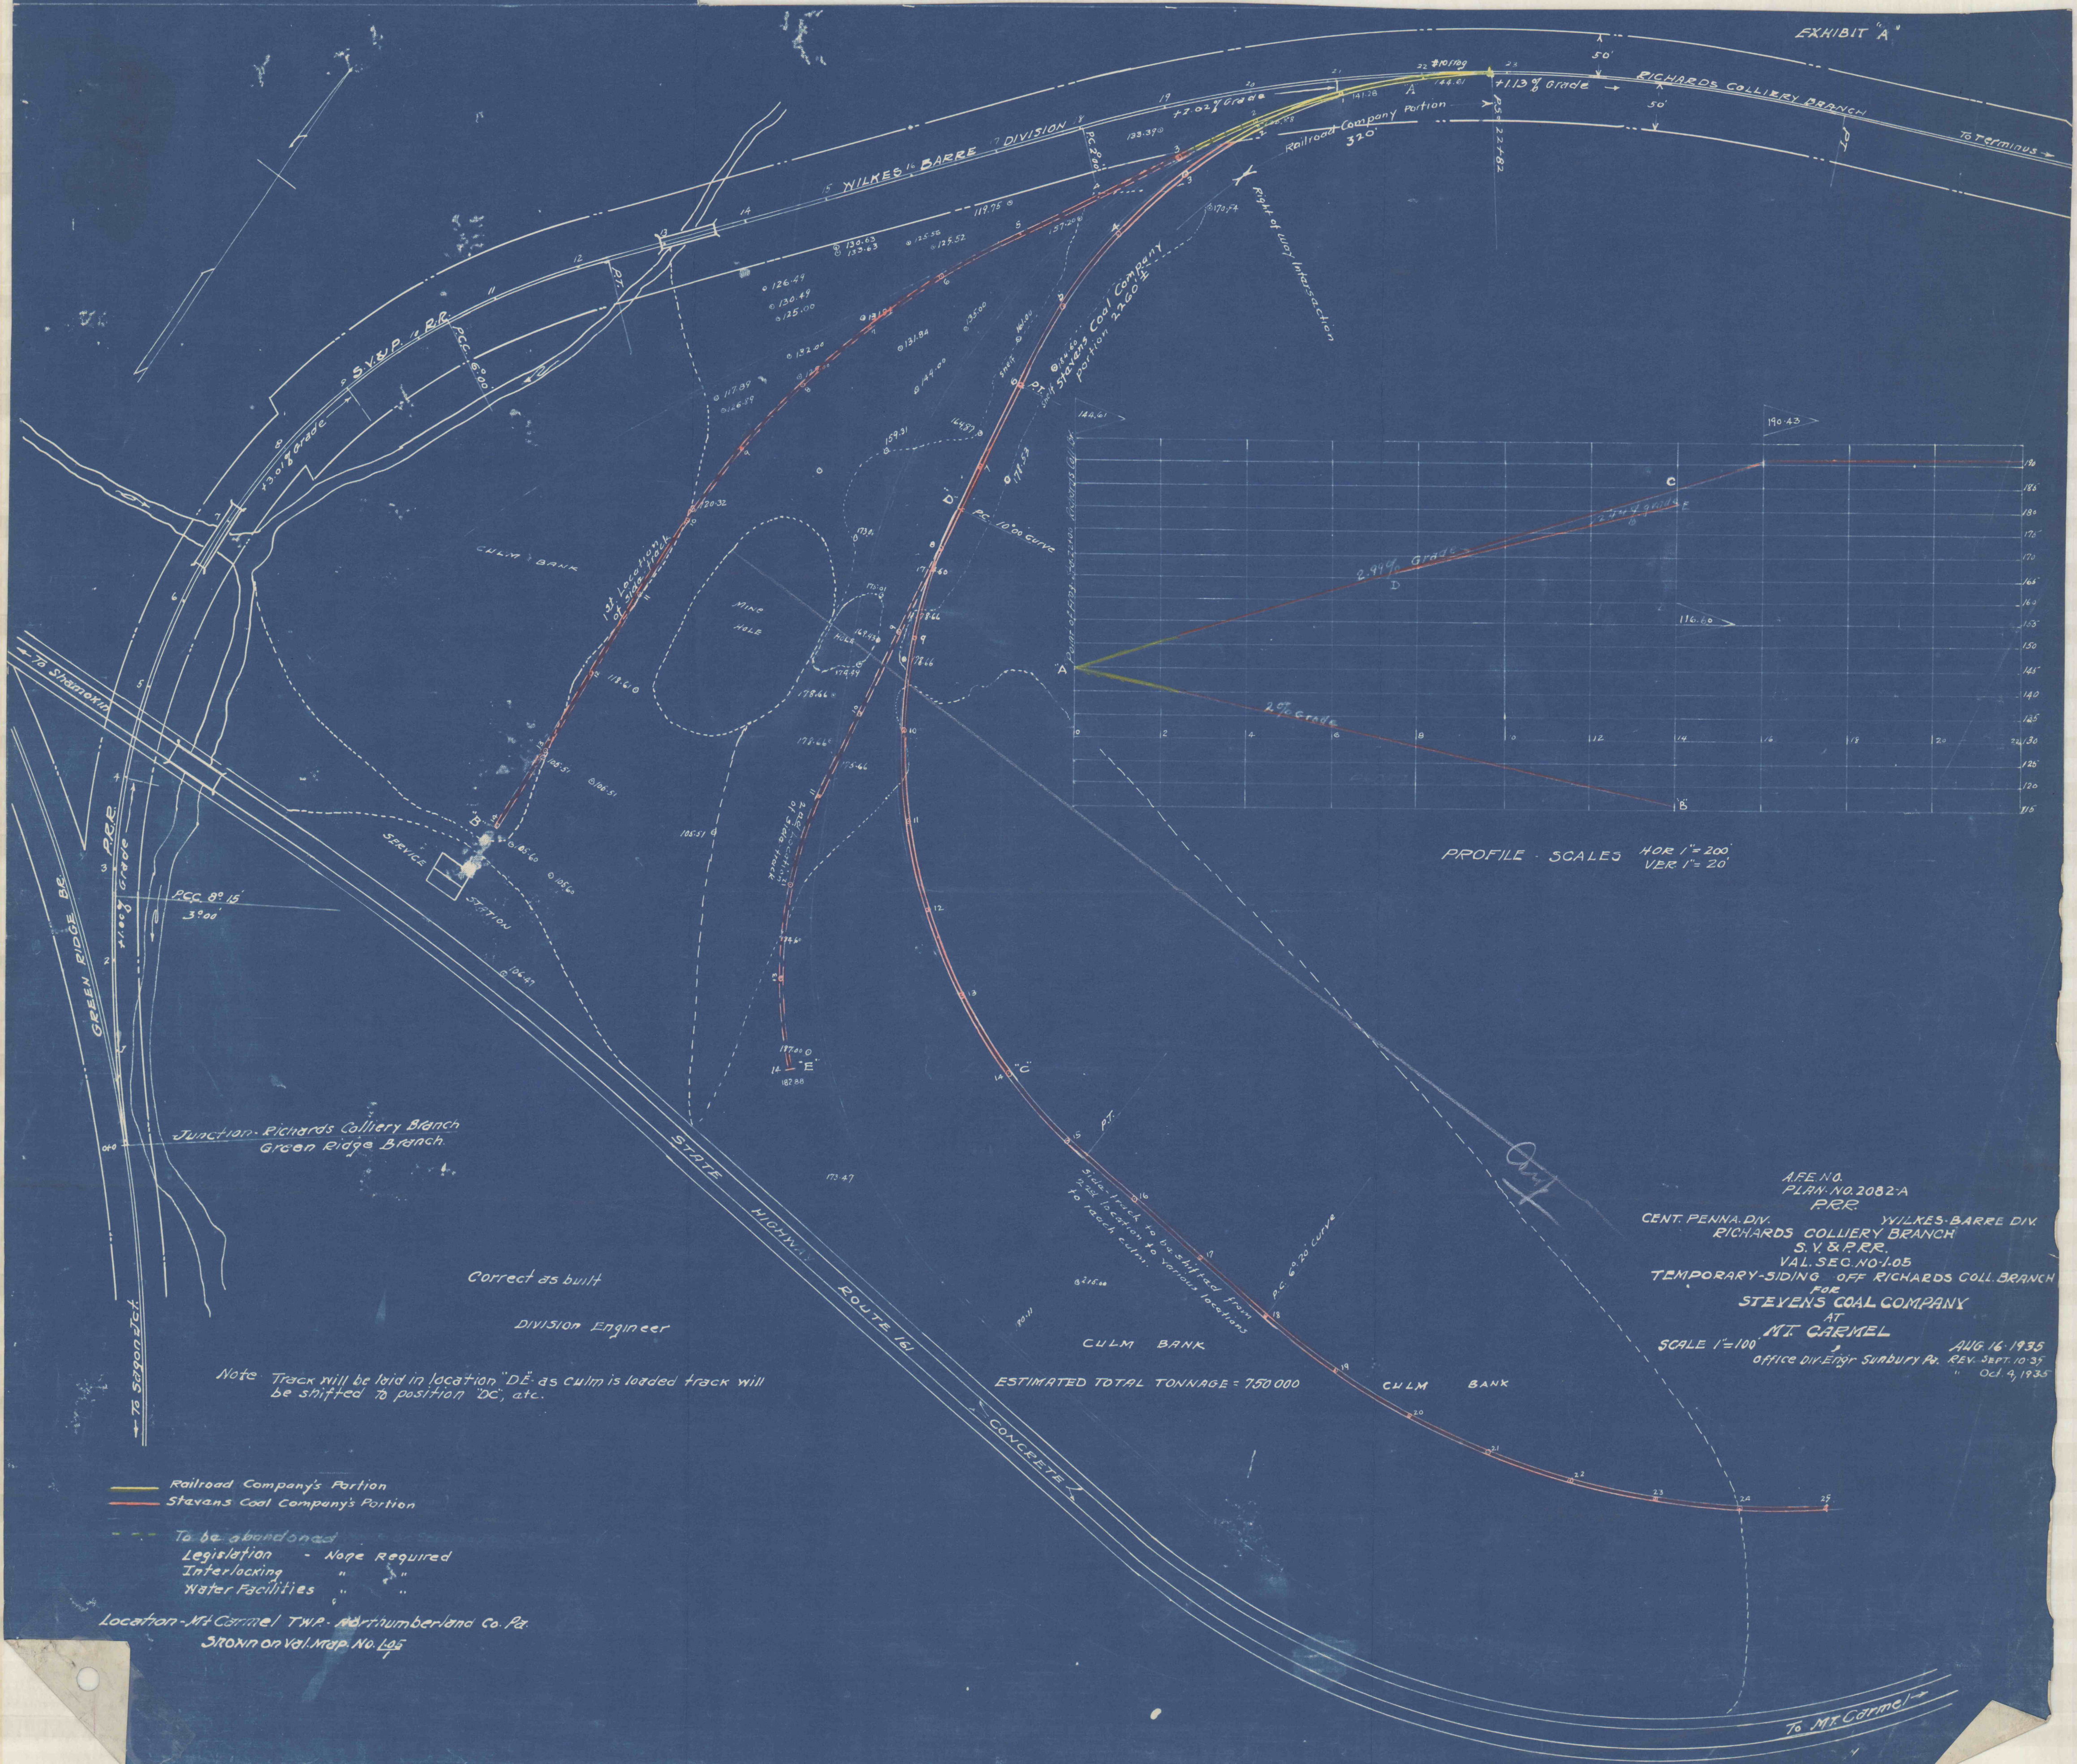

PROFILE SCALES HOR 1"=200' VER 1"=20'

A.F.E. NO. 2082-A
PLAN NO. 2082-A
P.R.R.
CENT. PENNA. DIV. WILKES-BARRE DIV.
RICHARDS COLLIERY BRANCH
S.V. & P.R.R.
VAL. SEC. NO. 105
TEMPORARY SIDING OFF RICHARDS COLL. BRANCH
FOR
STEVENS COAL COMPANY
AT
MT. CARMEL
SCALE 1"=100' AUG. 16, 1935
Office Div. Engr. Sunbury Pa. REV. SEPT. 10, 35
" Oct. 4, 1935

- Railroad Company's Portion
- Stevens Coal Company's Portion
- - - To be abandoned
- Legislation - None Required
- Interlocking " "
- Water Facilities " "

Location - Mt. Carmel TWP. Northumberland Co. Pa.
Shown on Val. Map No. 145