


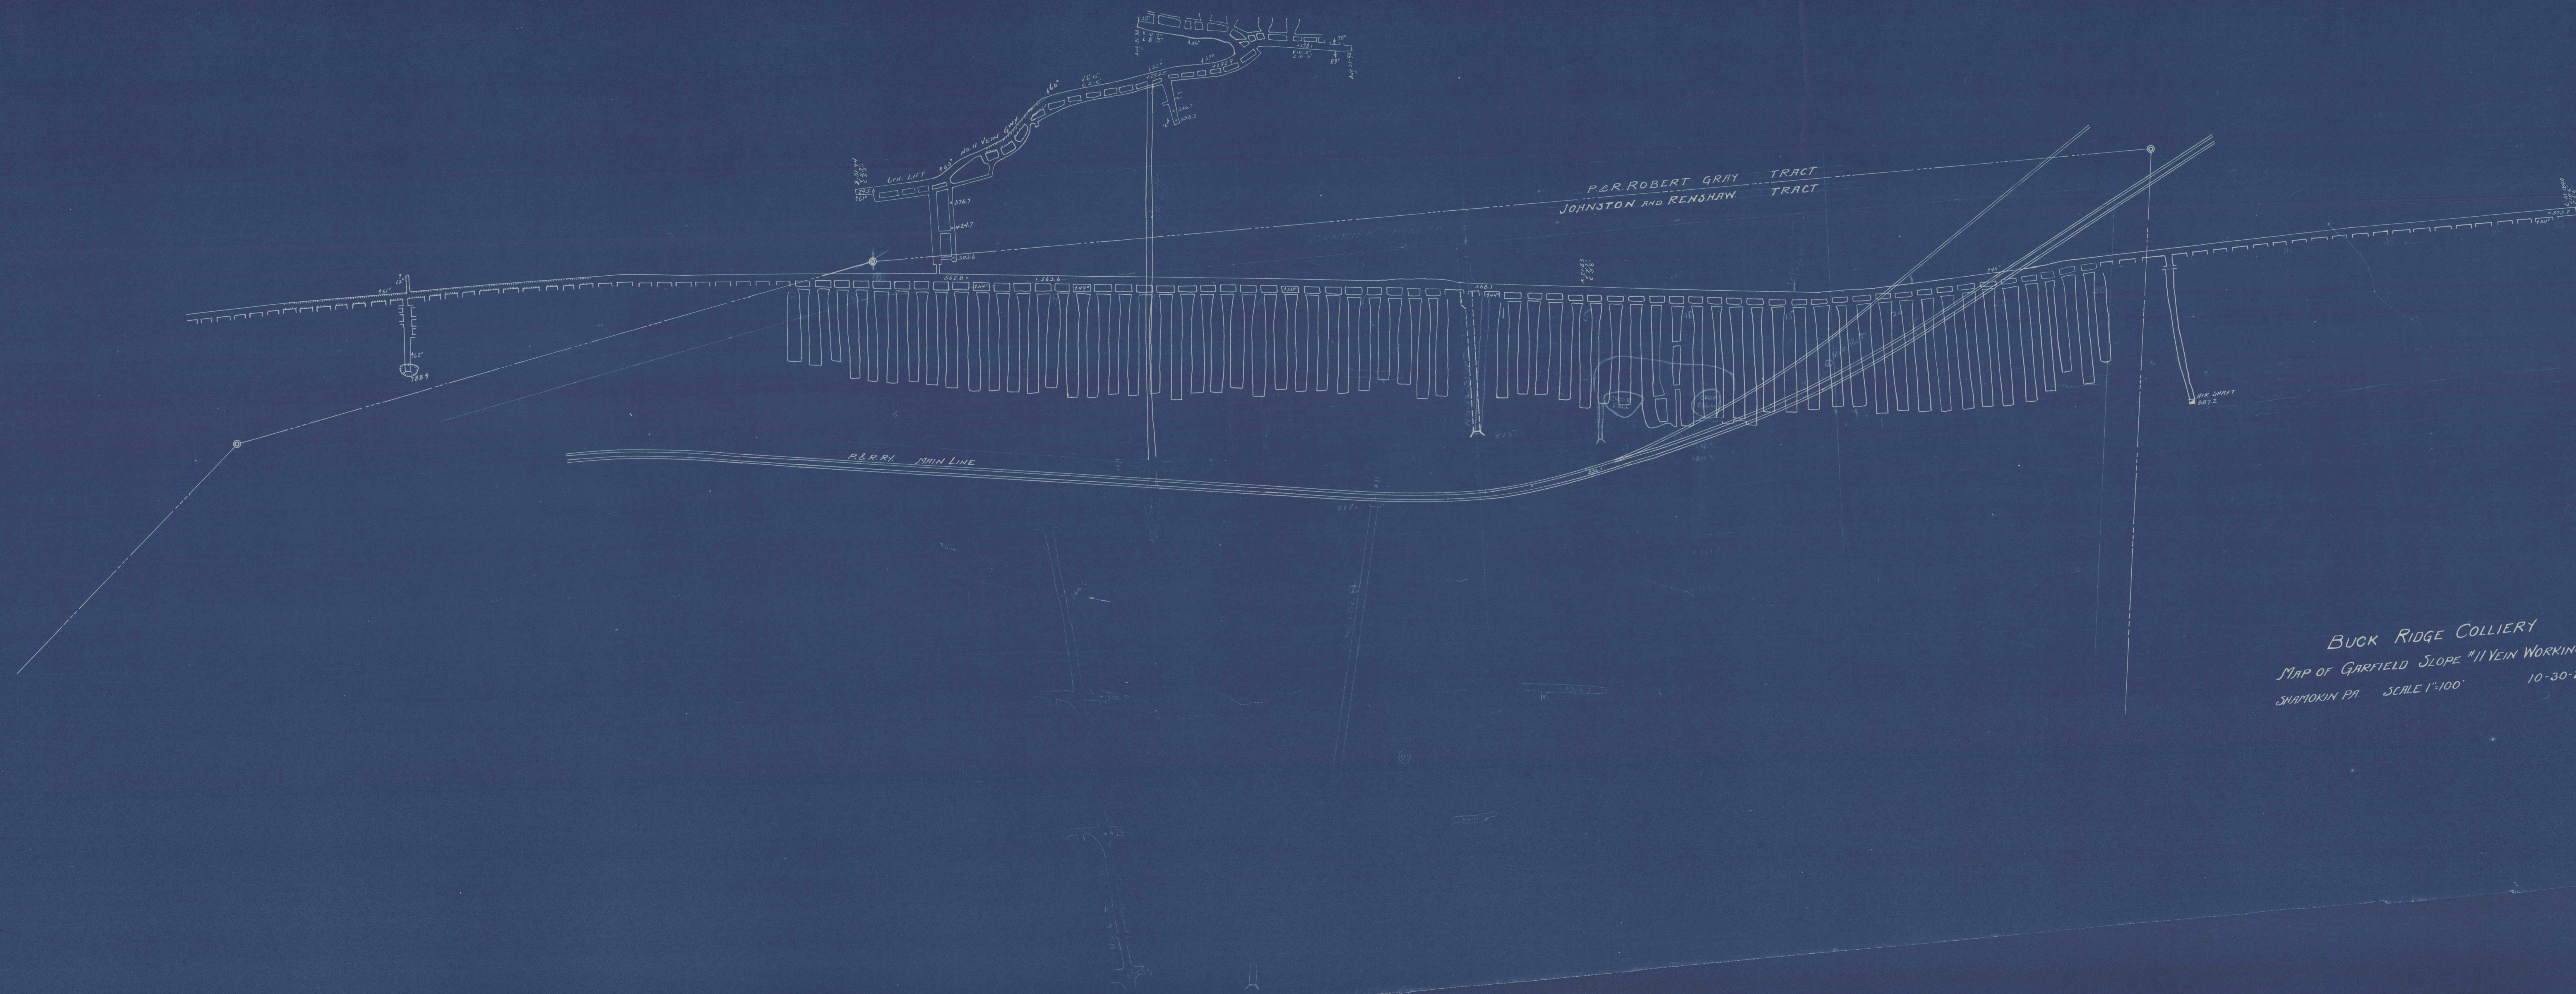

BUCK RIDGE COLLIERY
MAP OF GARFIELD SLOPE #11 VEIN WORKINGS
SHUMOKIN PA. SCALE 1"=100' 10-30-23