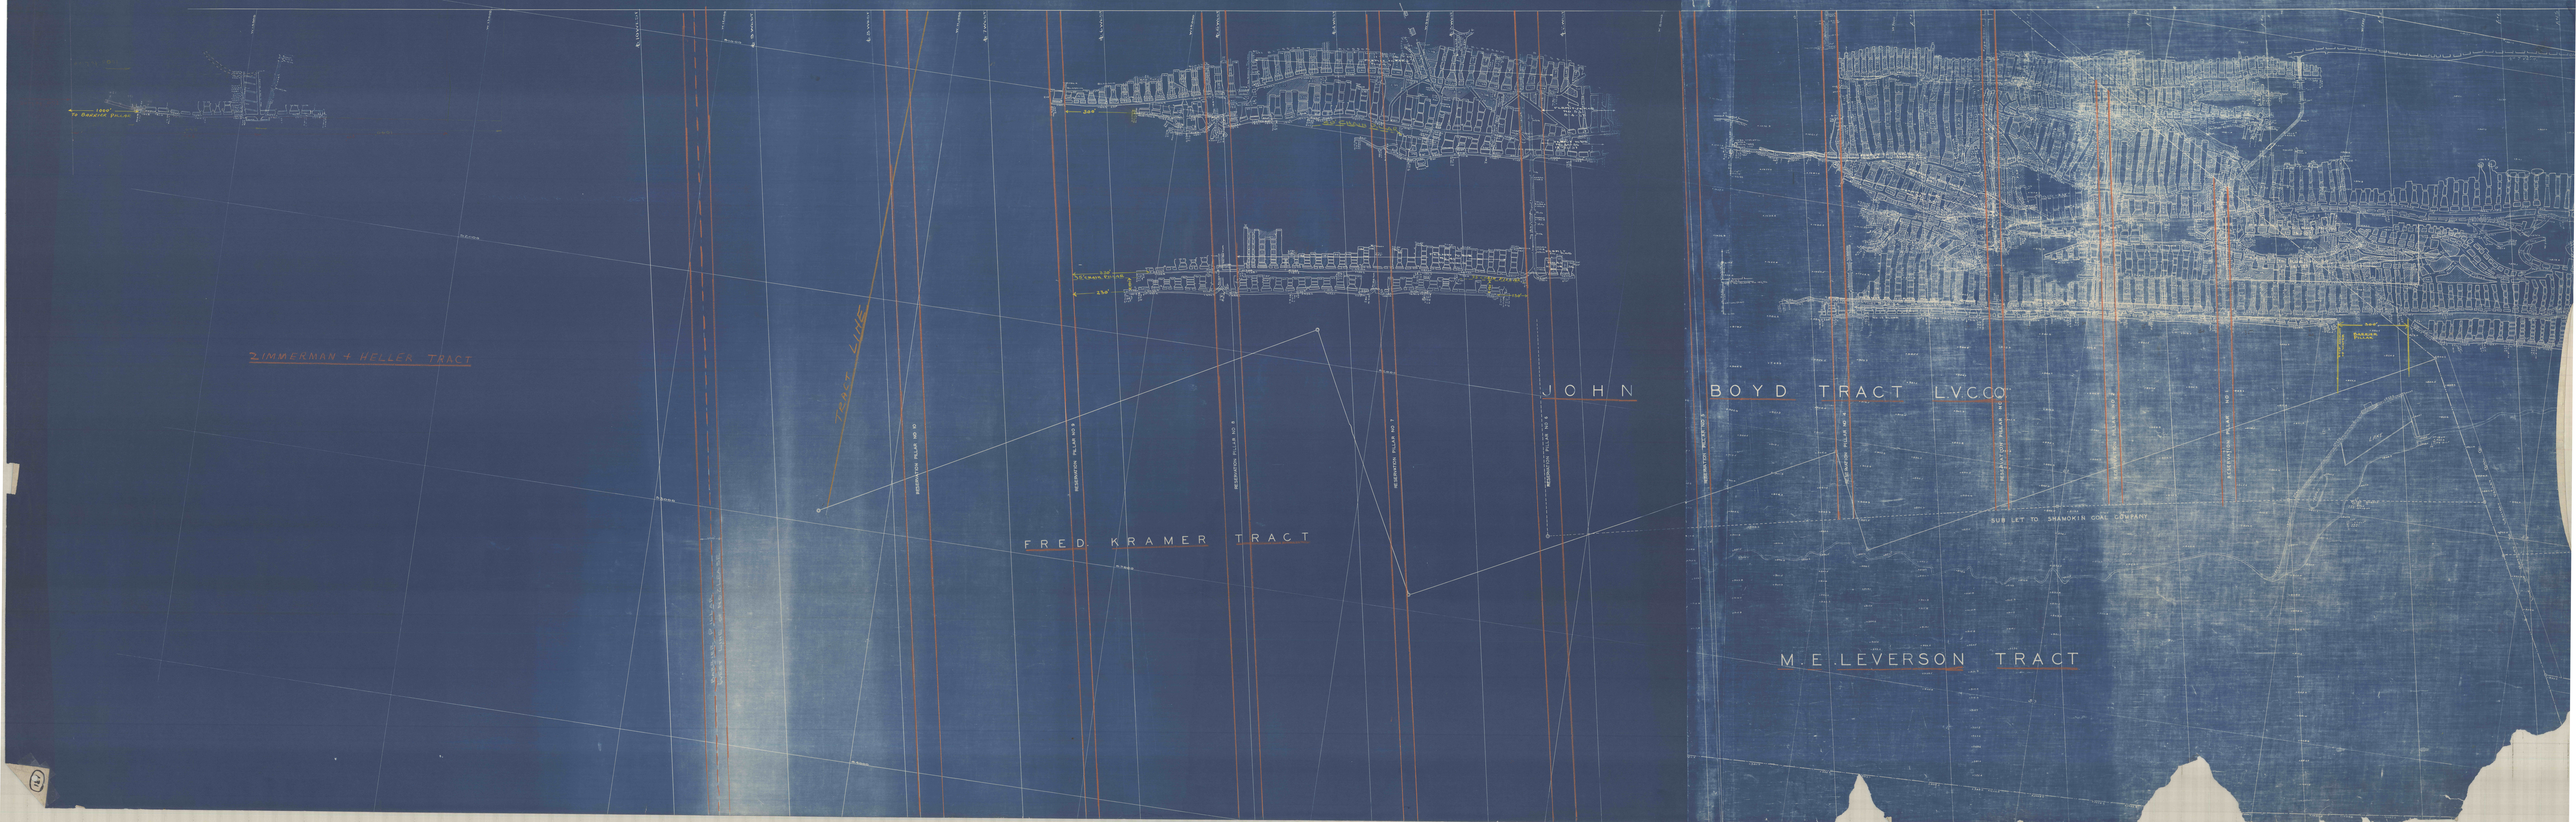
ZIMMERMAN + HELLER TRACT
TRACT LINE
JOHN
FRED KRAMER TRACT
BOYD TRACT L.V.C.CO.
SUB LET TO SHAMOKIN COAL COMPANY
M.E. LEVERSON TRACT