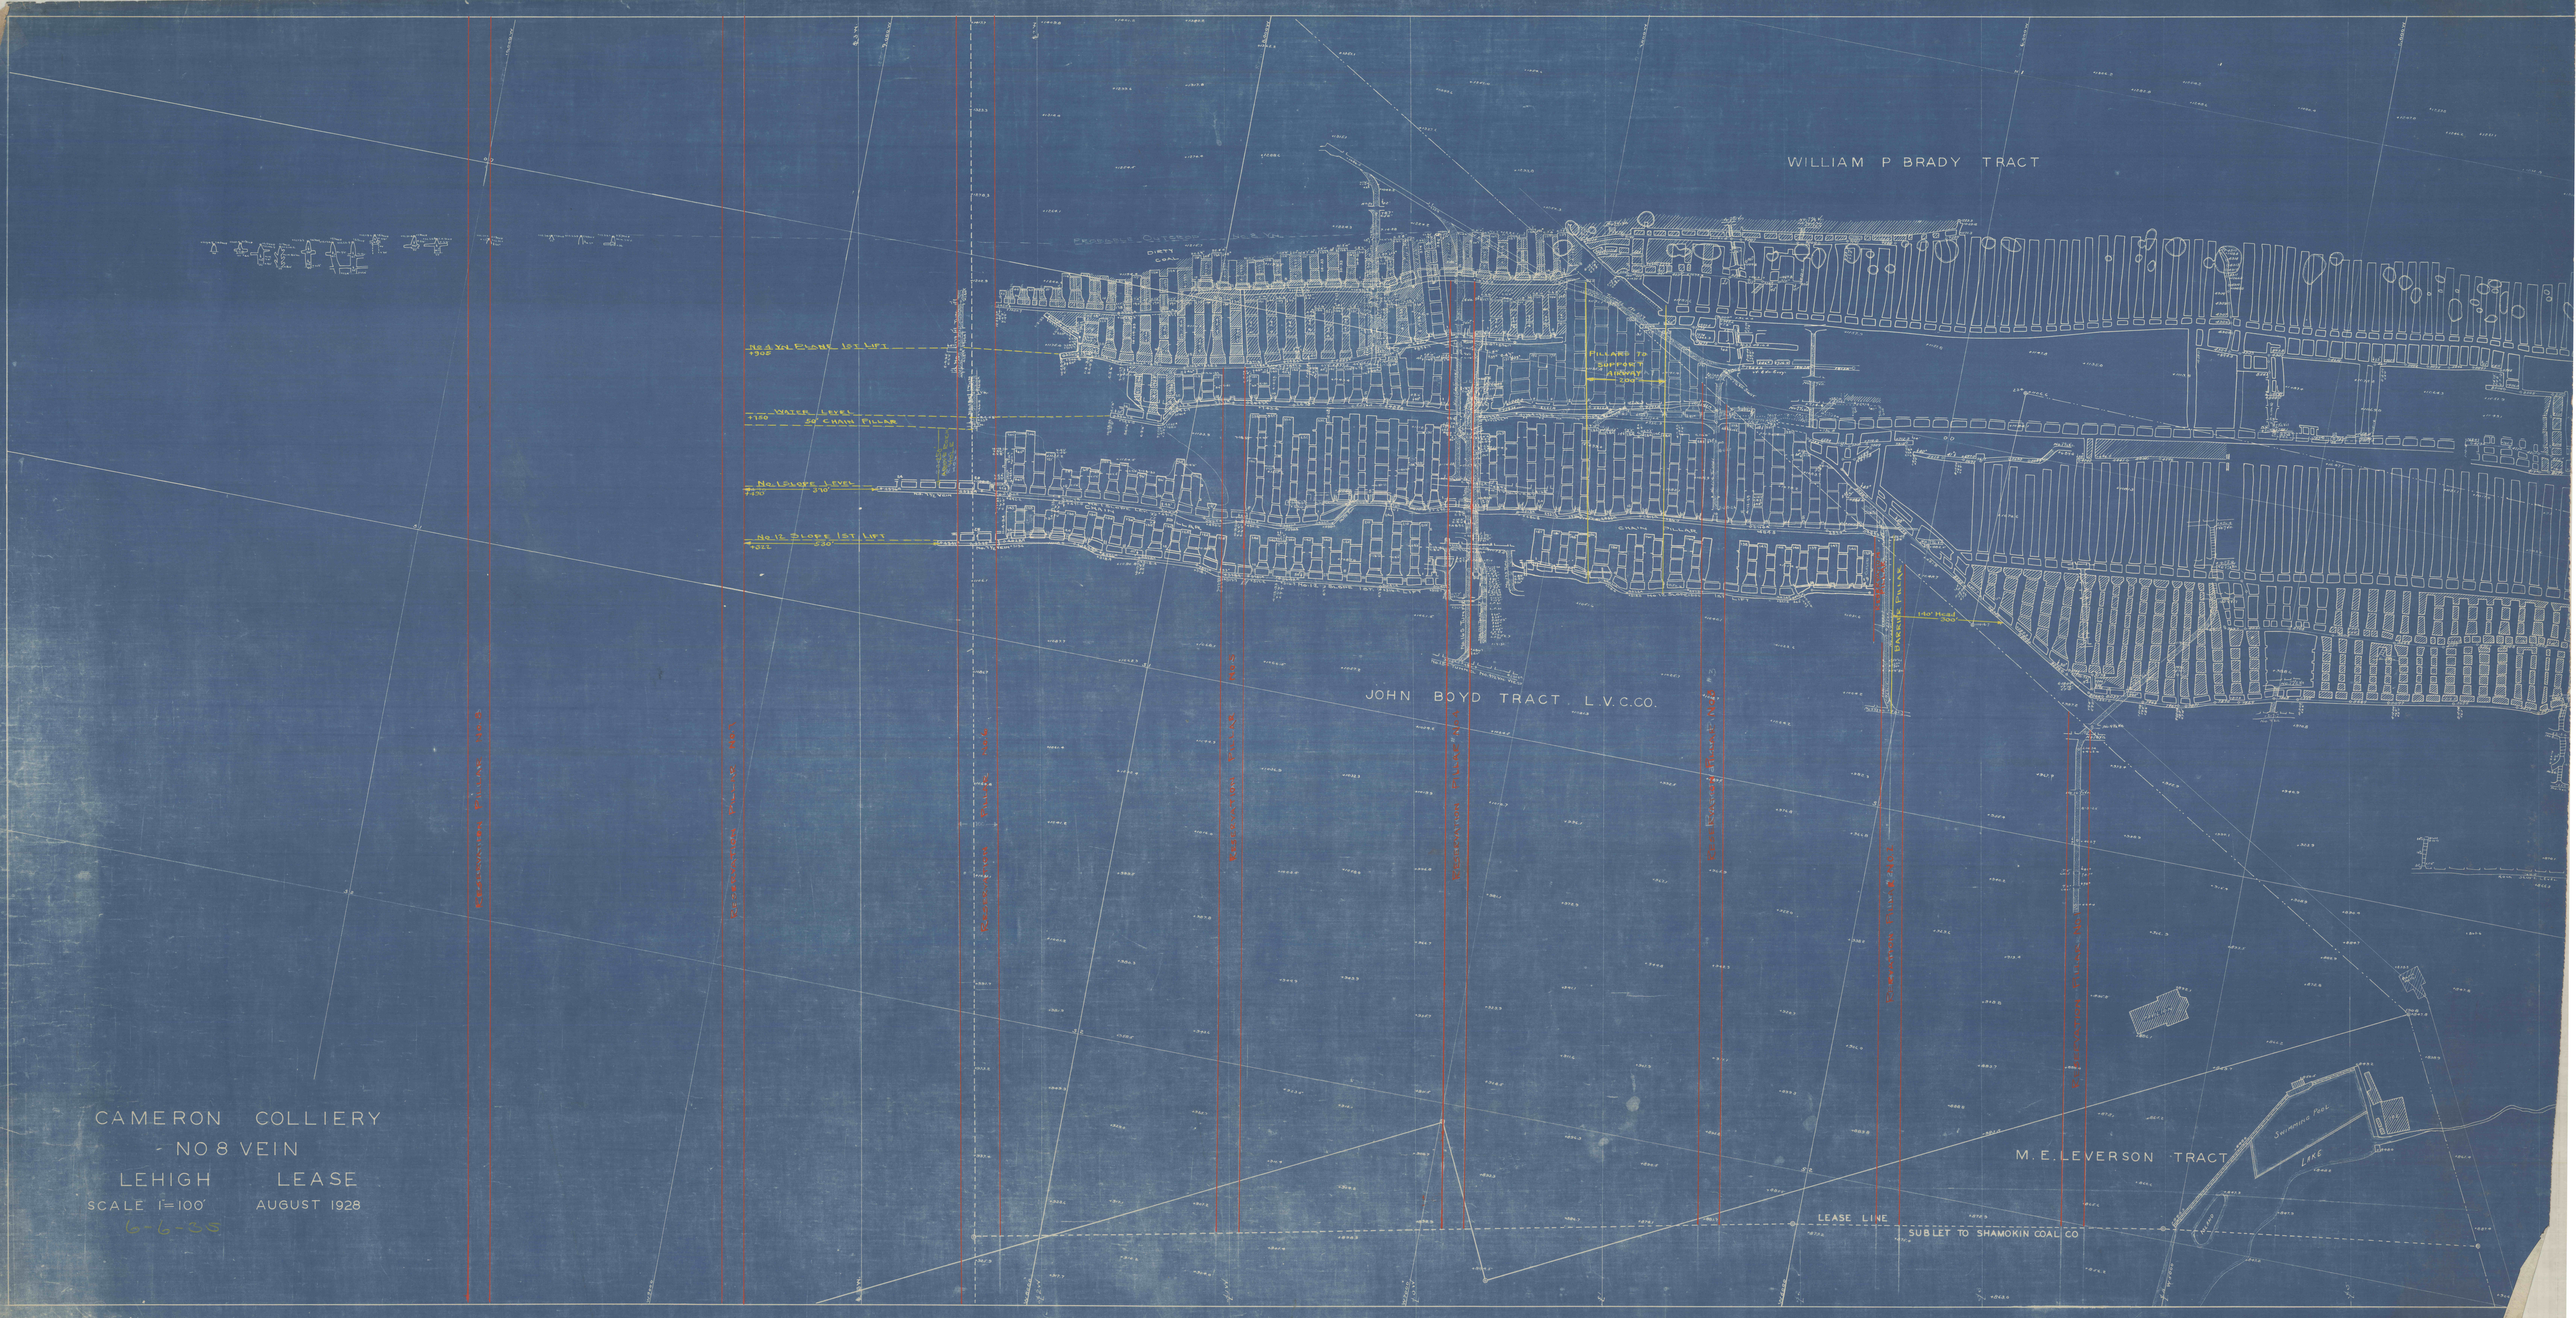
WILLIAM P BRADY TRACT
JOHN BOYD TRACT L.V.C.CO.
M. E. LEVERSON TRACT
LEASE LINE
SUBLET TO SHAMOKIN COAL CO
No 4 YN SLOPE 1ST LIFT
WATER LEVEL
50' CHAIN PILLAR
No 1 SLOPE LEVEL
No 12 SLOPE 1ST LIFT
PILLARS TO SUPPORT AIRWAY
140' Head
Swimming Pool
LAKE
CAMERON COLLIERY
NO 8 VEIN
LEHIGH LEASE
SCALE 1=100'
AUGUST 1928
6-6-25