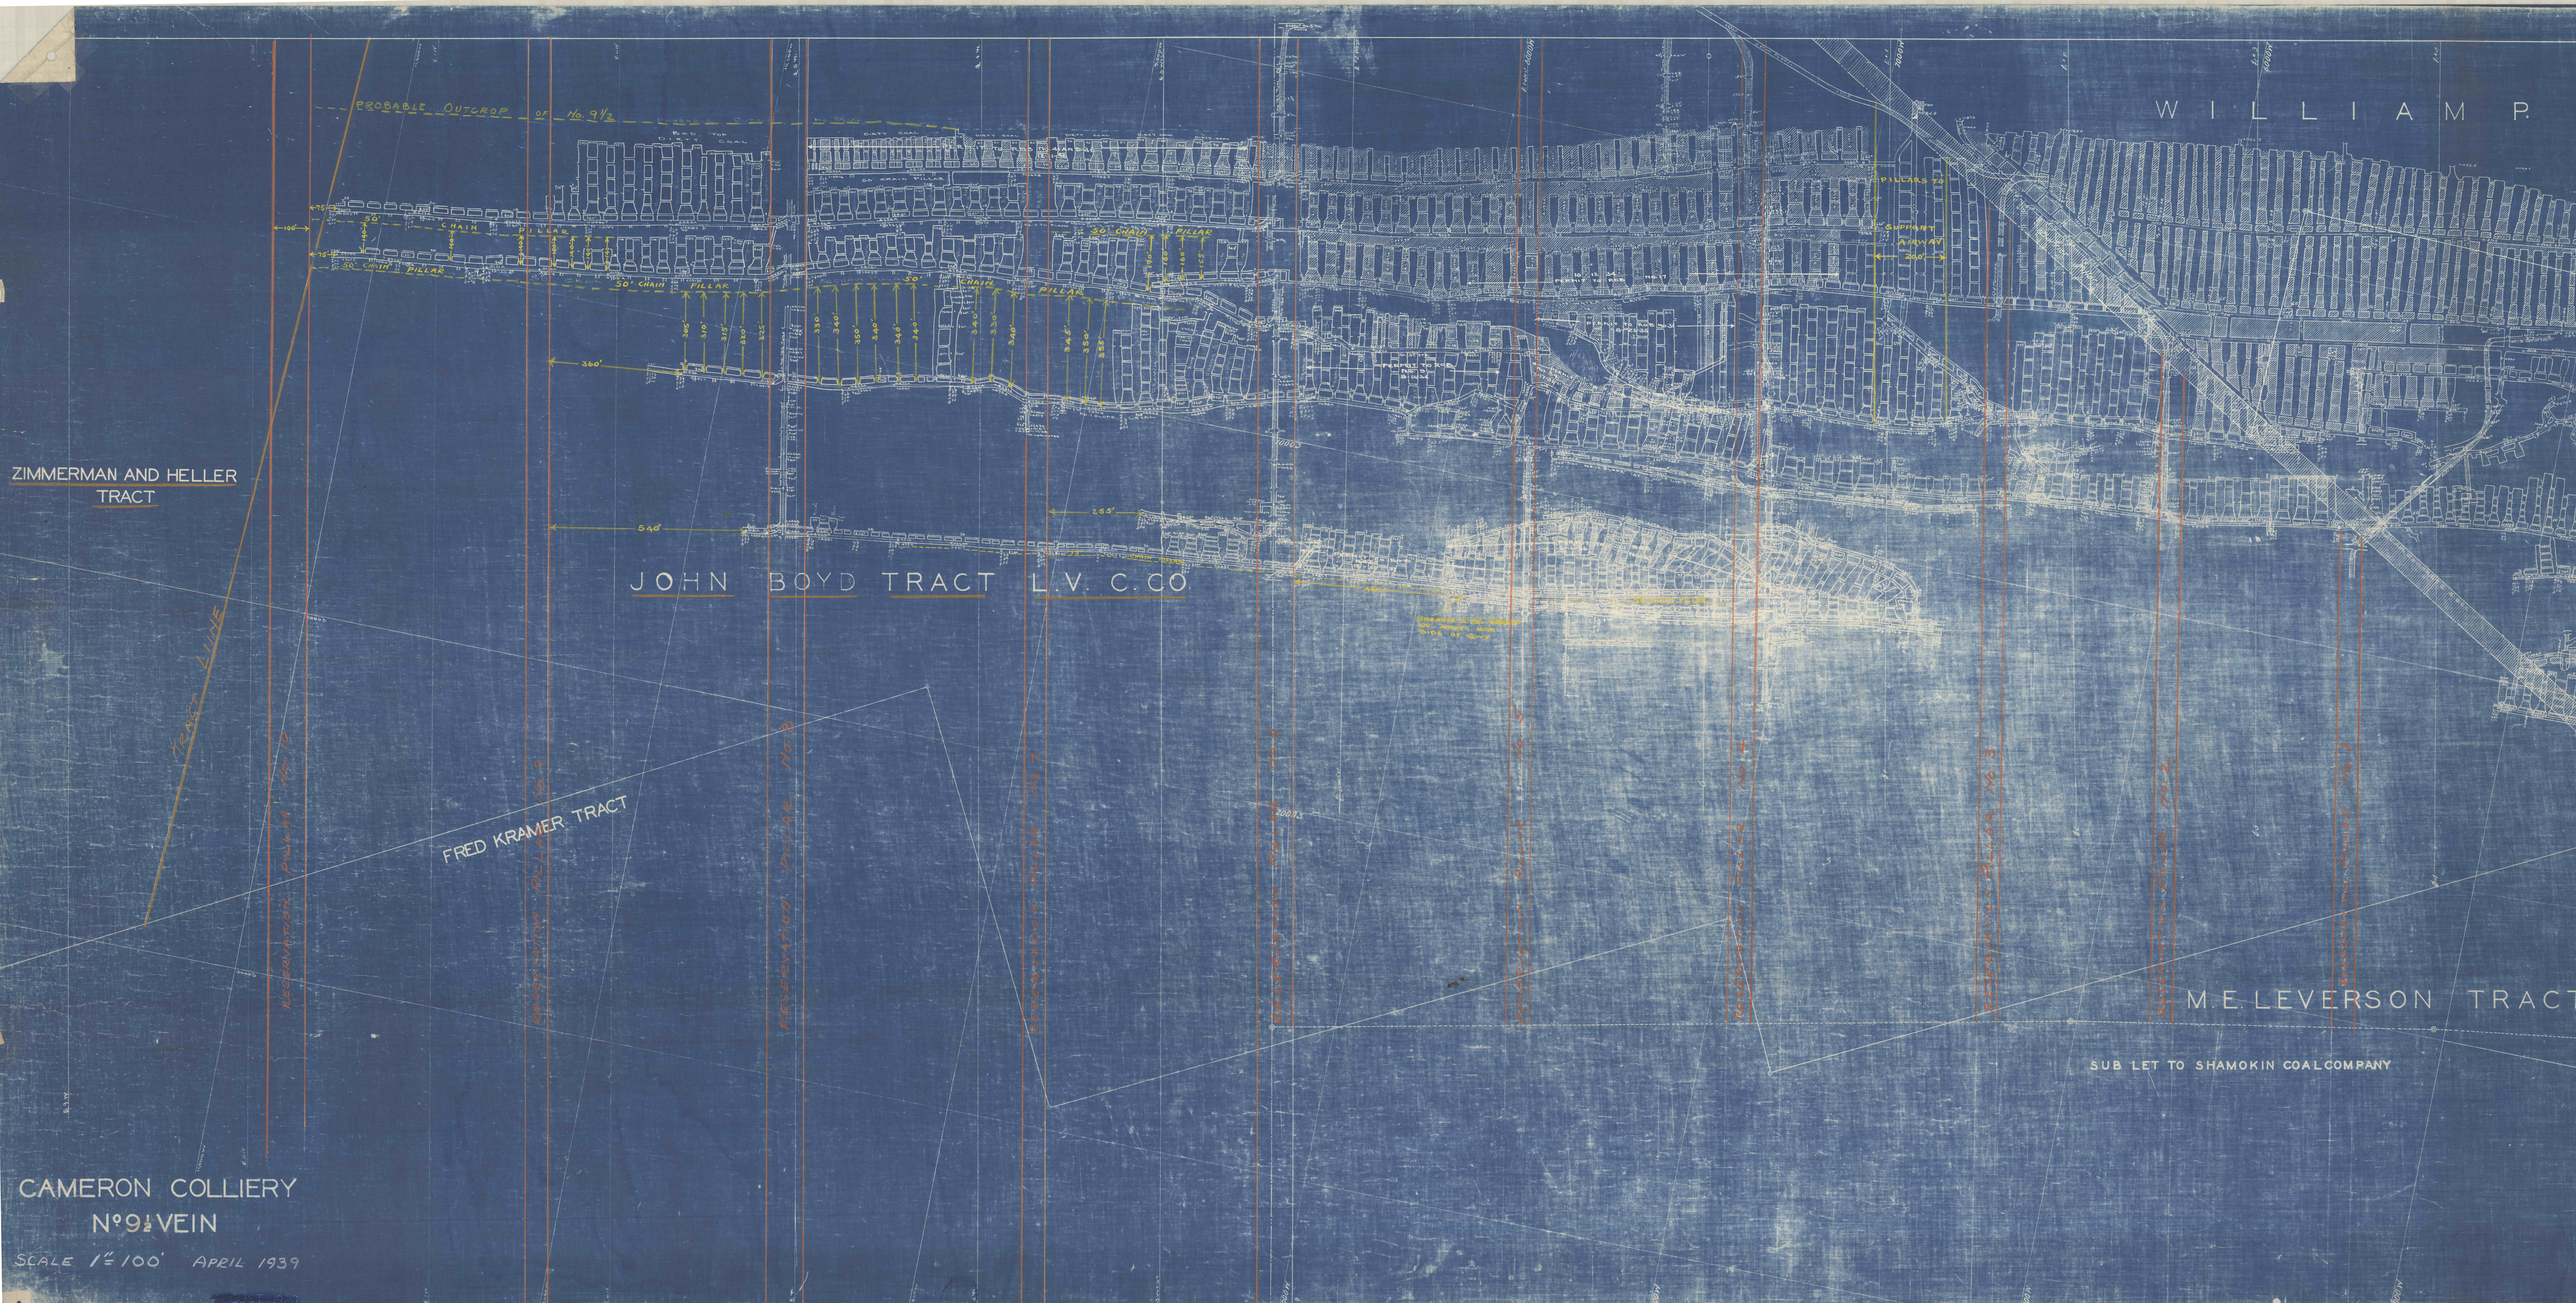

PROBABLE OUTCROP OF No. 9½
WILLIAM P.
ZIMMERMAN AND HELLER TRACT
TRACT LINE
JOHN BOYD TRACT L.V. C.CO
FRED KRAMER TRACT
M.E LEVERSON TRACT
SUB LET TO SHAMOKIN COAL COMPANY
CAMERON COLLIERY
No 9½ VEIN
SCALE 1" = 100' APRIL 1939