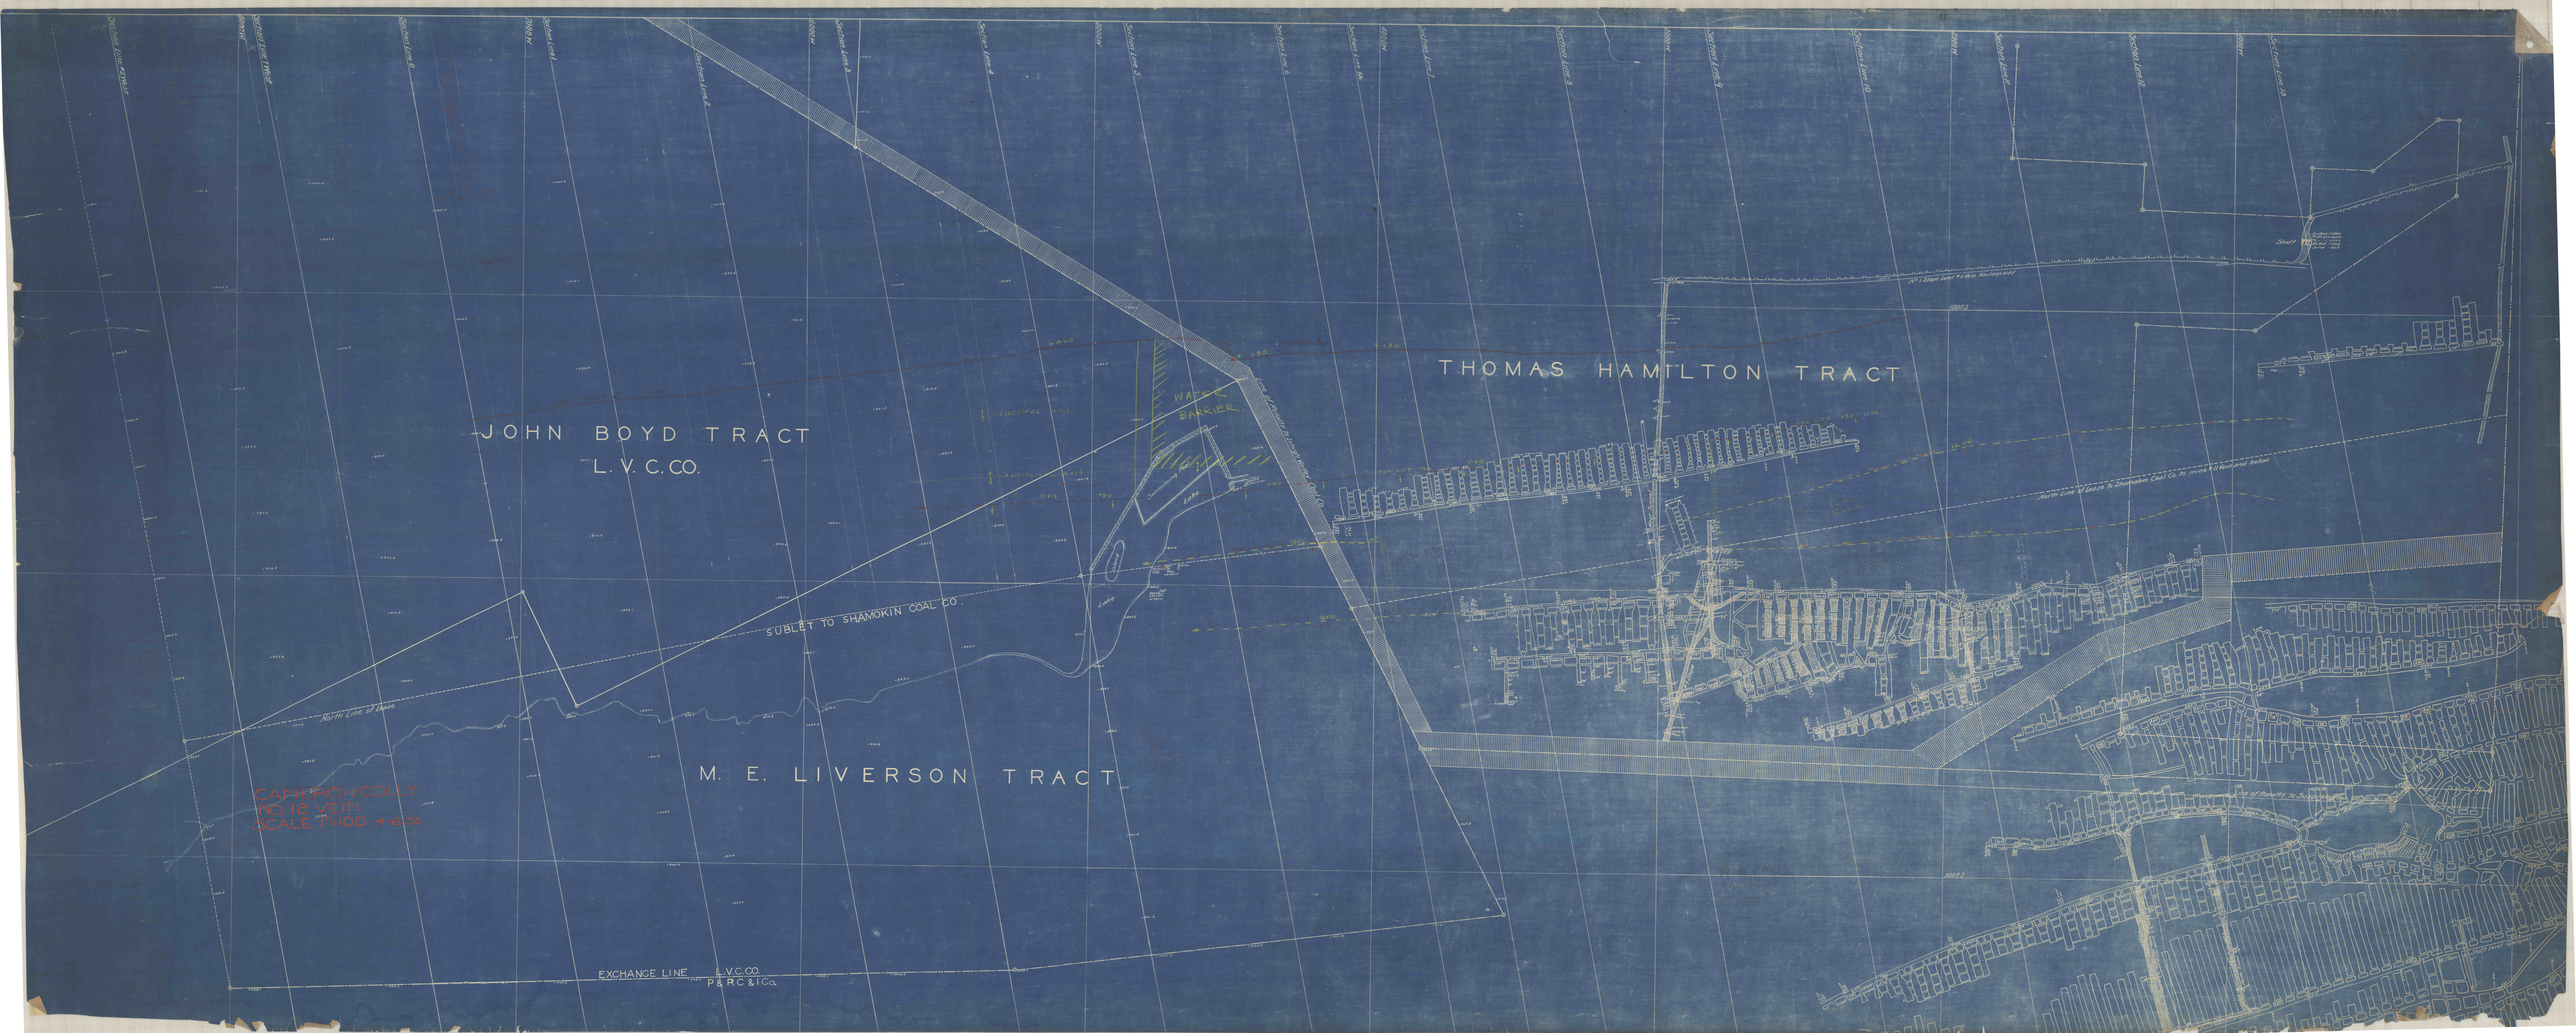
JOHN BOYD TRACT
L.V.C.CO.
THOMAS HAMILTON TRACT
M. E. LIVERSON TRACT
SUBLET TO SHAMOKIN COAL CO.
WATER BARRIER
Lake
North Line of Tract
CAMERON COLLY
NO. 12 VEIN
SCALE 1"=100 ± 6.33
EXCHANGE LINE L.V.C.CO.
P&RC&ICo.