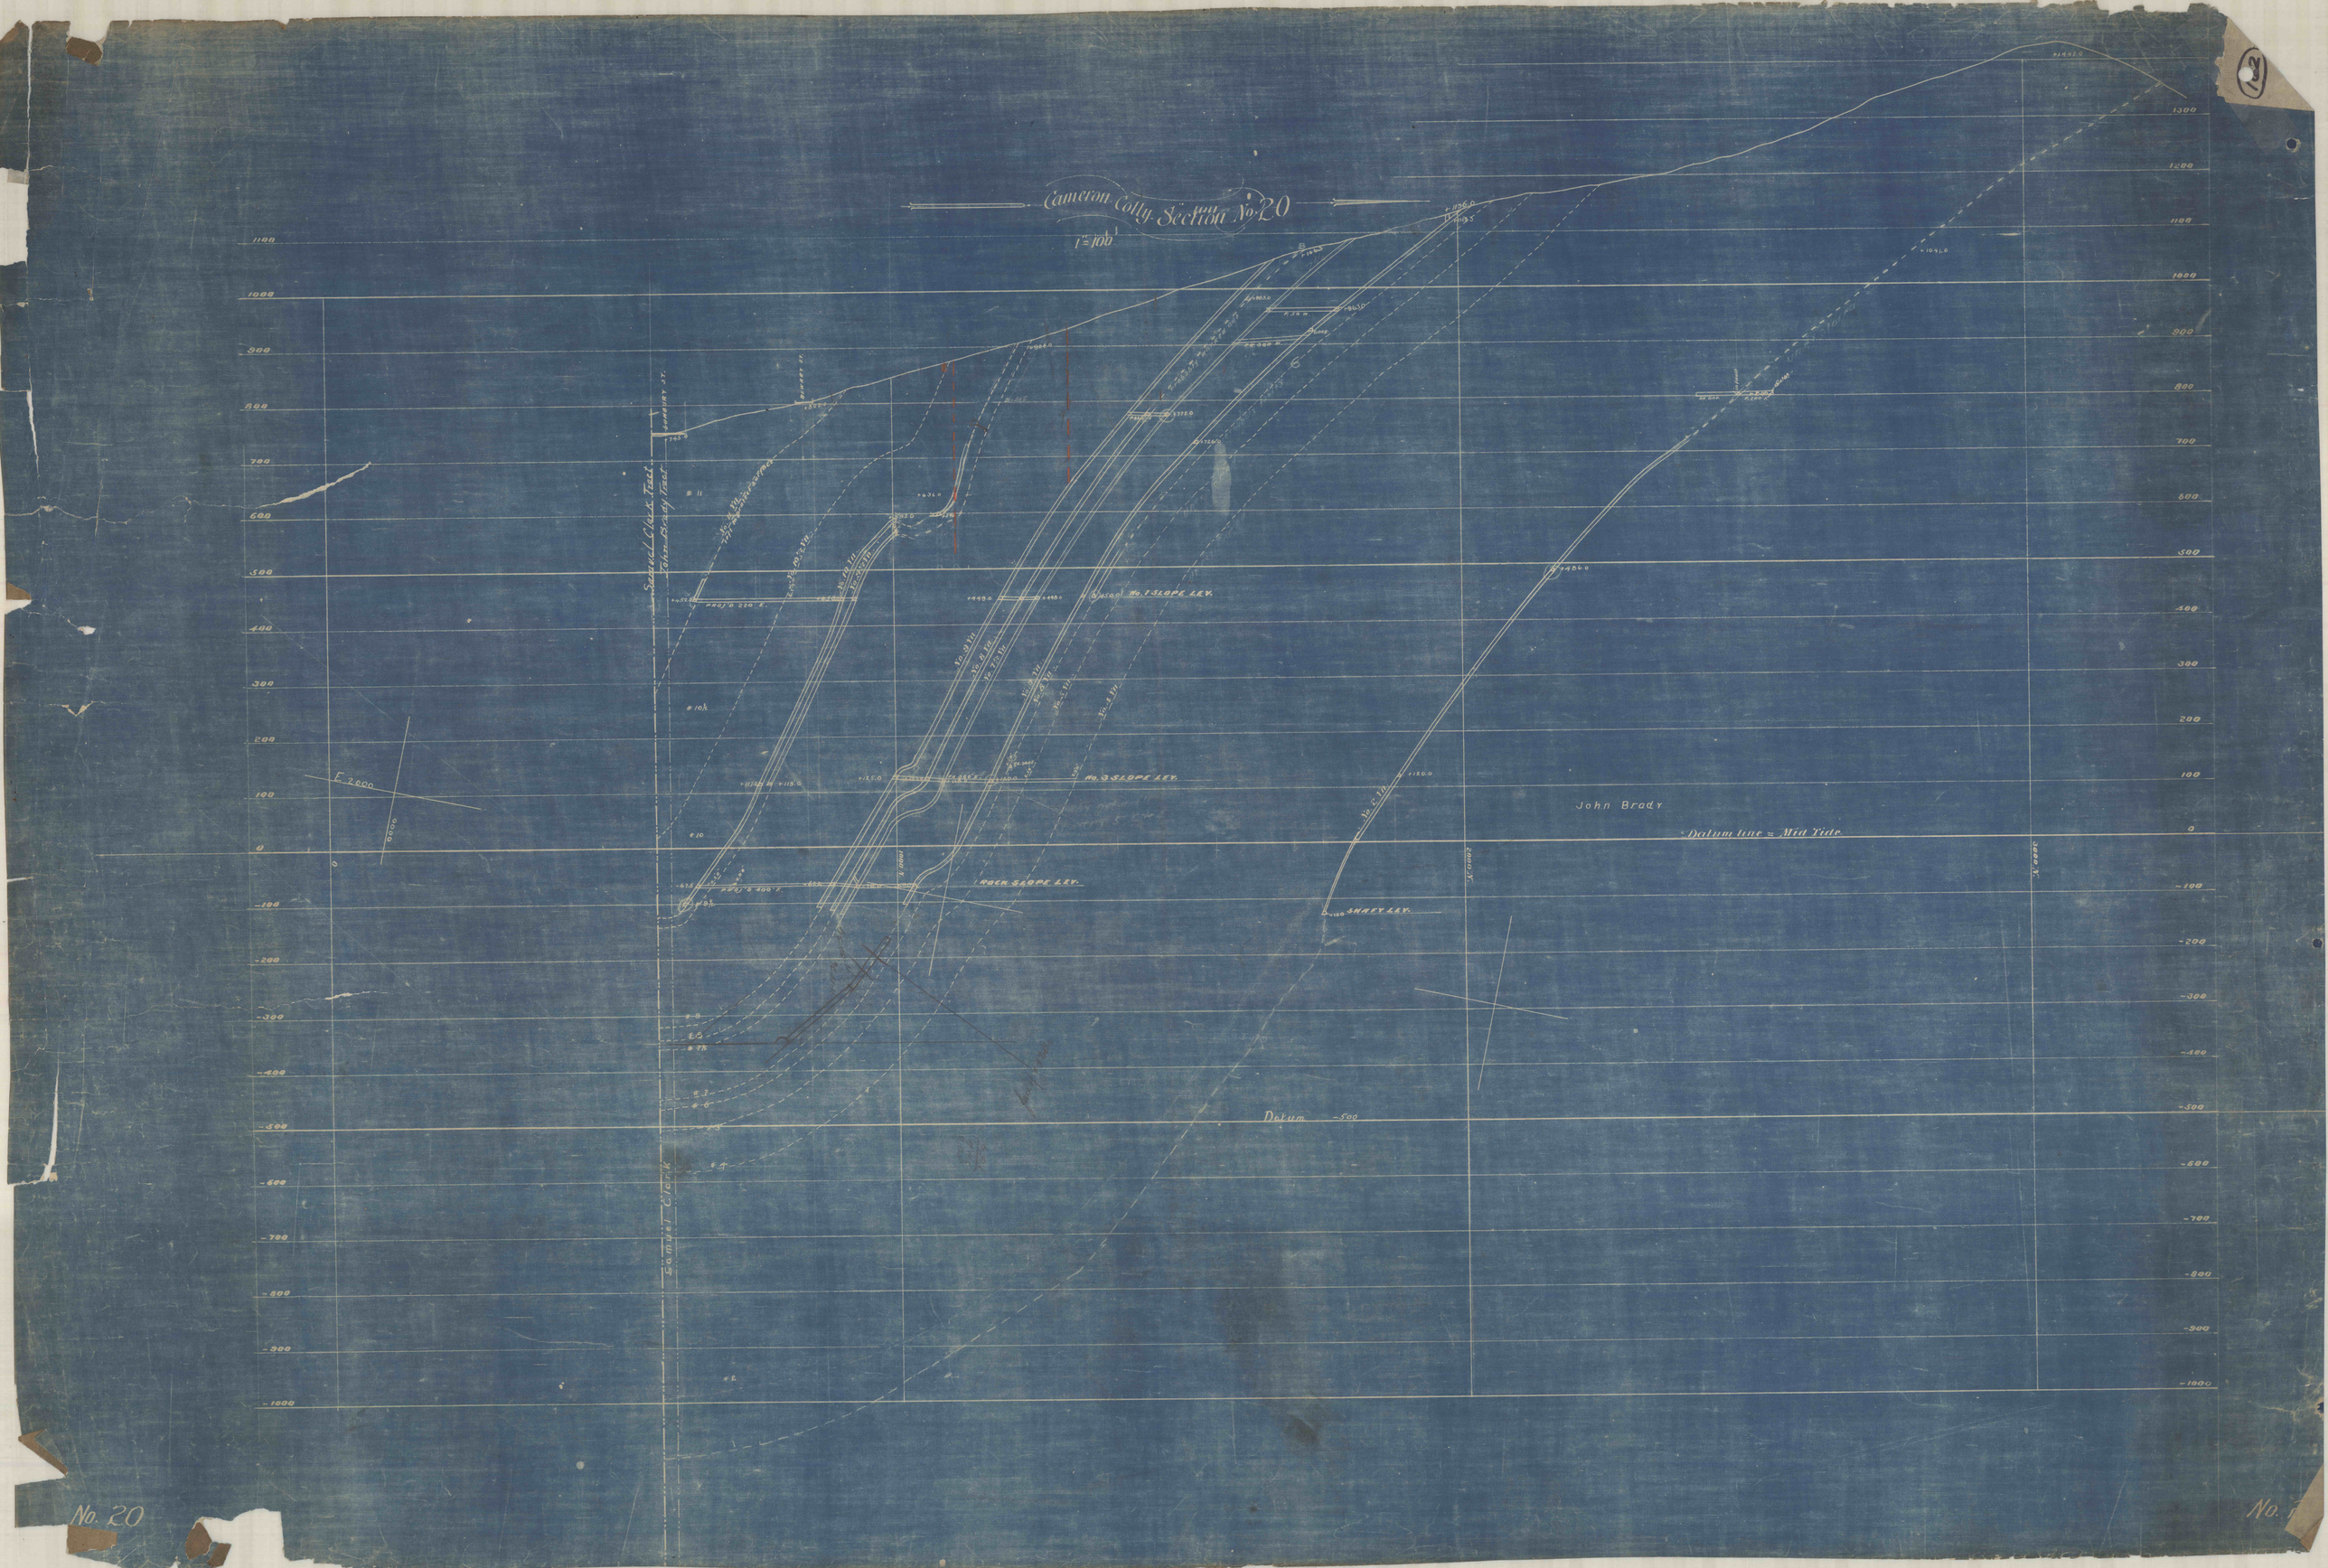
Cameron Colly. Section No. 20
1" = 100'
Samuel Clark Tract
John Brady Tract
Samuel Clark
John Brady
Datum line = Mid Tide
Datum -500
No. 1 SLOPE LEV.
No. 3 SLOPE LEV.
ROCK SLOPE LEV.
SHREY LEV.
E 2000
No. 20