


Cameron Coll. Section No. 20

1" = 100'

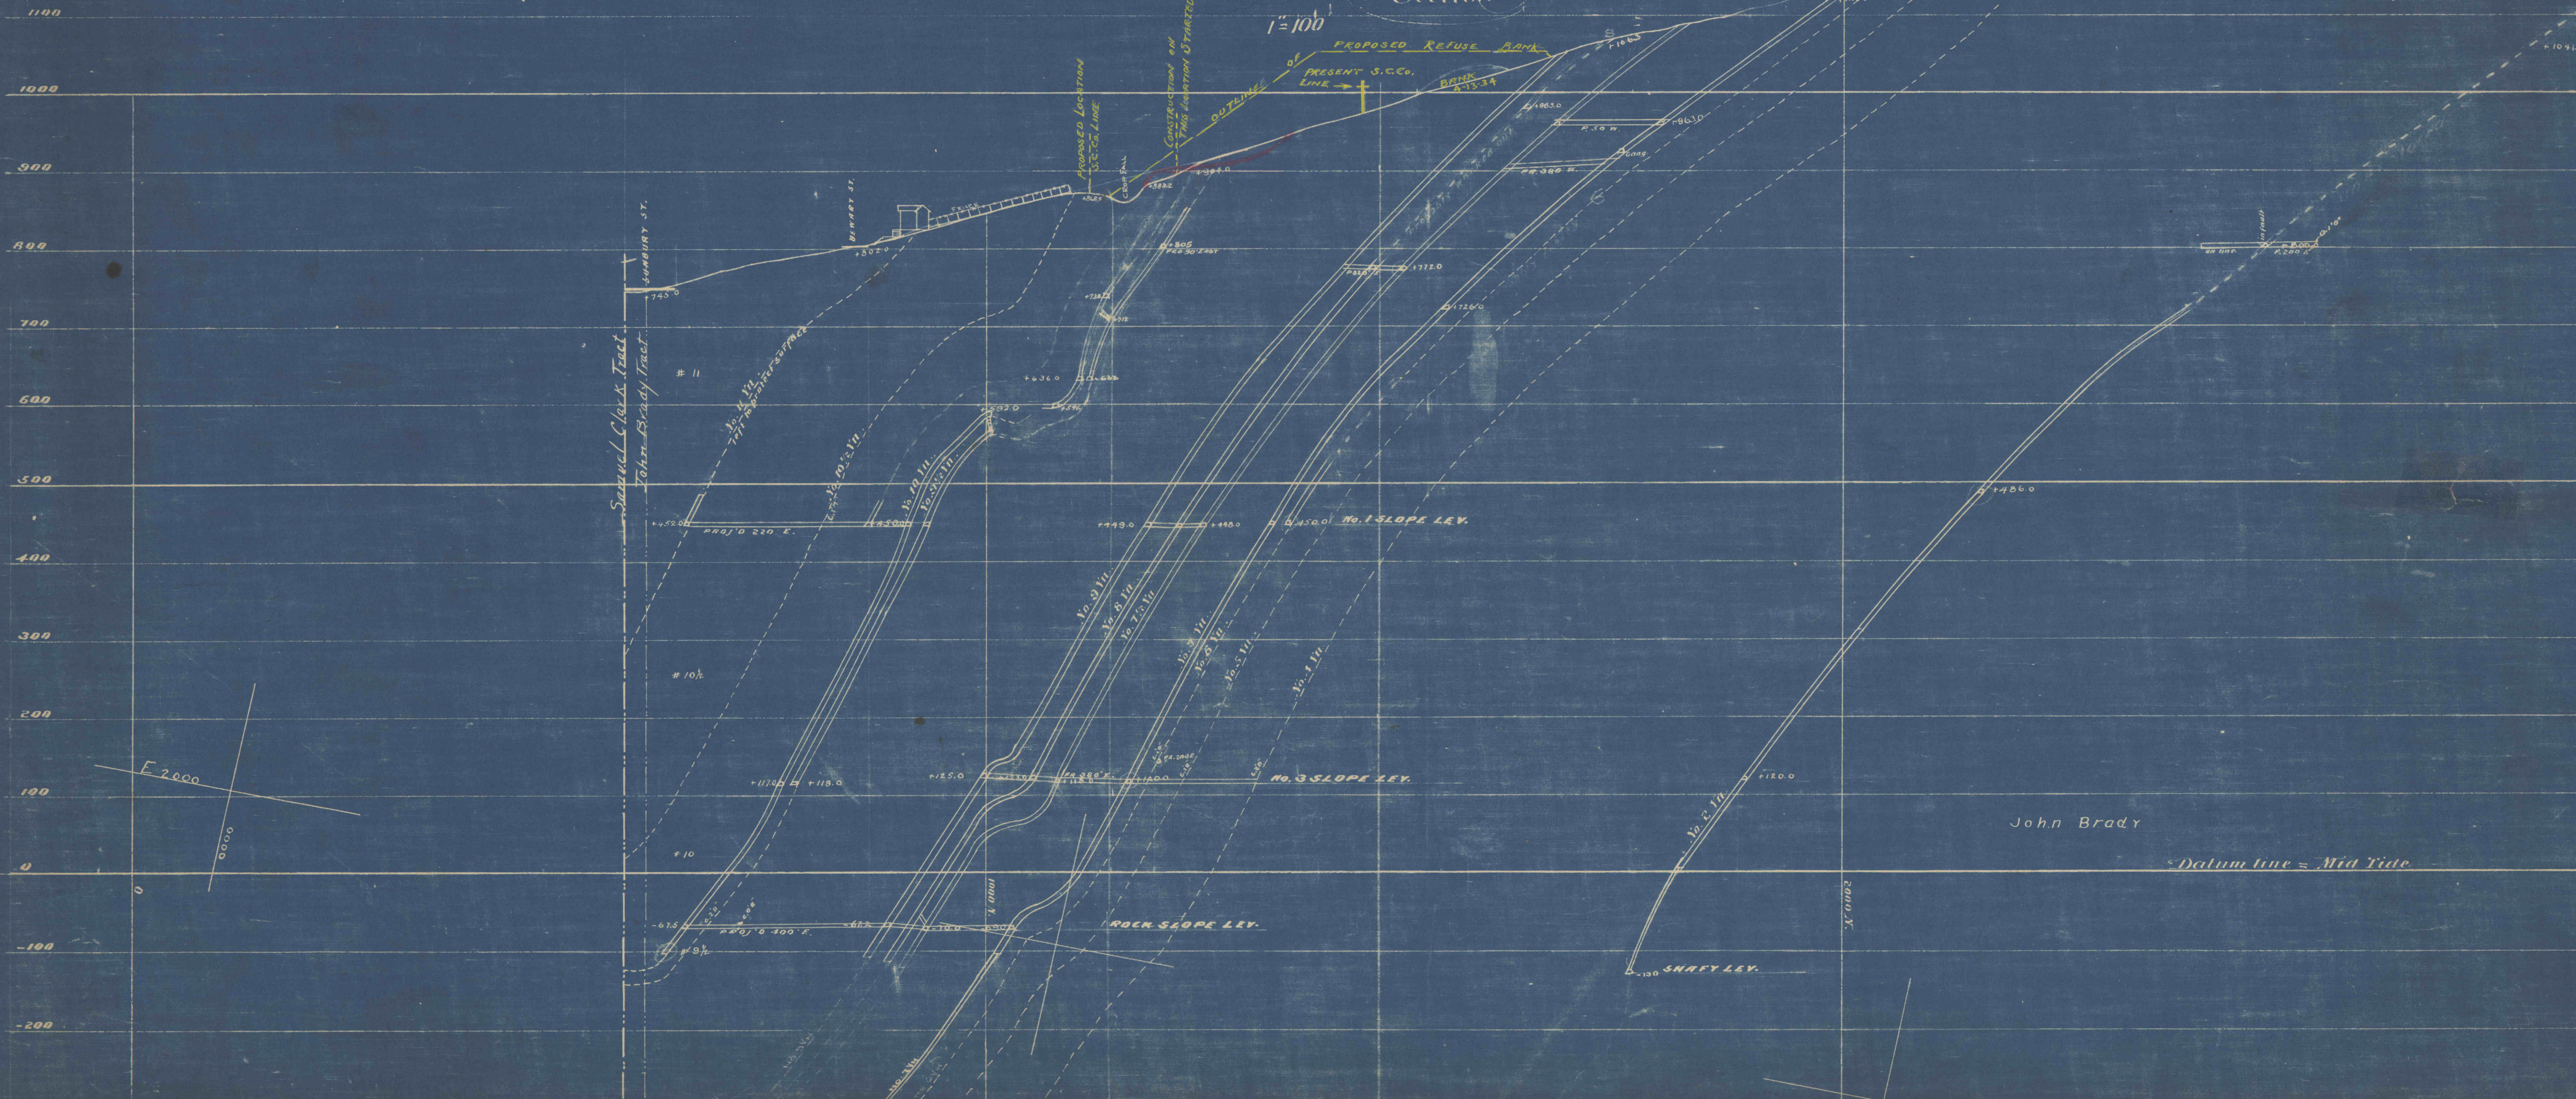

John Brady

Datum line = Mid Tide

E 2000

0000

2000 Y.

3000 Y.