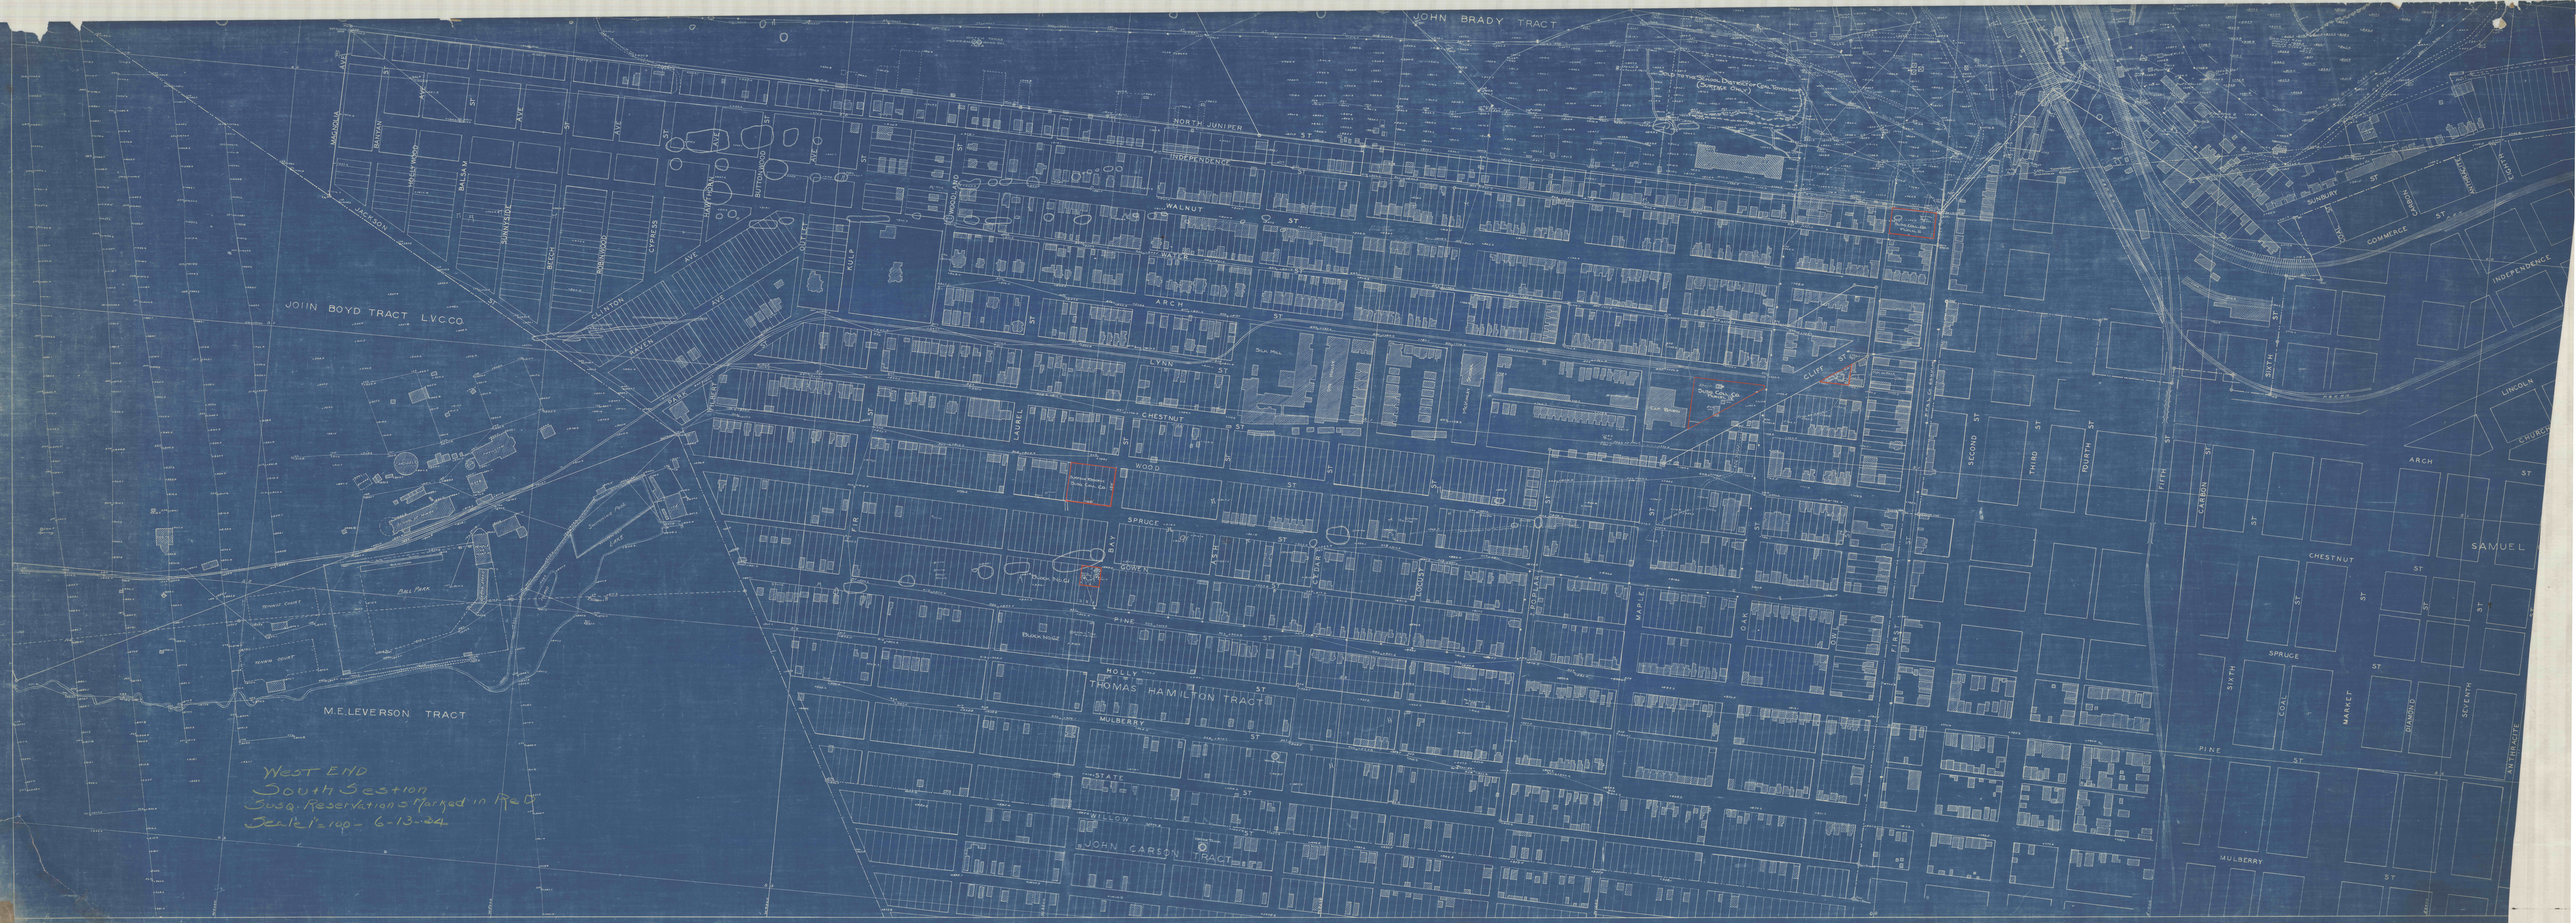

JOHN BRADY TRACT
NORTH JUNIPER ST
INDEPENDENCE
WALNUT ST
WATER
ARCH
LYNN ST
CHESTNUT ST
WOOD ST
SPRUCE ST
GOWER
PINE ST
HOLLY
THOMAS HAMILTON TRACT
MULBERRY
STATE ST
WILLOW
JOHN CARSON TRACT
JOHN BOYD TRACT L.V.C.CO.
M.E.LEVERSON TRACT
JACKSON
MAGNOLIA AVE
BANYAN
DOGWOOD AVE
BALSAM ST
SUNNYSIDE
BEECH
DOGWOOD
CYPRESS
CLINTON
RAVEN AVE
AVE
ST
BUTTONWOOD
KULP
OUTLET
PARK
LAUREL
FIR
BAY
ASH
CEDAR
LOCUST
POPLAR
MAPLE
OAK
CLIFF ST
FIRST
SECOND
THIRD ST
FOURTH ST
FIFTH ST
SIXTH ST
SEVENTH
CARBON ST
COAL ST
MARKET ST
DIAMOND
ANTHRACITE
CHESTNUT ST
SPRUCE
PINE ST
MULBERRY ST
ARCH
CHURCH
LINCOLN
INDEPENDENCE
COMMERCE
SUNBURY
SAMUEL
BALL PARK
TENNIS COURT

West END
South Section
Susq. Reservations Marked in ReD
Scale 1" = 100 - 6-13-24