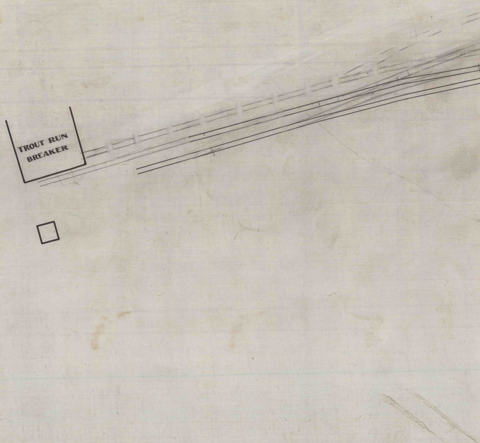
TROUT RUN
BREAKER

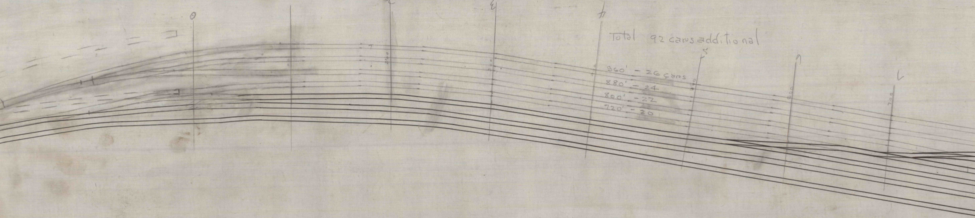

Total 92 cars additional

960' - 26 cars
880' - 24
800' - 22
720' - 20

42 cars
28,244 cu. yds @ 18¢ - $5083.92

92 cars
79,120 cu. yds @ 15¢ - $11,868.00

Nº1 Track -
Nº2 " Sto
Nº3 " Ope
Nº4 " Sto
Nº5 "
Nº6 "
Nº7 "

TOTAL
Gap Sidi

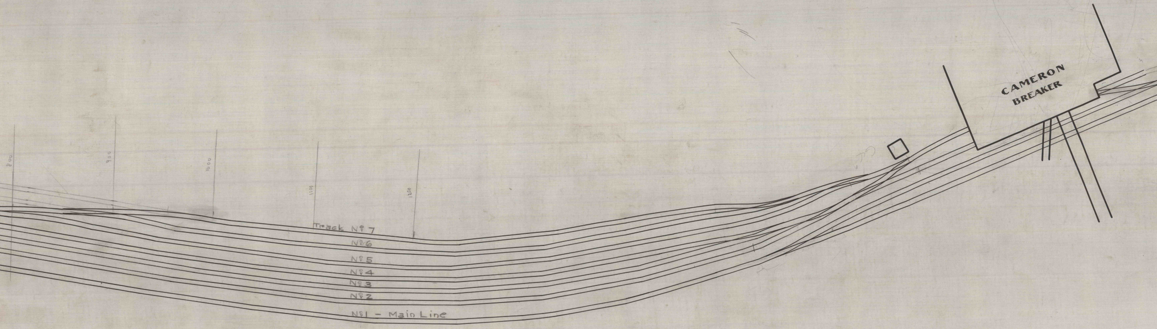
800
900
1000
1100
1200
CAMERON
BREAKER
Track No 7
No 6
No 5
No 4
No 3
No 2
No 1 - Main Line

Main Line
rage - 39 cars.
rating - 60
rage - 23
- 22
- 16
- 16 "

- 176 "
ng 27 "
200 Cars

Scale 1" = 40'