


$\frac{11}{16}$ " Holes unless Marked.

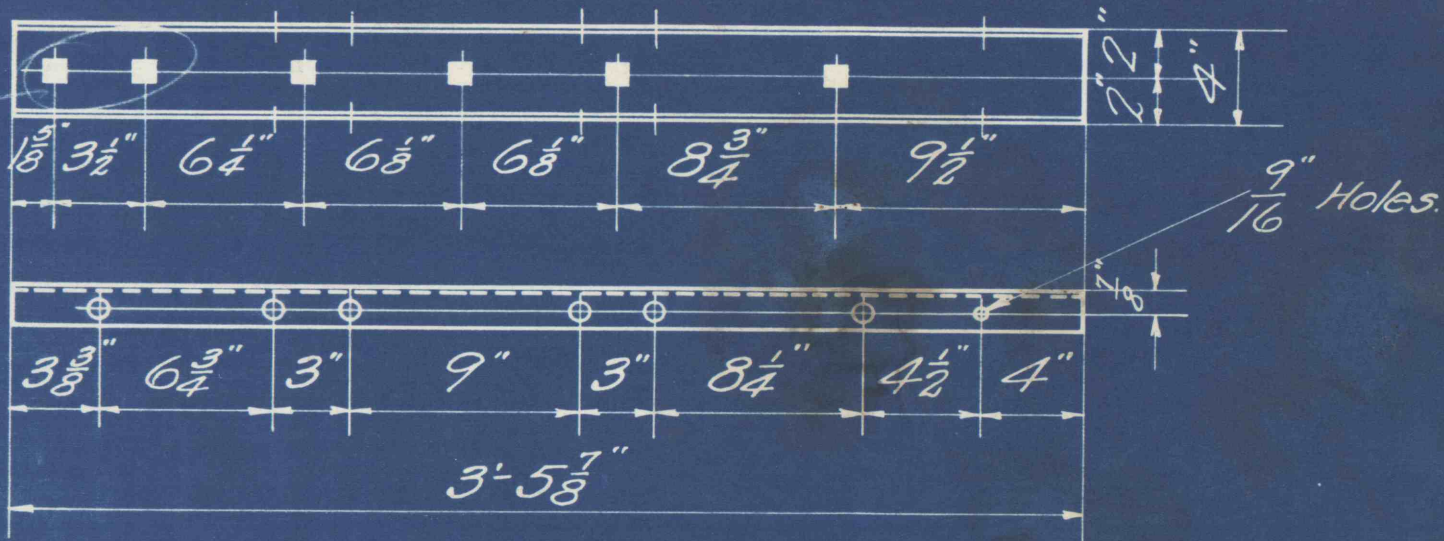

4" - 7.25[#] Channel.
2 - Required.

offset three
holes $\frac{3}{8}$ " - see side sheet
on Dwg 623-430

[illegible]

1926.

Back End Stake for West
Drift Mine Car.
Cameron Colliery.

MECHANICAL ENGINEERING DEPARTMENT

**SUSQUEHANNA COLLIERIES COMPANY
LYTLE COAL COMPANY**

Sharnotrin PA 4-281926, SCALE $1\frac{1}{2}" = 1\text{FOOT}$

DRAWN BY _____ DR. NO. 863.
CHECKED BY _____