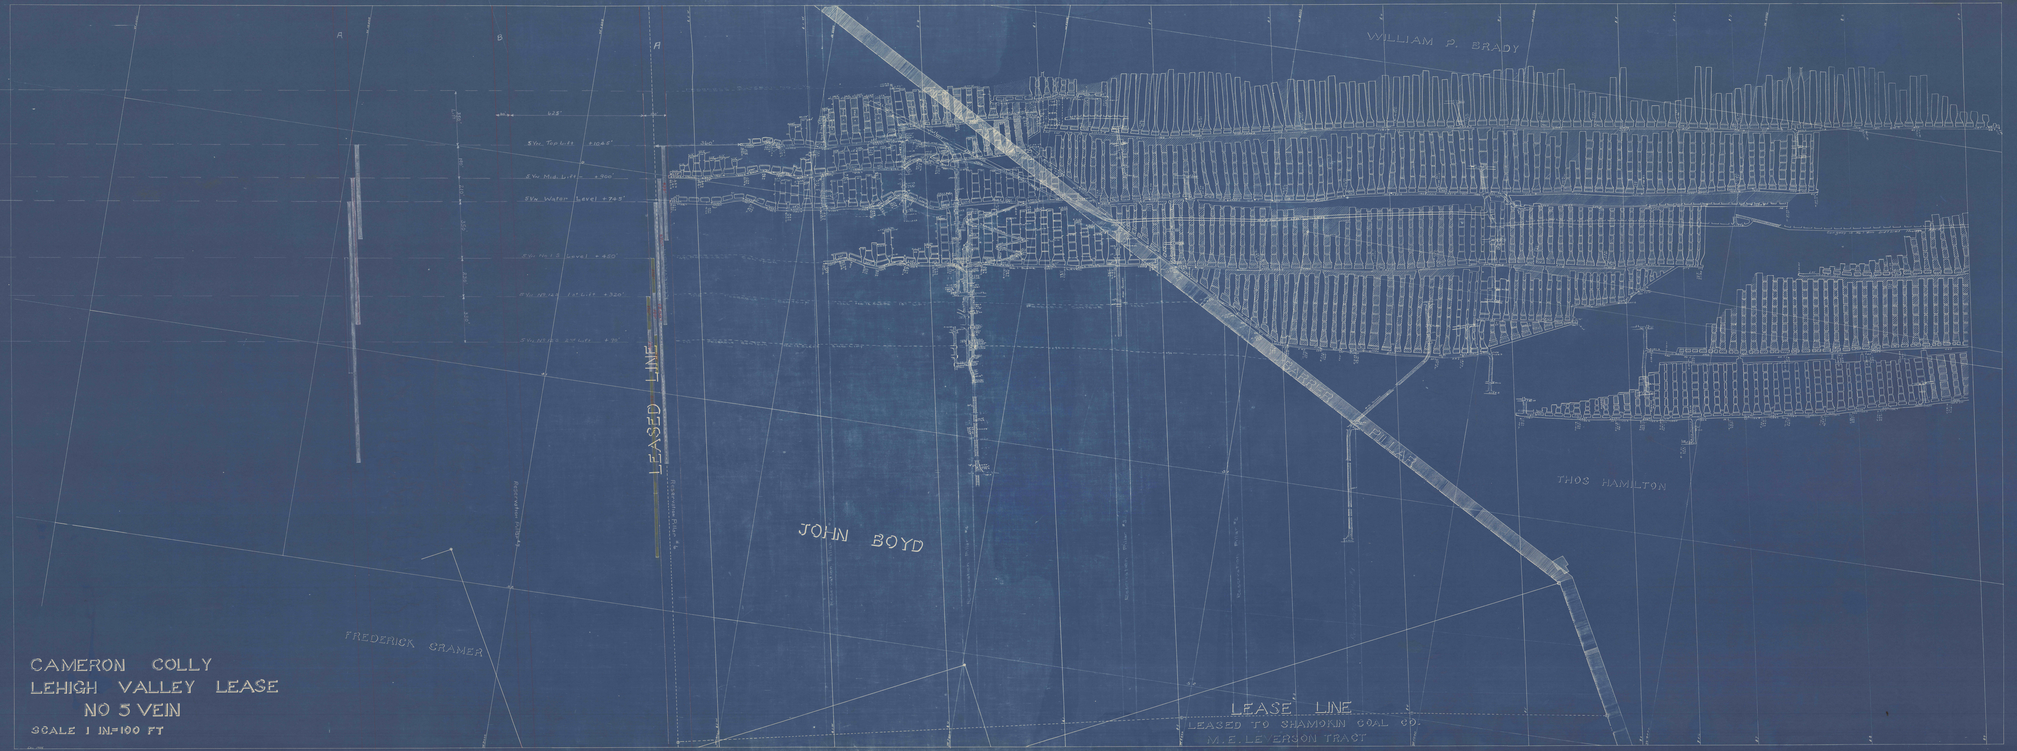

WILLIAM P. BRADY
LEASED LINE
JOHN BOYD
THOS HAMILTON
FREDERICK CRAMER
CAMERON COLLY
LEHIGH VALLEY LEASE
NO 5 VEIN
SCALE 1 IN=100 FT
LEASE LINE
LEASED TO SHAMOKIN COAL CO.
M.E. LEVERSON TRACT