
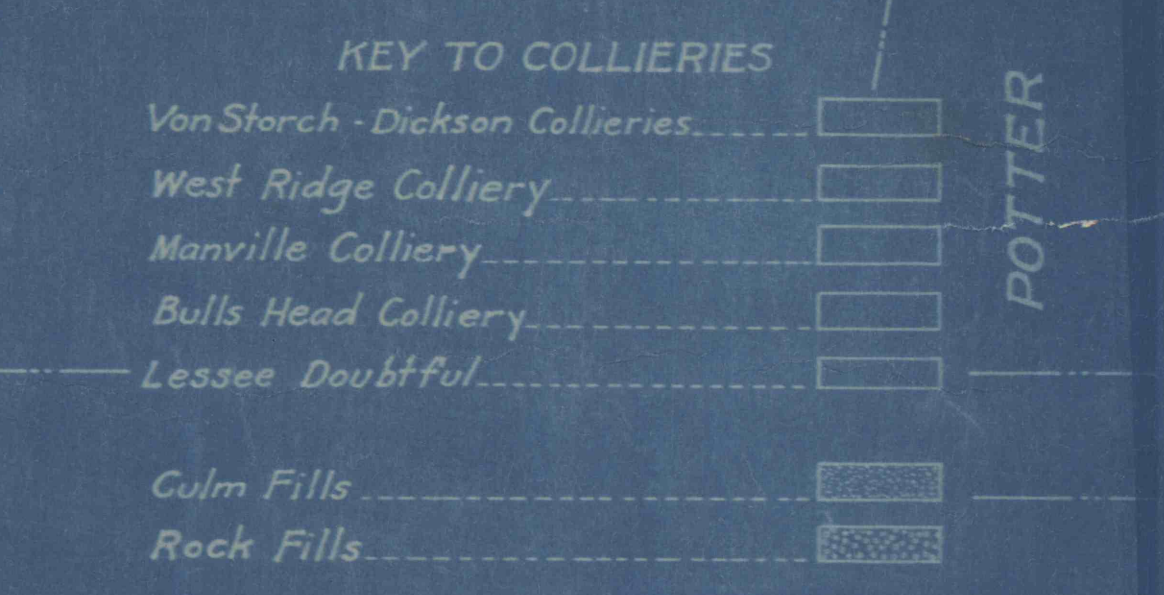
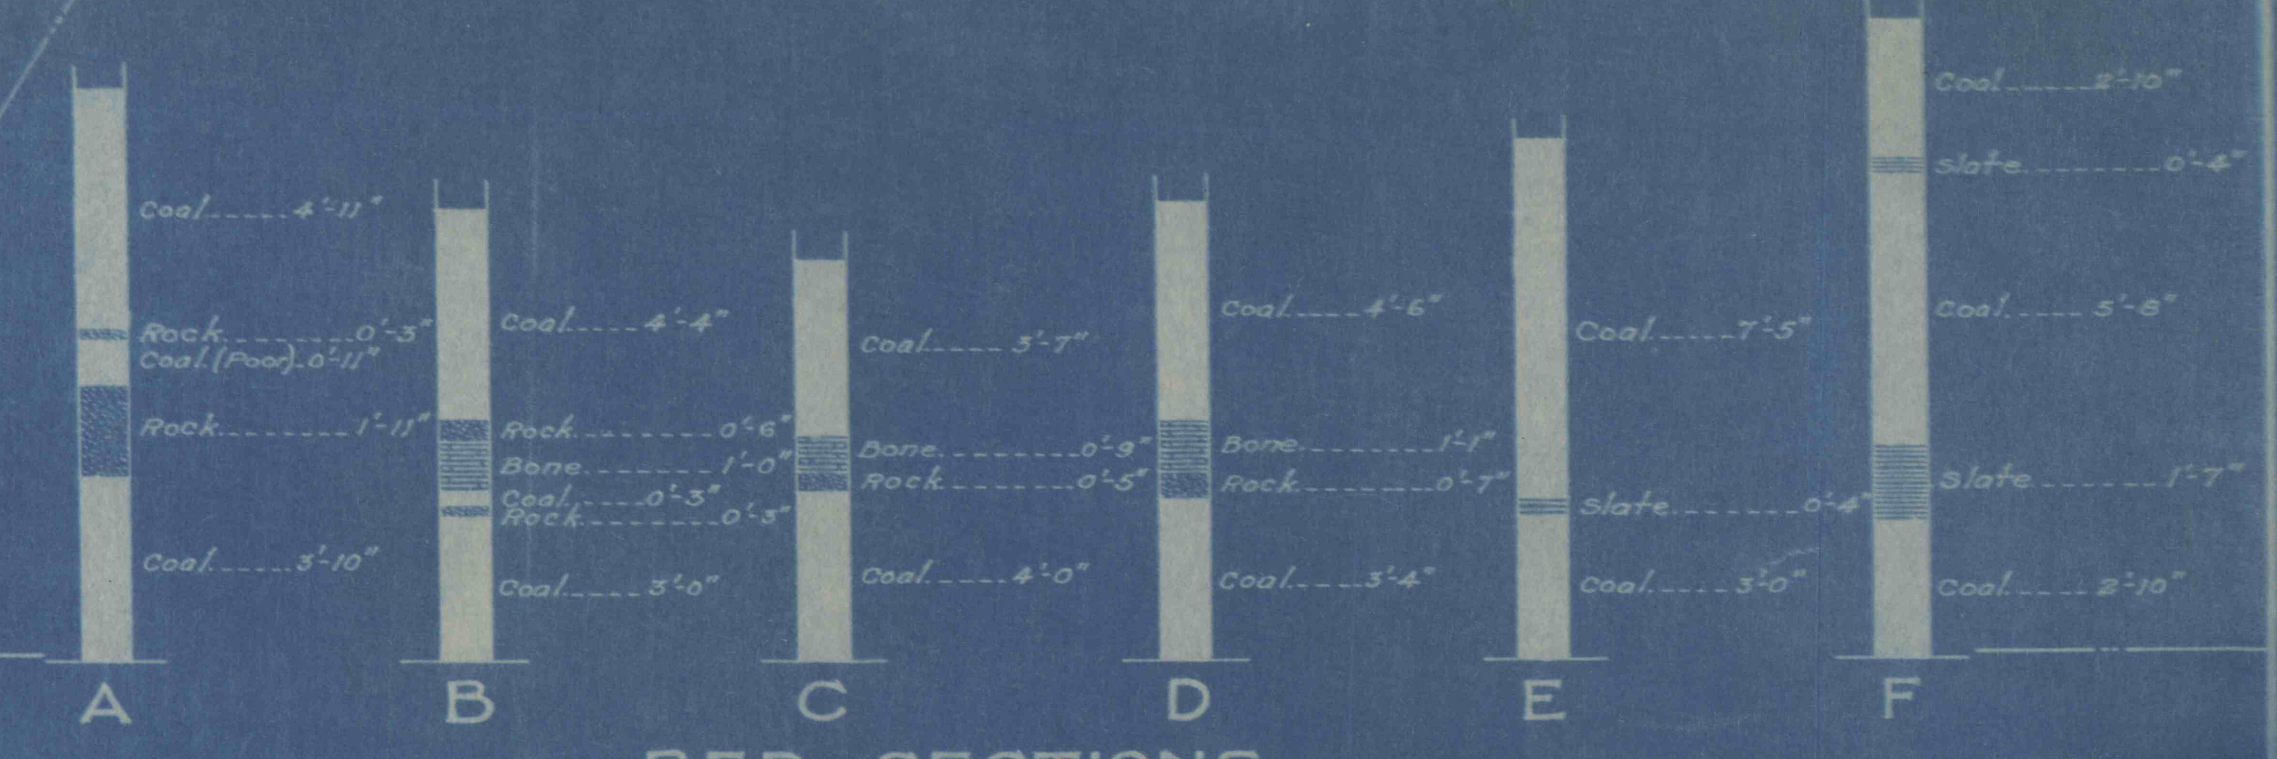


 

THE HUDSON COAL CO.  
VON-STORCH-DICKSON COLLIERIES  
And Adjoining Operations  
Workings In  
14-FT-BED  
Scale 1"=400'