


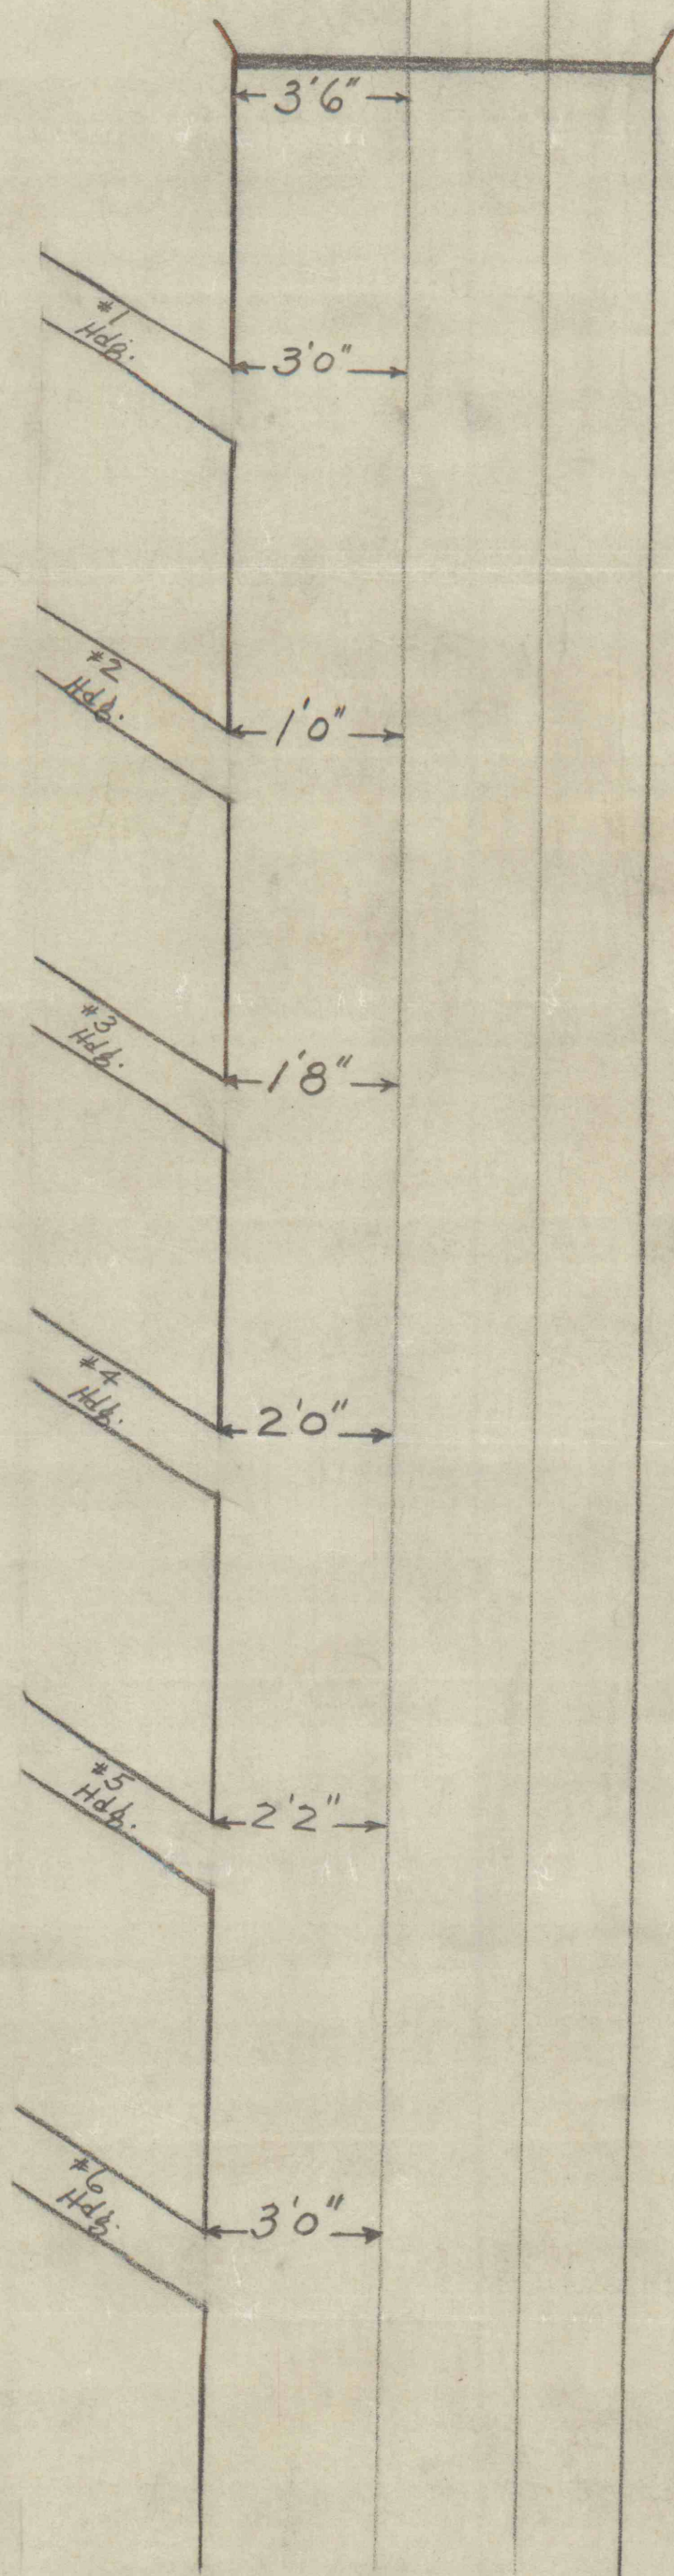

No. 3 UNIT SLOPE

Distances along West Rib of Slope at High
Side of Headings East to West Rail of Track.