


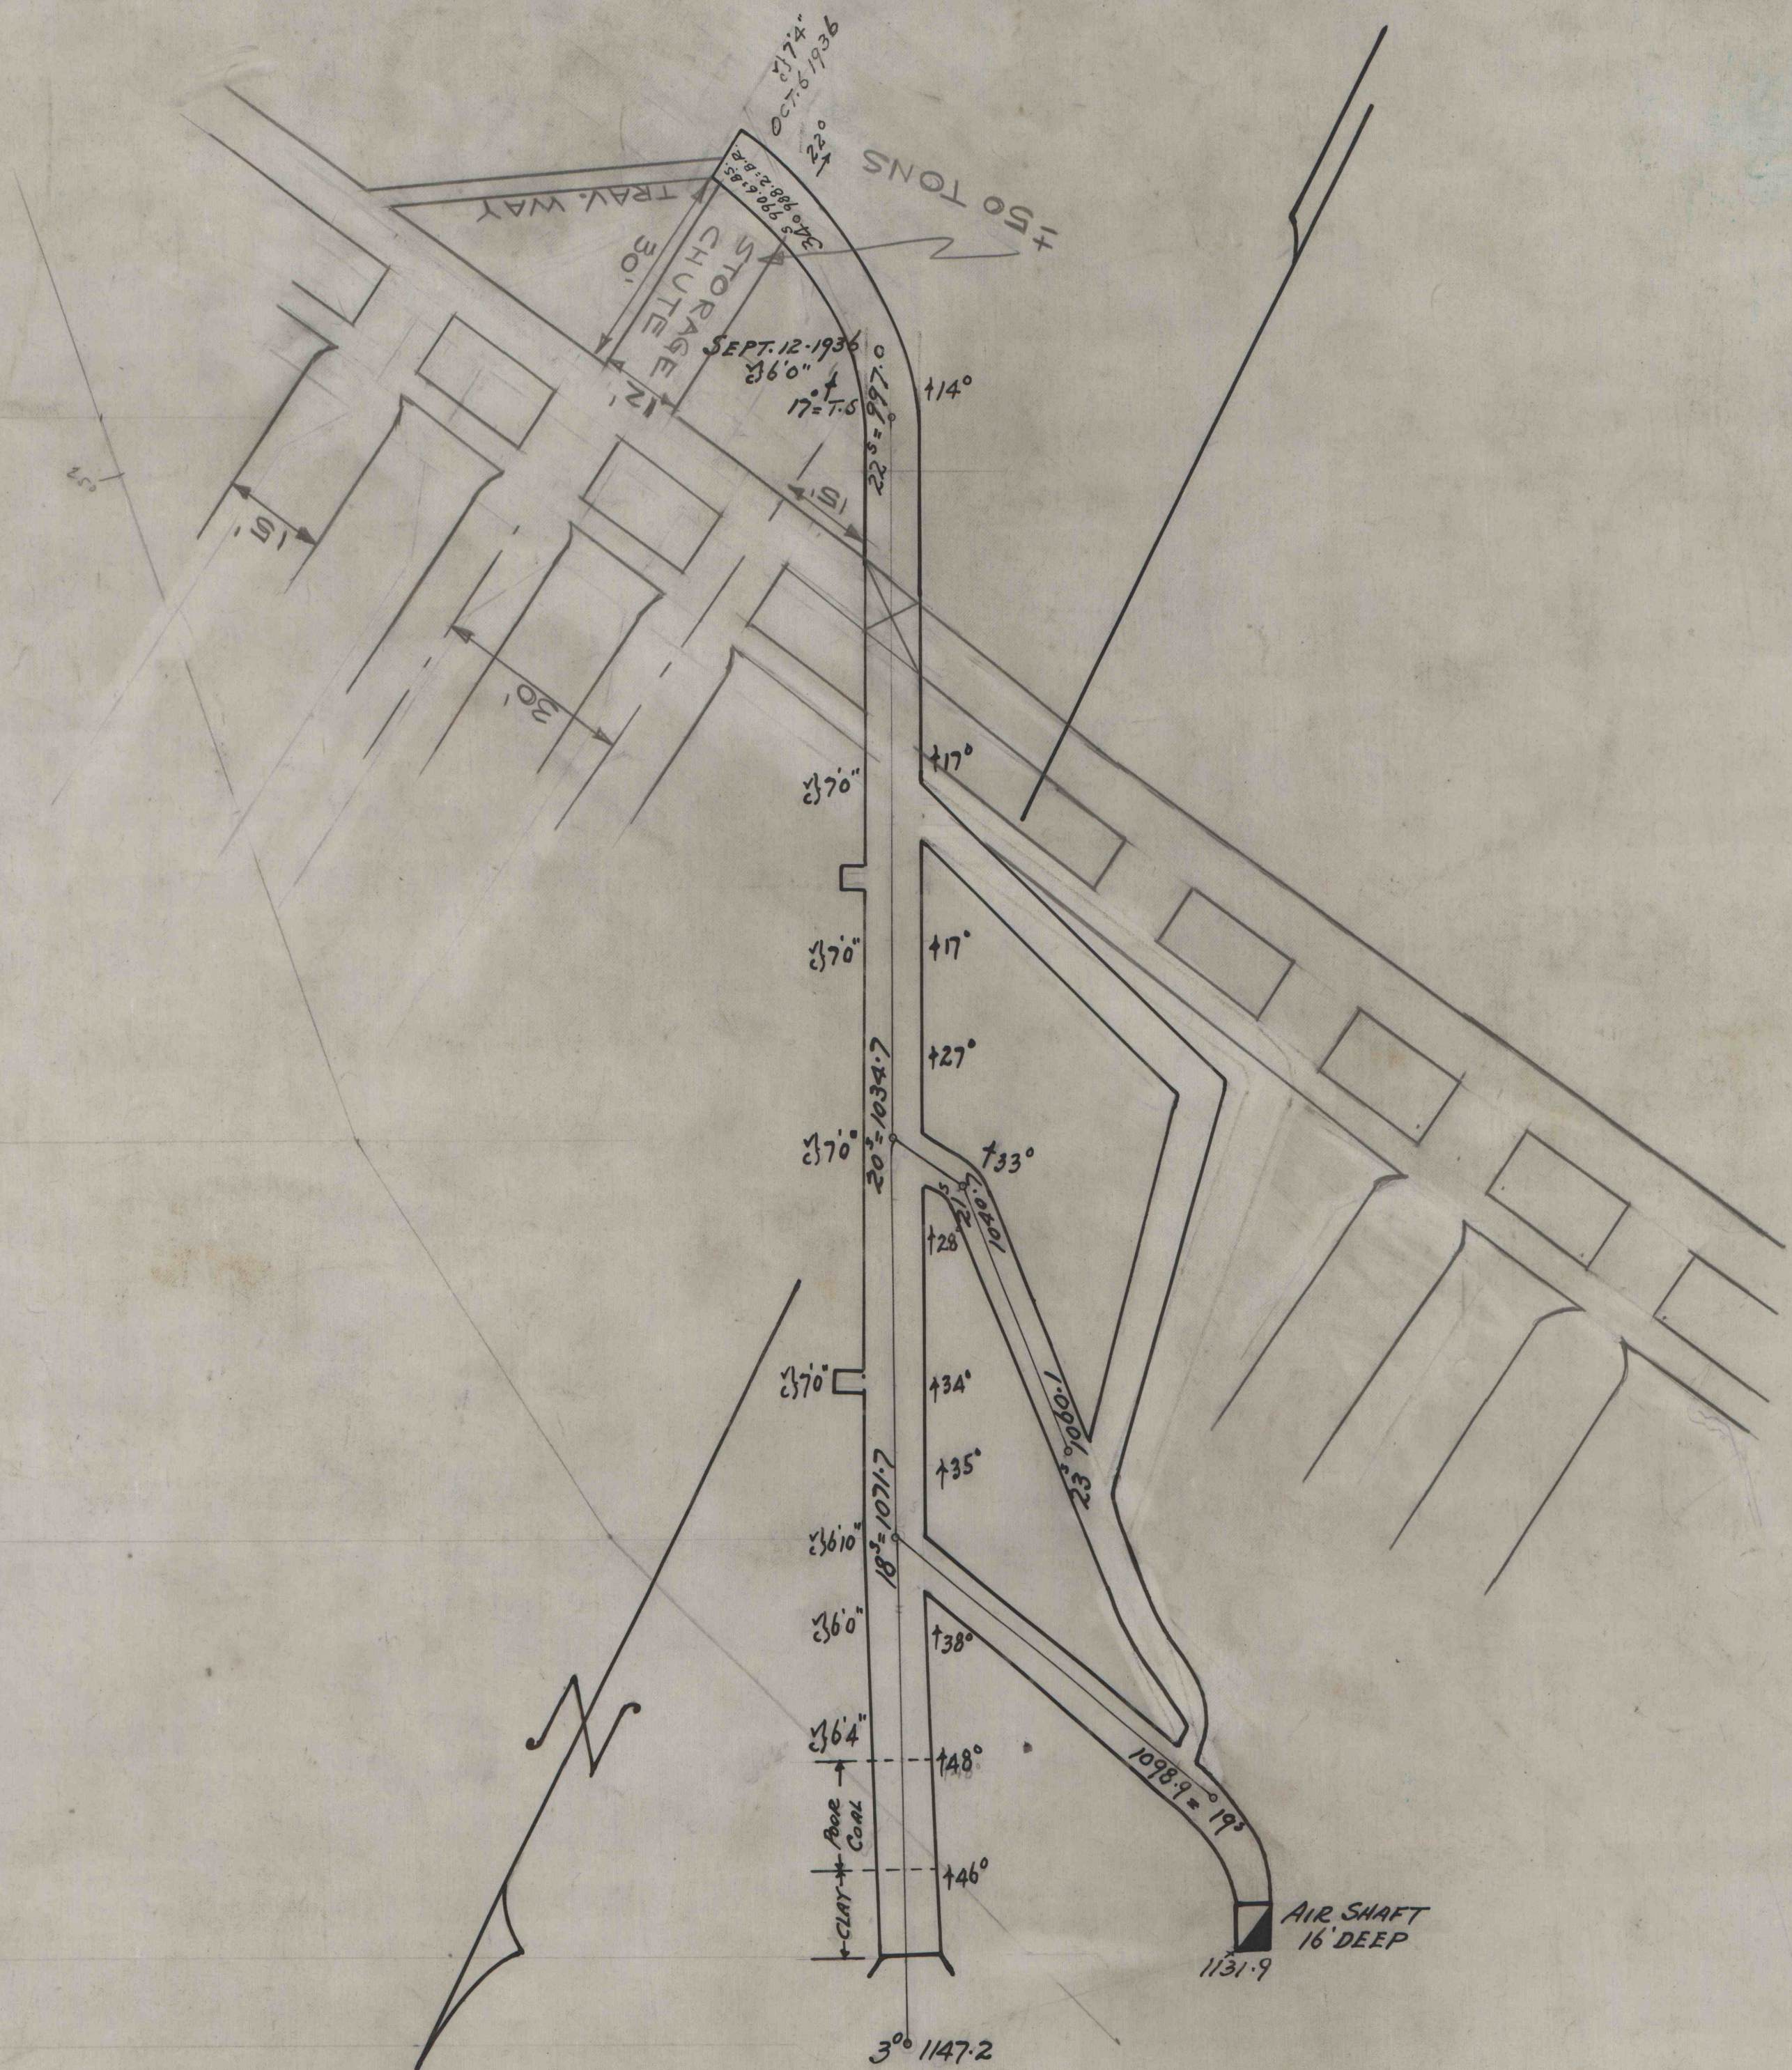

CAMERON COLLIERY

MAP SHOWING SLOPE IN NO. 11 VEIN, SOUTH
DIP, WEST OF EDGEWOOD PARK

SCALE 20' = 1"