
#4 Unit

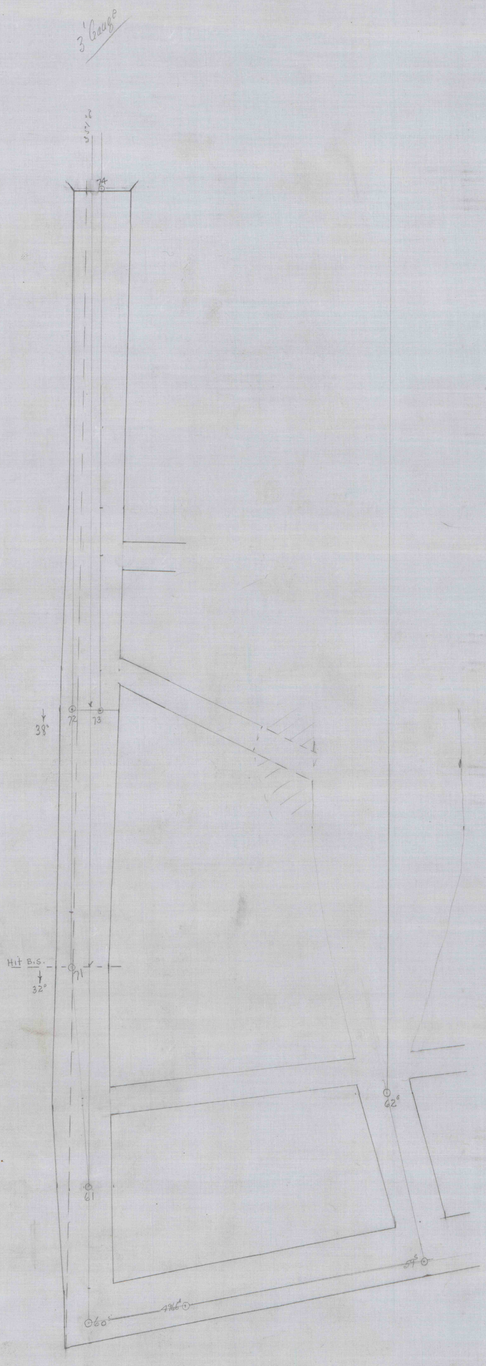

CAMERON COLLIERY

No 4 Unit Slope

No. 11 Vein

Scale 10' = 1"